

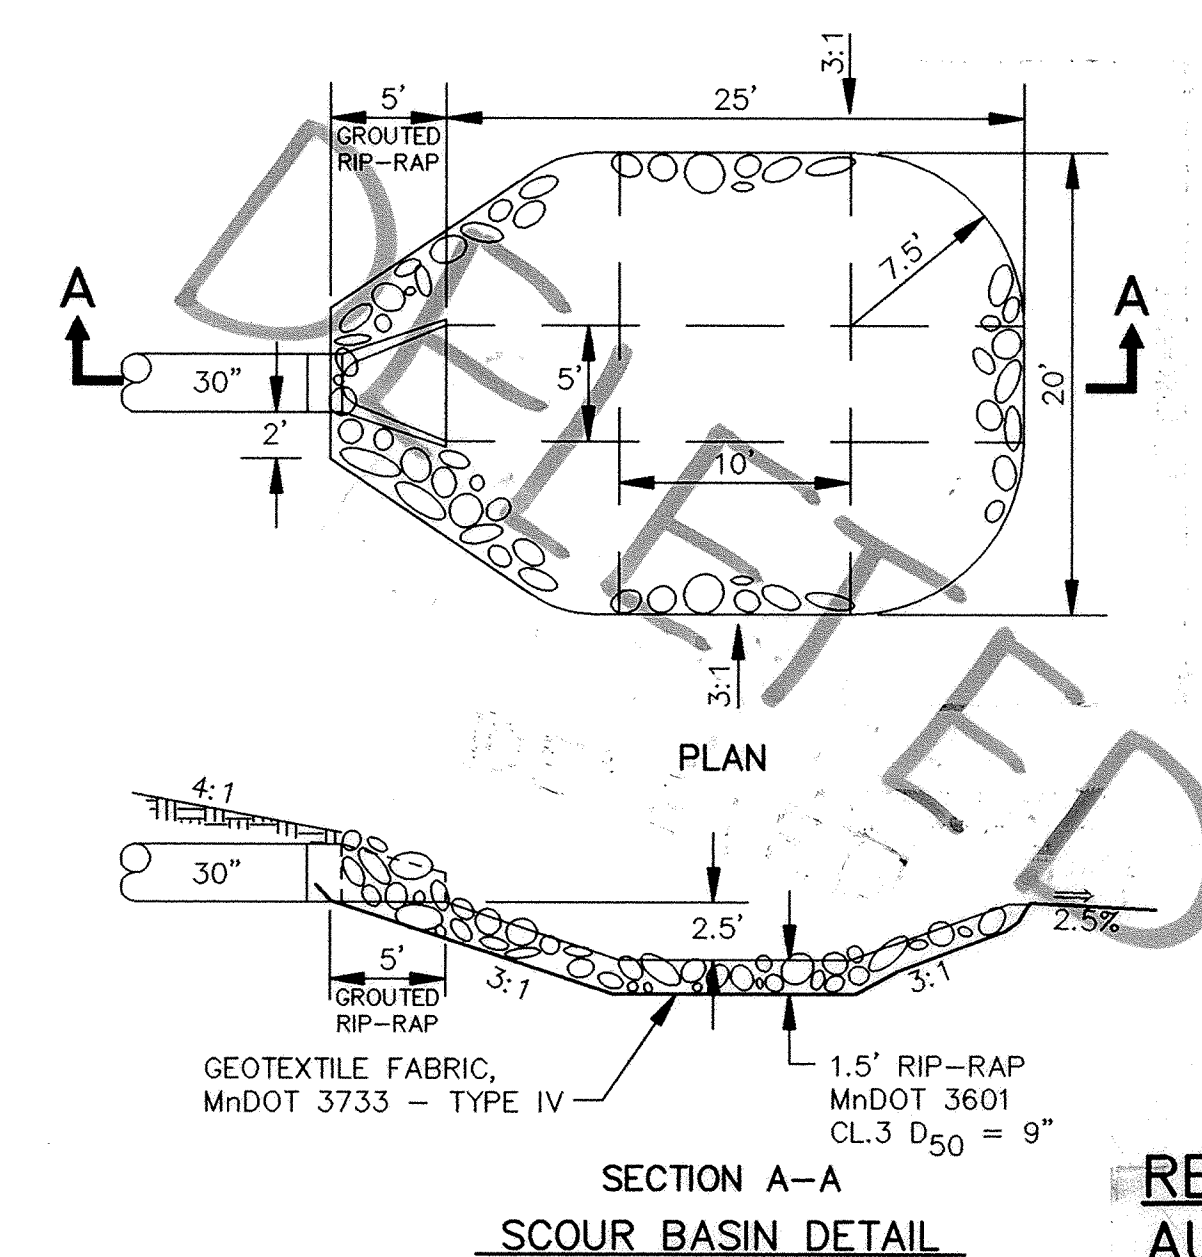
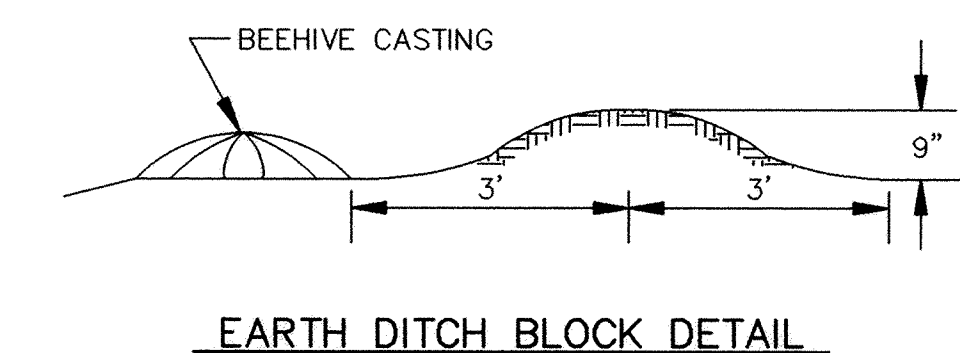


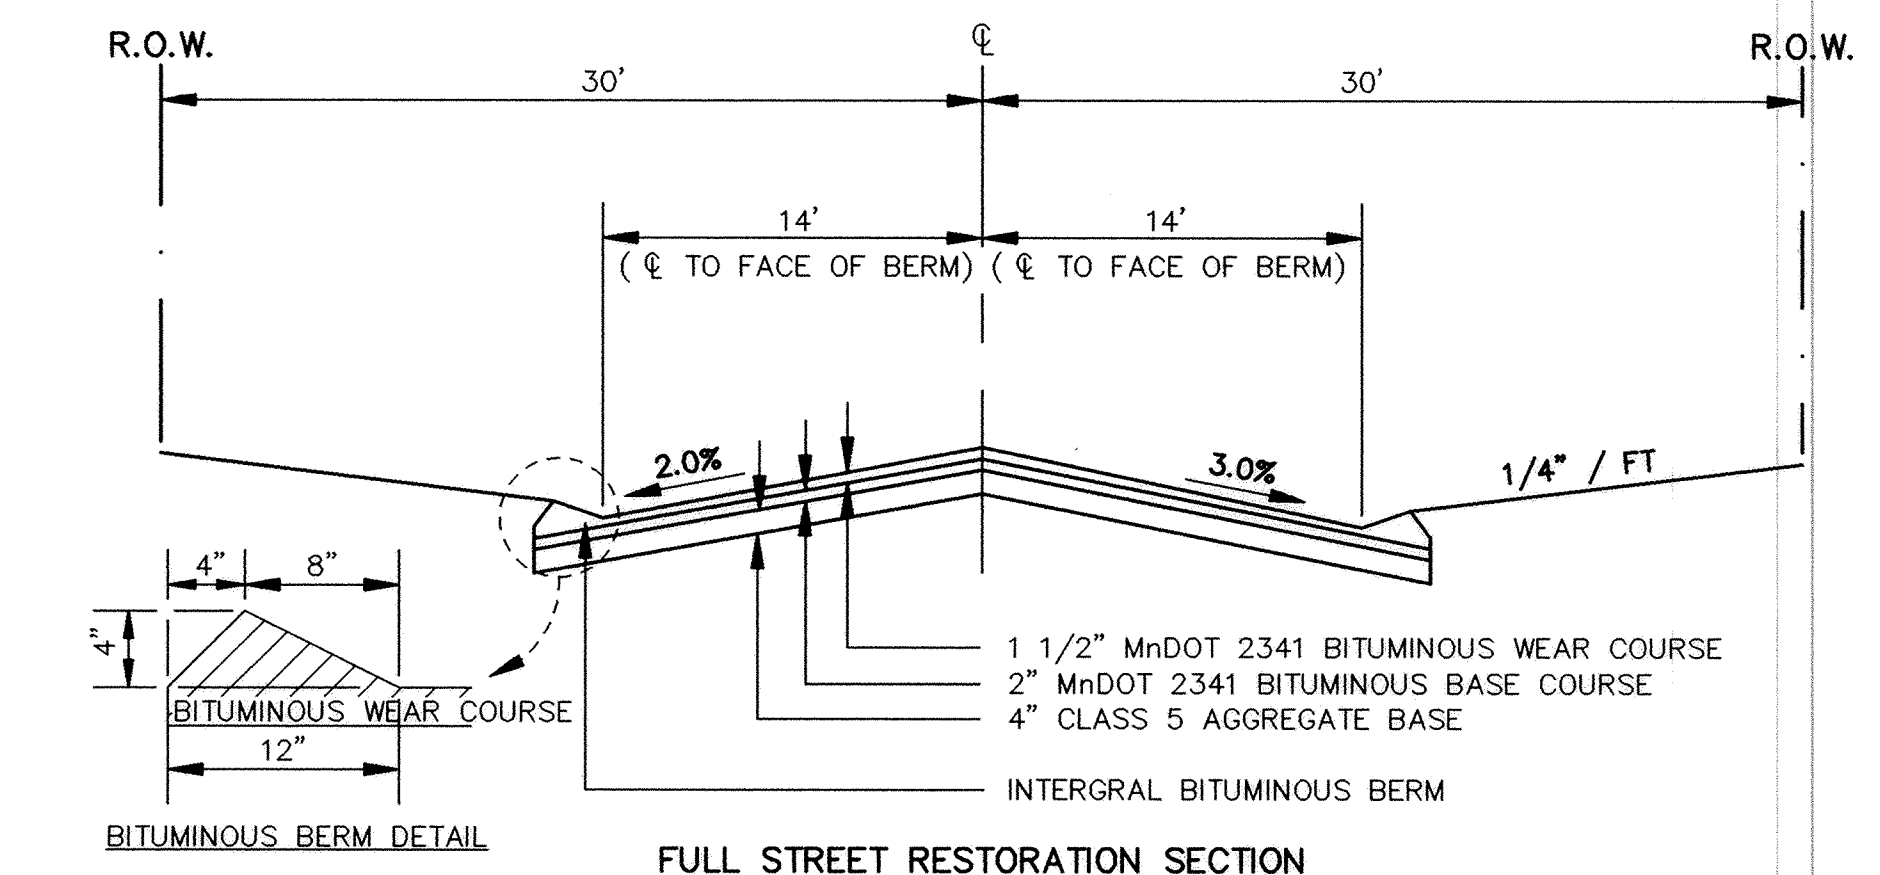

RECORD PLAN
AUGUST 1994

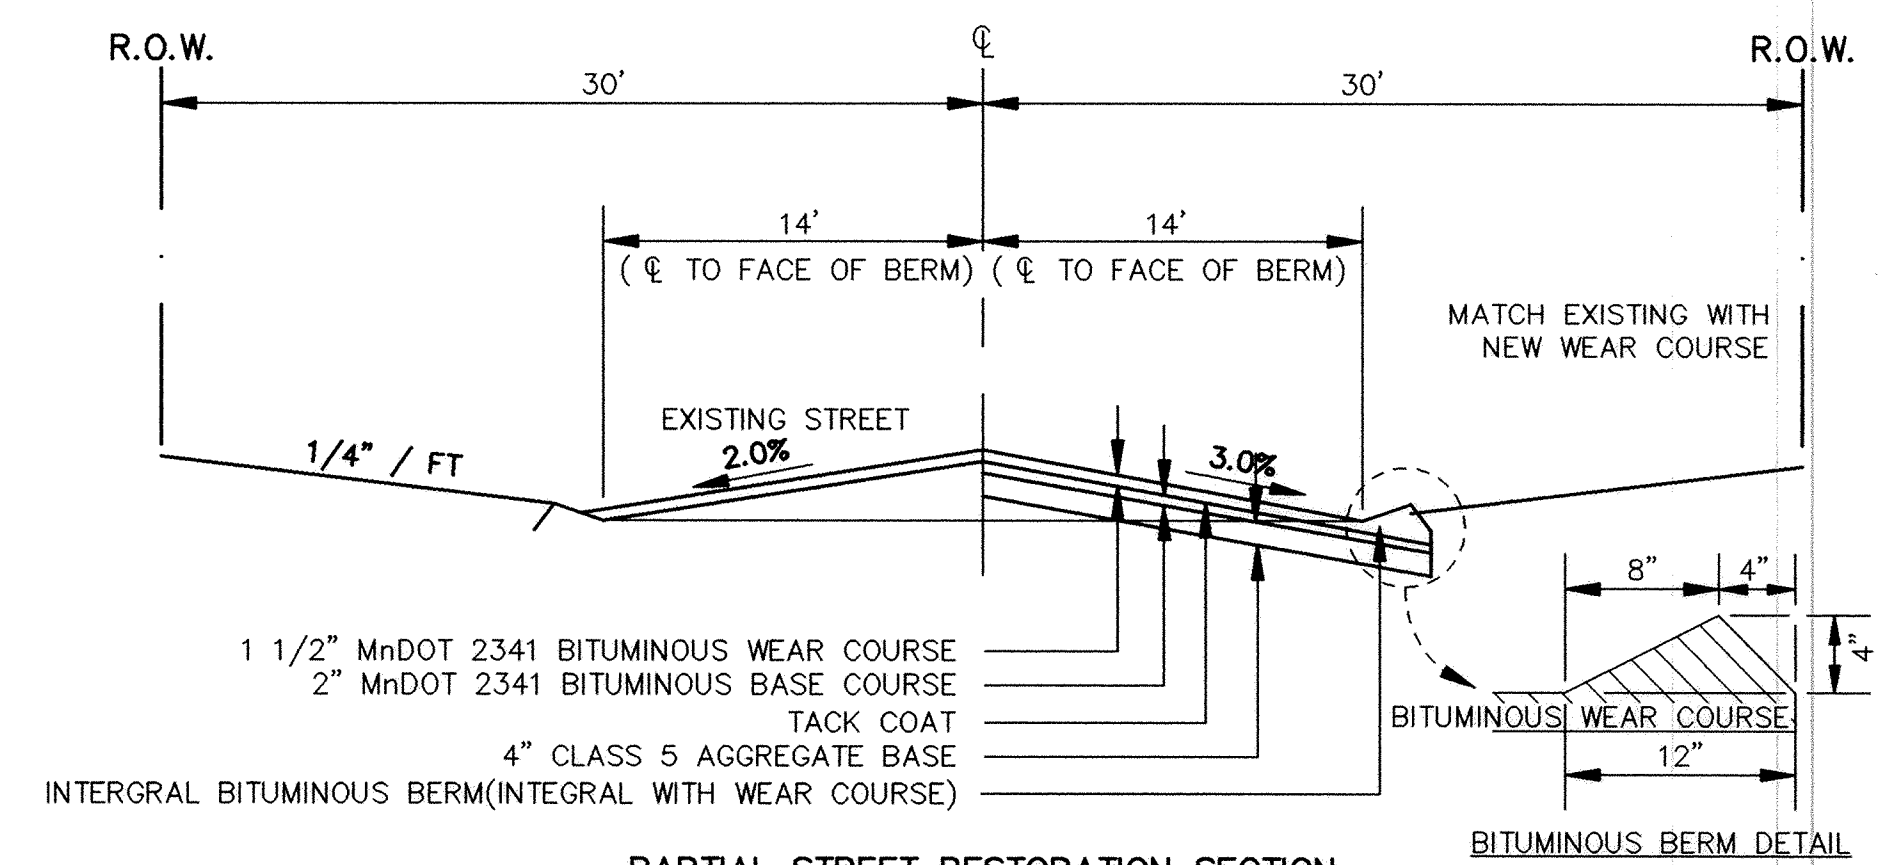

I HEREBY CERTIFY THAT THIS PLAN, SPECIFICATION, OR REPORT WAS PREPARED BY ME OR UNDER MY DIRECT SUPERVISION AND THAT I AM A DULY REGISTERED PROFESSIONAL ENGINEER UNDER THE LAWS OF THE STATE OF MINNESOTA.

Terence J. Maurer

DATE 10/8/95 REG. NO. 15316

MSA CONSULTING ENGINEERS
Maier Stewart & Associates Inc.
1326 ENERGY PARK DRIVE (612) 644-4389 ST. PAUL, MINNESOTA 55108
9800 SHELARD PARKWAY (612) 546-0432 MINNEAPOLIS, MINNESOTA 55441

REVISIONS	DATE	DESCRIPTION	DESIGNED <u> DEN </u>
			CHECKED <u> BAI </u>
			DRAWN <u> CLS </u>
			GRAPHIC SCALE
			0 <u> HORIZ. </u>
		0 <u> VERT. </u>	

CITY OF ELK RIVER			
STORMWATER SYSTEM IMPROVEMENTS			
INDEX MAP AND TYPICAL SECTION			
DATE <u>OCT. 1993</u>	SHEET <u>2</u> OF <u>7</u> SHEETS	PROJECT NO. <u>230-195</u>	