
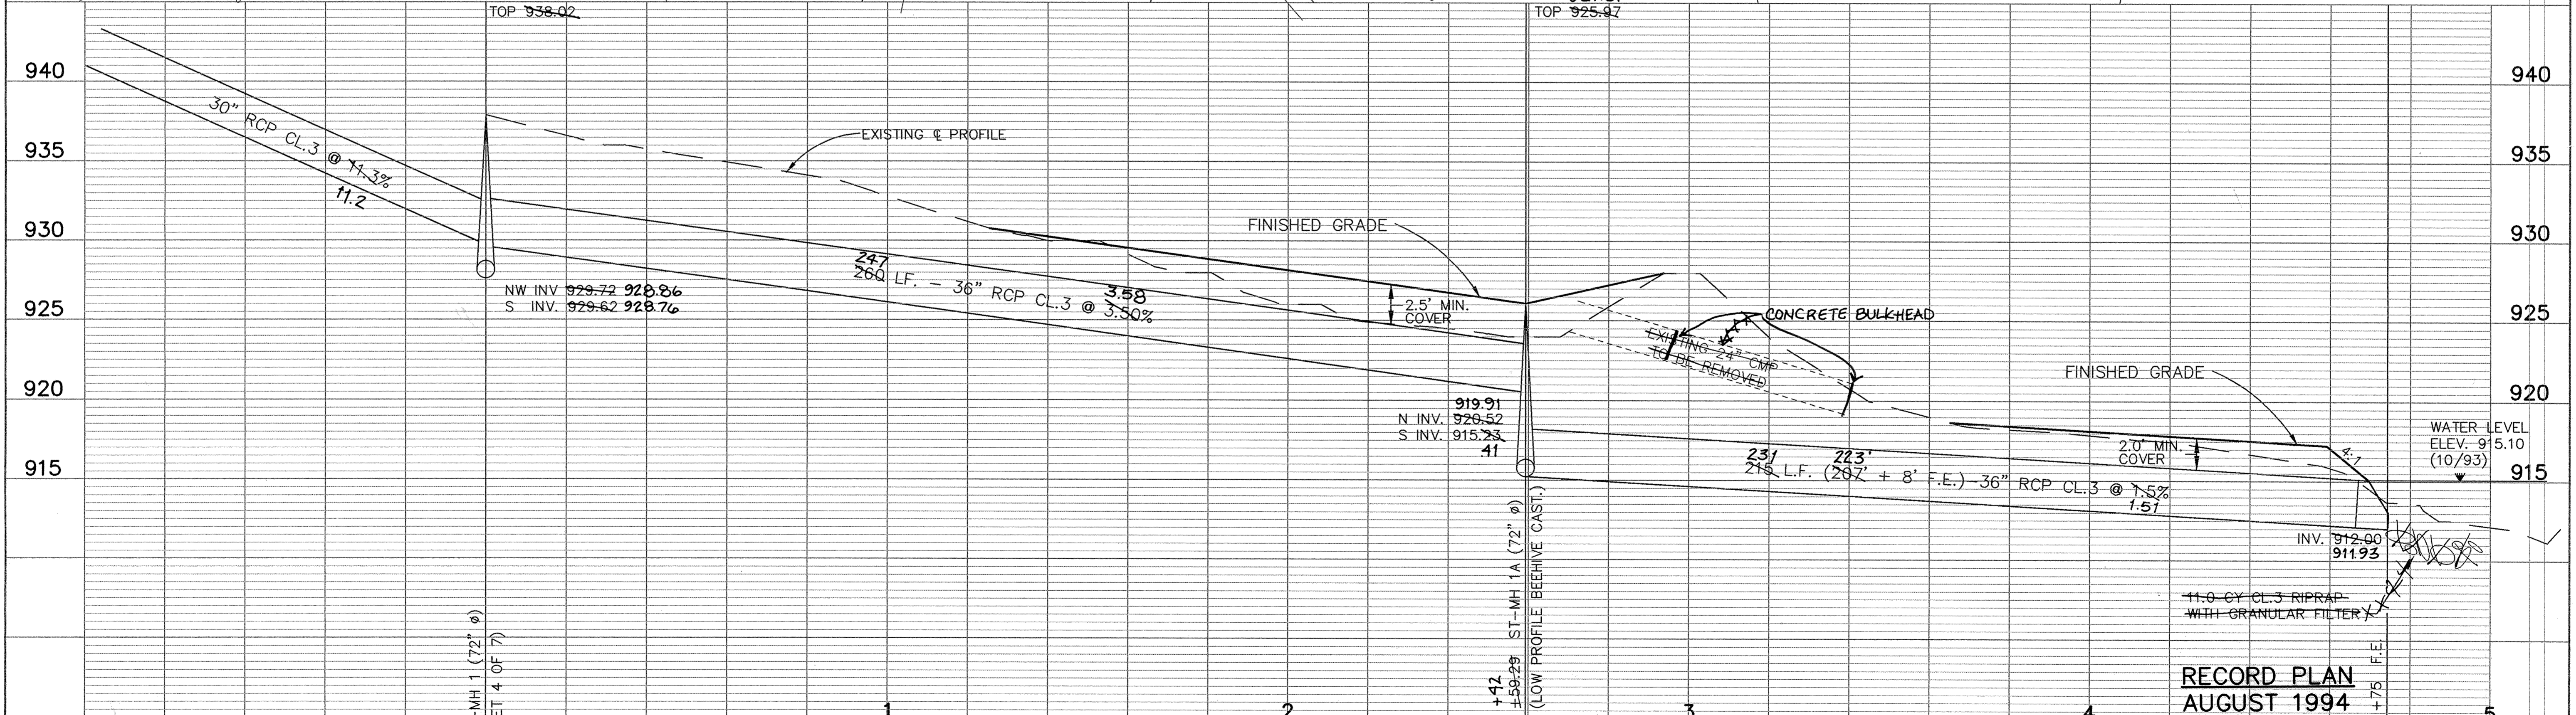


DRAINAGE EASEMENT

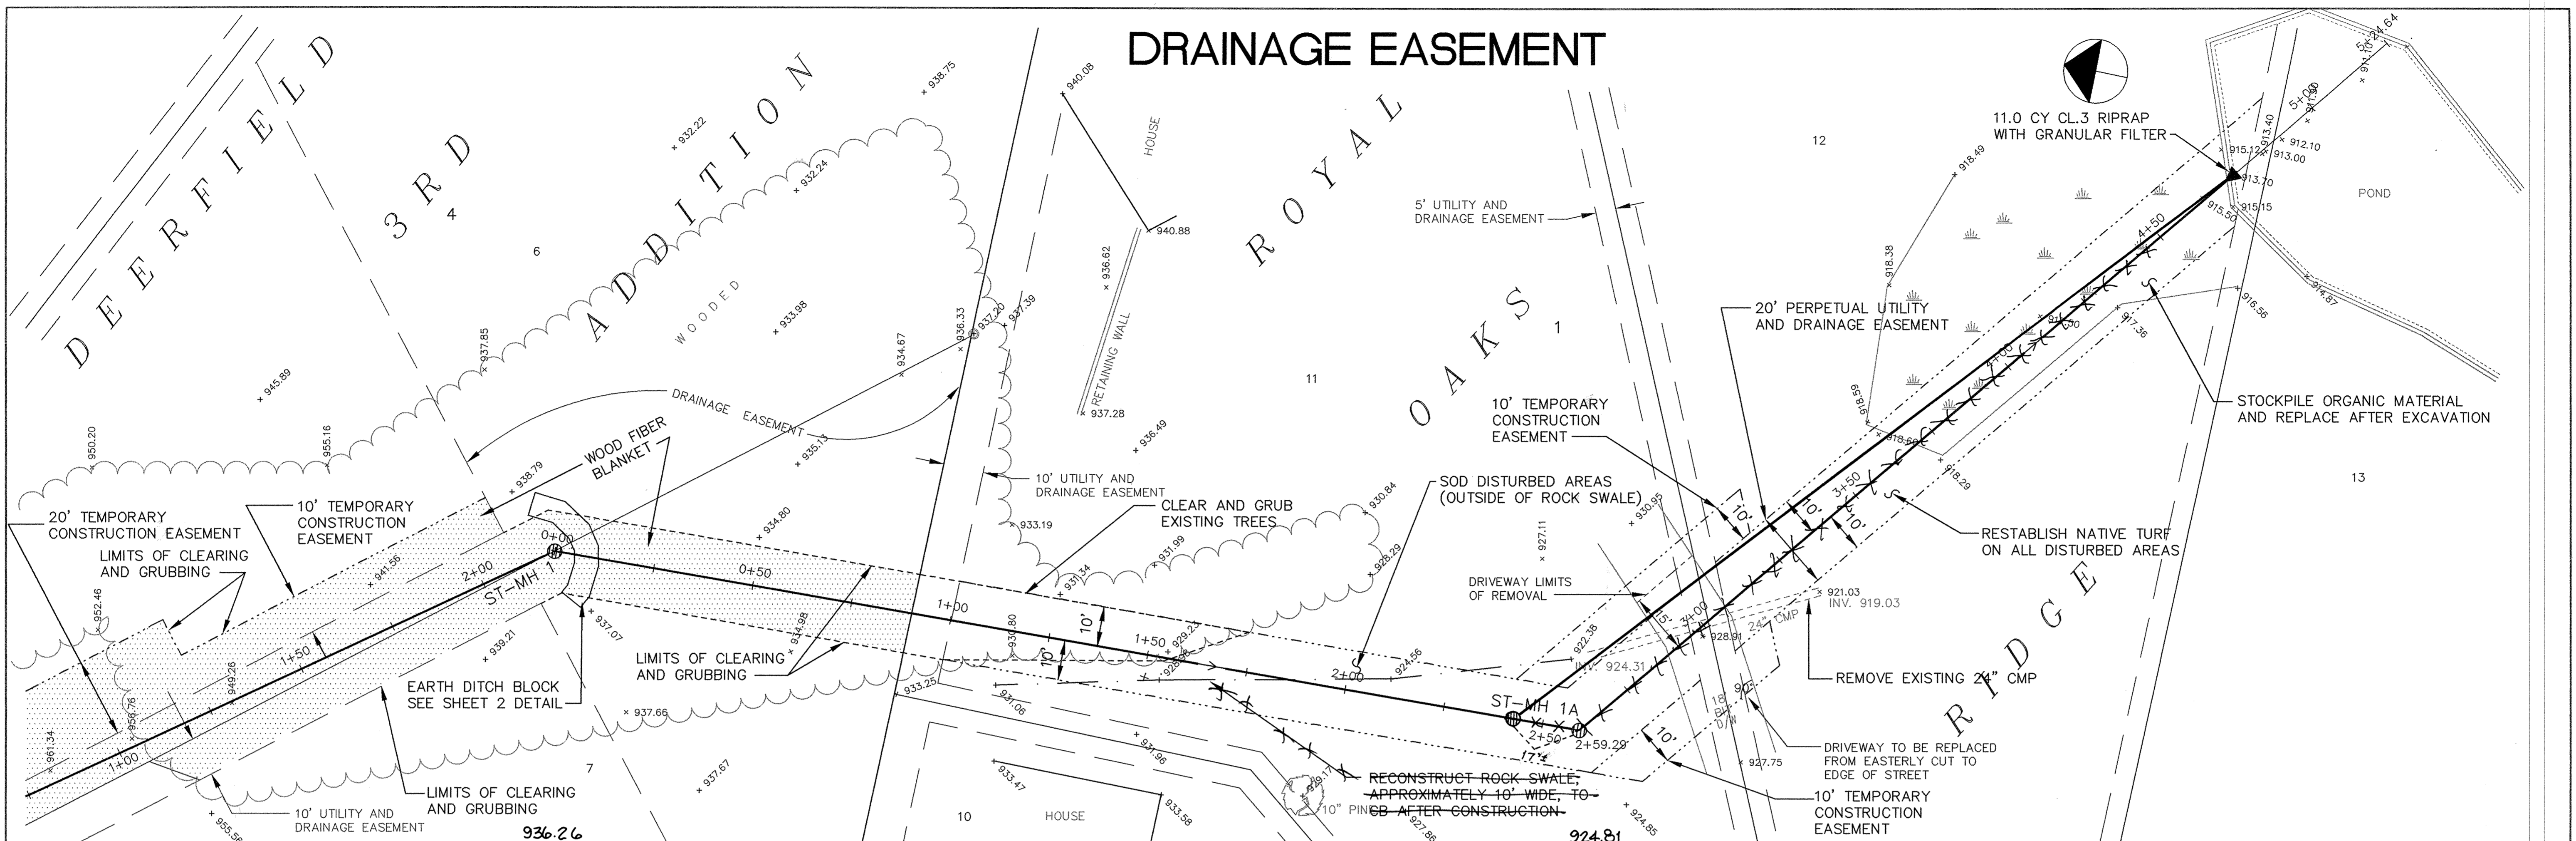

I HEREBY CERTIFY THAT THIS PLAN, SPECIFICATION, OR REPORT WAS PREPARED BY ME OR UNDER MY DIRECT SUPERVISION AND THAT I AM A DULY REGISTERED PROFESSIONAL ENGINEER UNDER THE LAWS OF THE STATE OF MINNESOTA.

Terry J. Maurer
 DATE 2/22/94 REG. NO. 15316

MS&A CONSULTING ENGINEERS
 Maier Stewart & Associates Inc.
 1959 SLOAN PLACE (612) 774-6021 ST. PAUL, MINNESOTA 55117
 9800 SHELARD PARKWAY (612) 546-0432 MINNEAPOLIS, MINNESOTA 55441

REVISIONS	DATE	DESCRIPTION	DESIGNED	DEN.
			BAI	
			CLS	

CITY OF ELK RIVER
 STORMWATER SYSTEM IMPROVEMENTS
 DRAINAGE EASEMENT
 CHANGE ORDER NO. 1 STA. 0+00 TO 5+00

DATE JAN. 1994 SHEET 1 OF 1 SHEETS PROJECT NO. 230-195

DRAWING NUMBER
 DEERFIELD 3RD
 8 (1 of 1)
 SAECO PRODUCTS • NEW HOPE, MINNESOTA
 REPRODUCED BY PART NUMBER 8592