

ARC'D PRODUCTS • NEW HOPE, MINNESOTA
REORDER BY PART NUMBER 8282


ARC'D PRODUCTS • NEW HOPE, MINNESOTA
REORDER BY PART NUMBER 8282

ARC'D PRODUCTS • NEW HOPE, MINNESOTA
REORDER BY PART NUMBER 8282

ARC'D PRODUCTS • NEW HOPE, MINNESOTA
REORDER BY PART NUMBER 8282

VERTICAL SCALE OF PRINT ON THIS LINE
HORIZONTAL SCALE OF PRINT ON THIS LINE
VERTICAL SCALE OF PRINT ON THIS LINE
HORIZONTAL SCALE OF PRINT ON THIS LINE

DEERFIELD 4TH
230-013-40
EARTHWORK ASBUILT
FOR QUANTITIES
299A

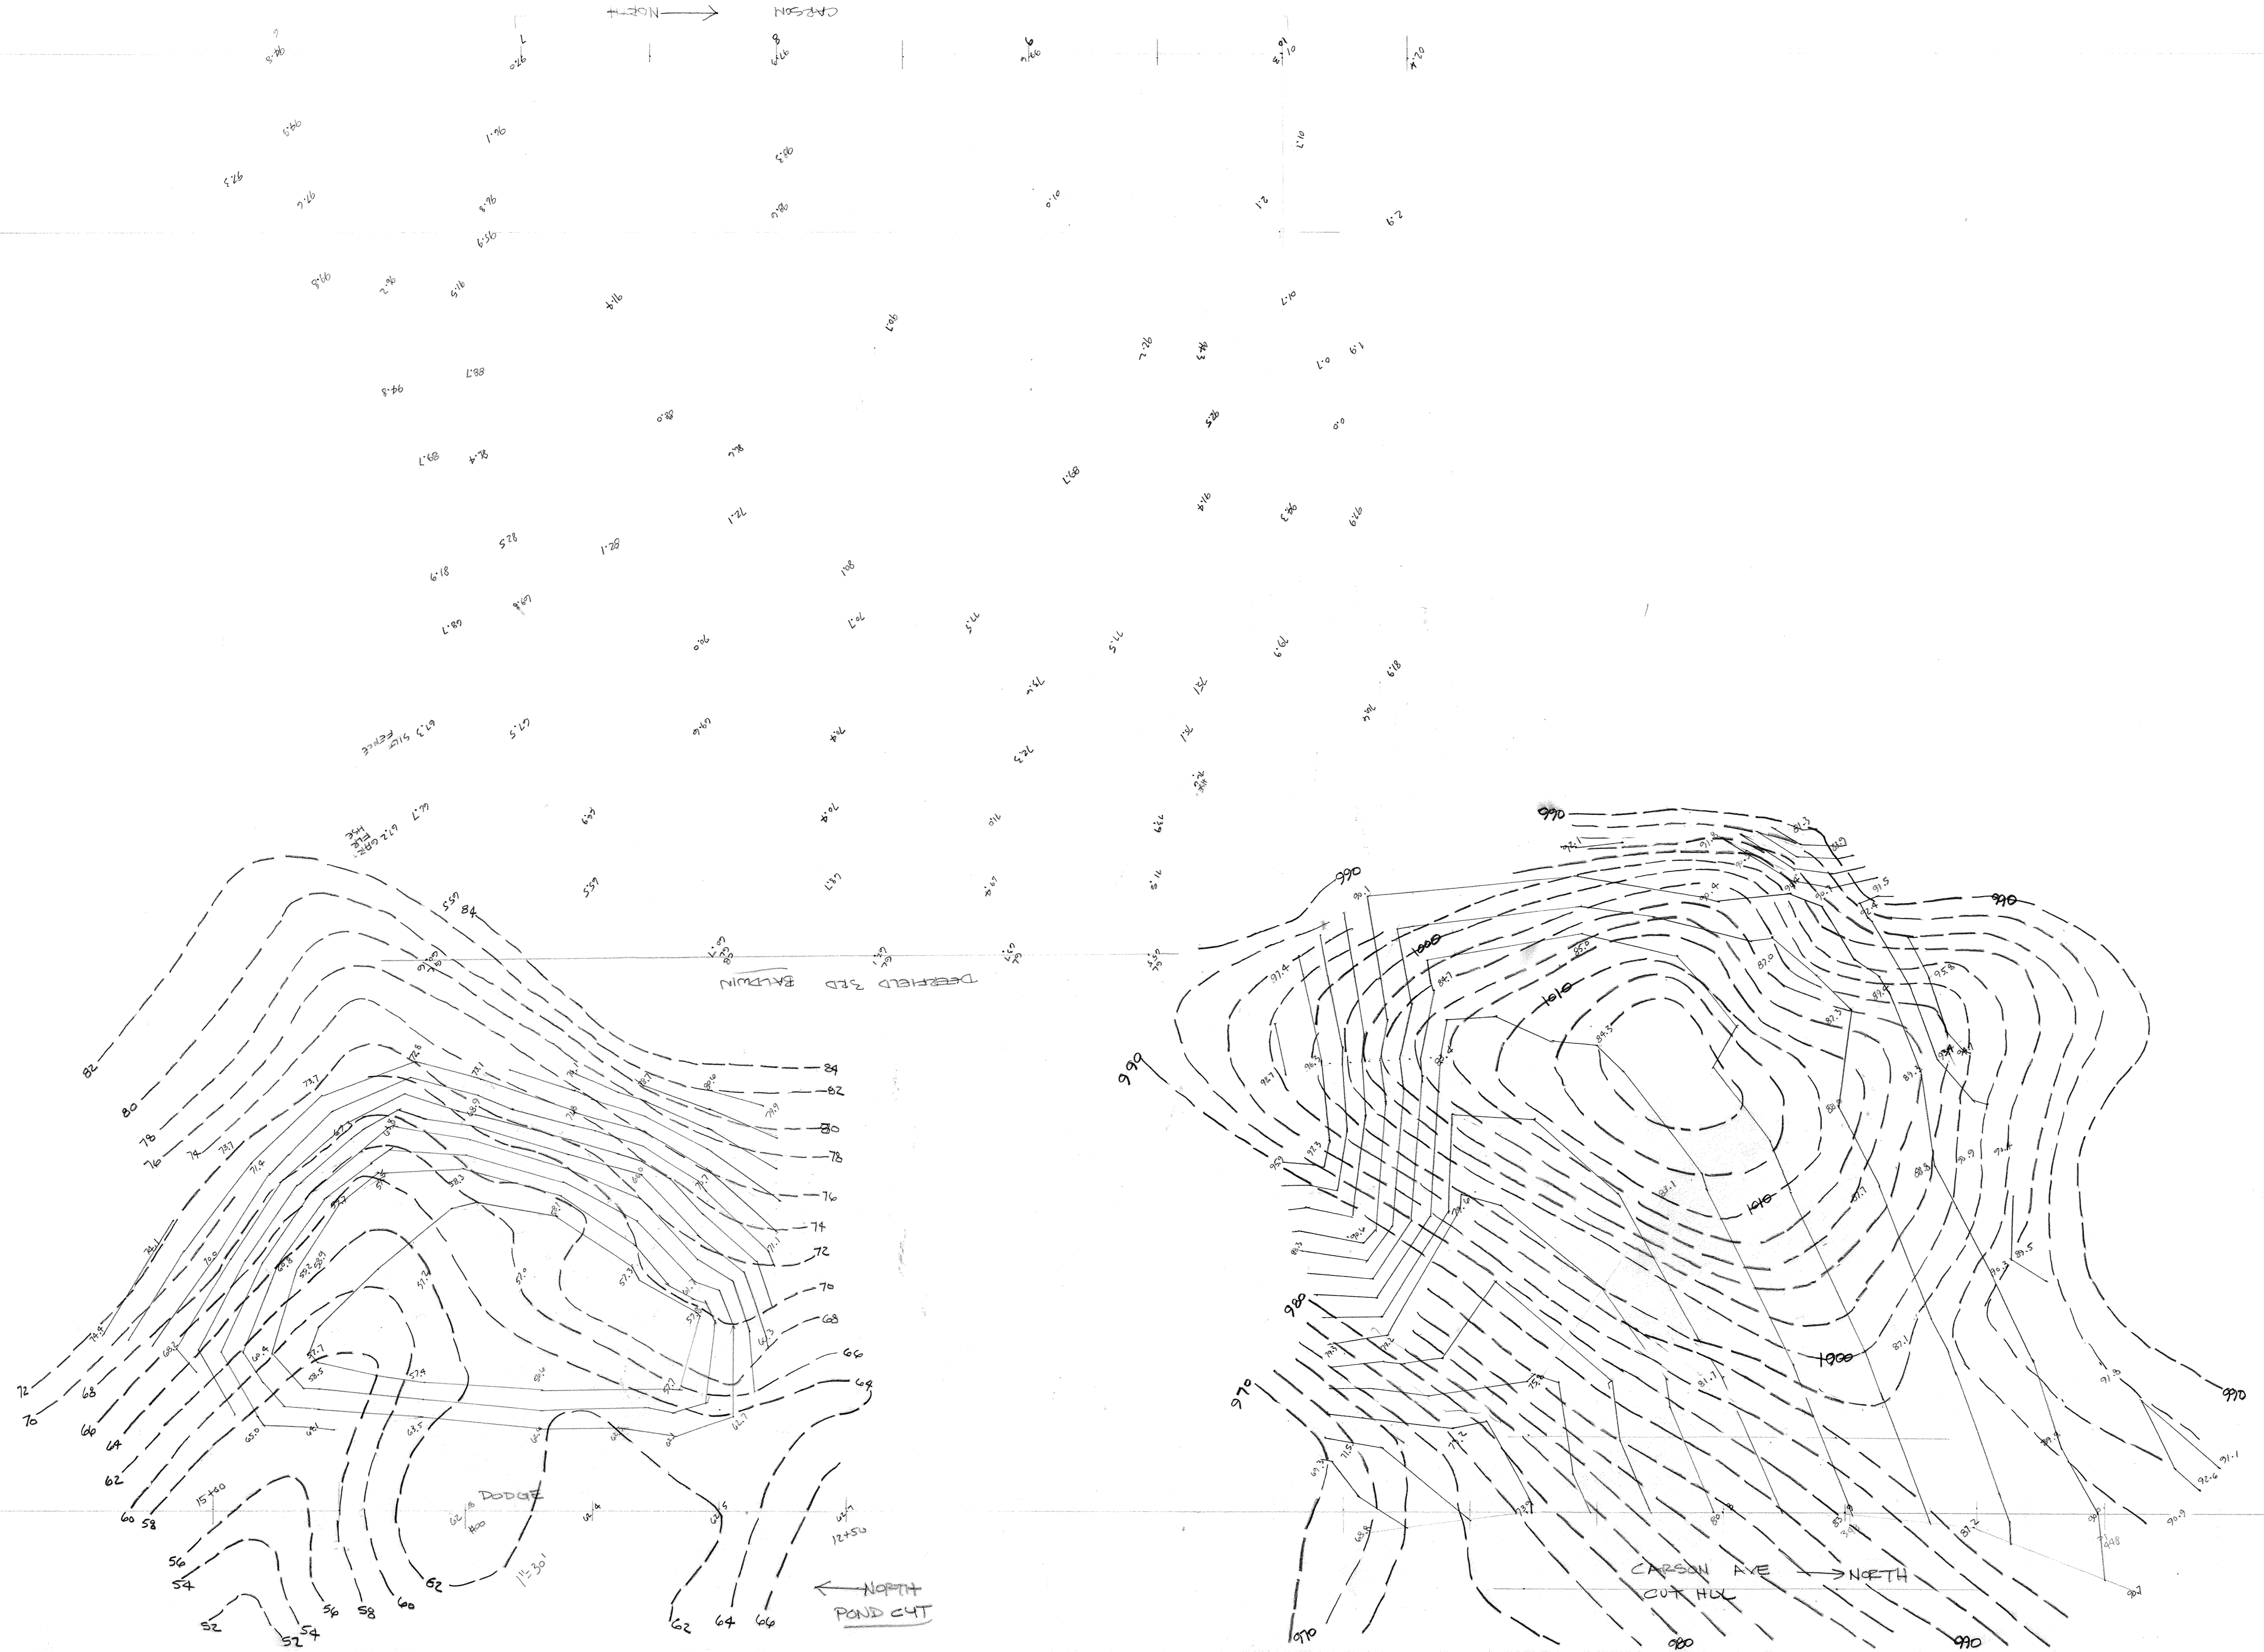

← NORTH
POND CUT

CARSON AVE
CUT HUL → NORTH