
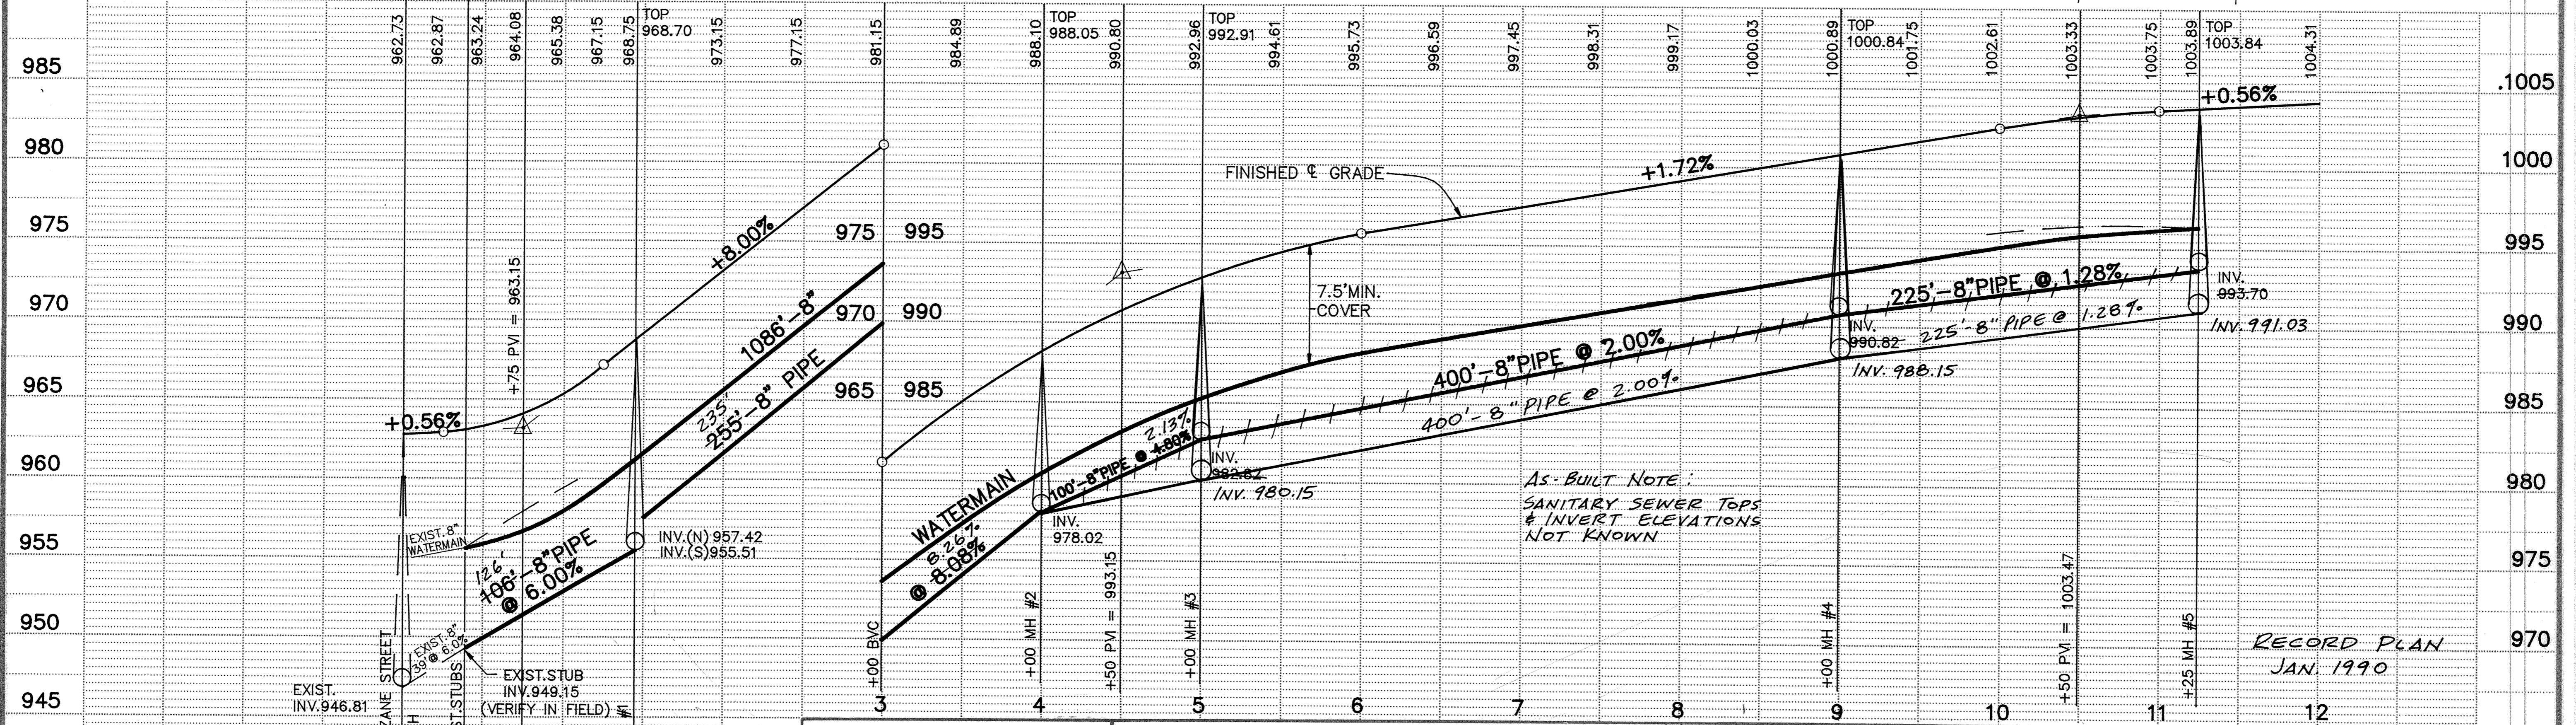


CARSON STREET

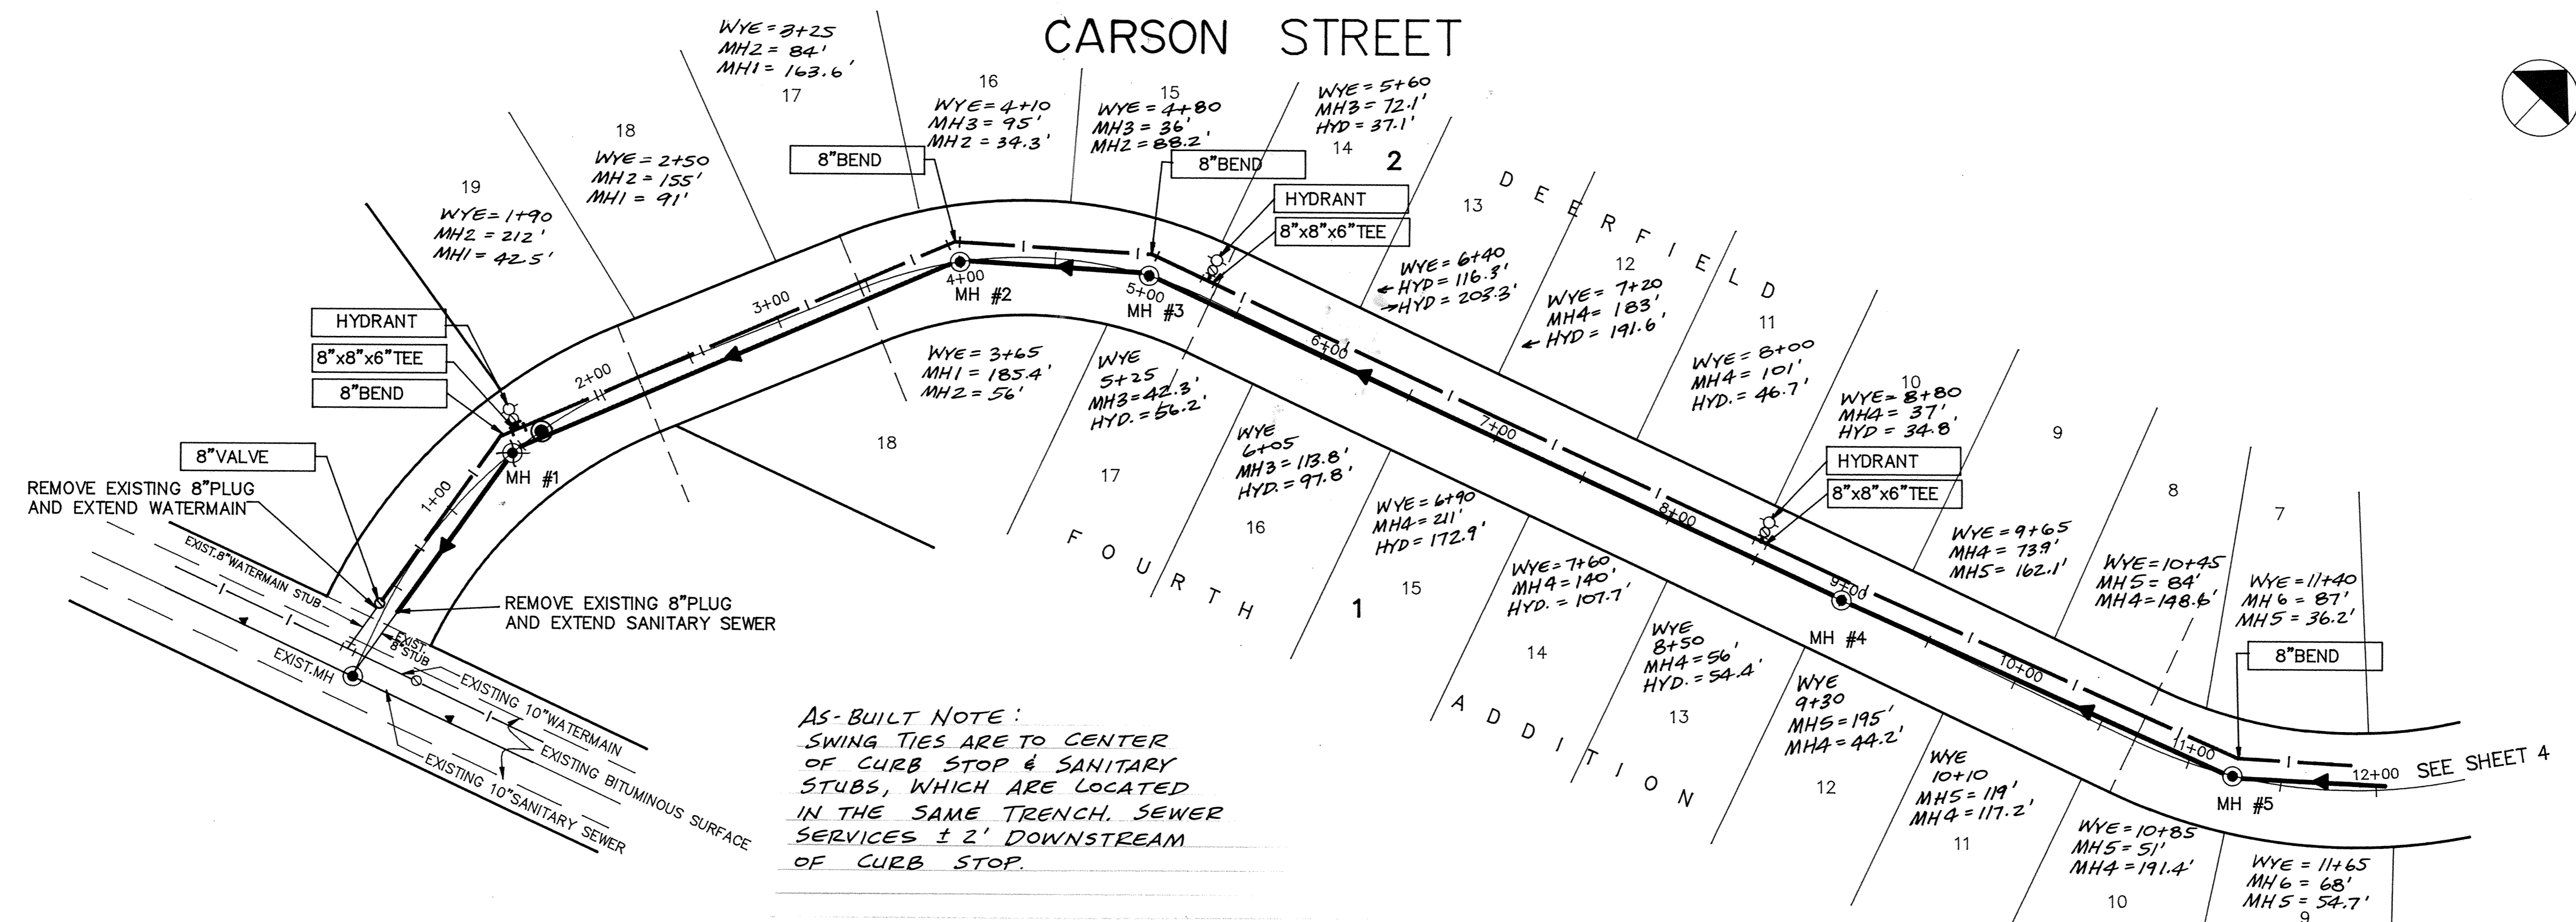

I HEREBY CERTIFY THAT THIS PLAN, SPECIFICATION, OR REPORT WAS PREPARED BY ME OR UNDER MY DIRECT SUPERVISION AND THAT I AM A DULY REGISTERED PROFESSIONAL ENGINEER UNDER THE LAWS OF THE STATE OF MINNESOTA.

Tony J. Maier
DATE 8/21/87 REG. NO. 15316

MSA CONSULTING ENGINEERS
Maier Stewart & Associates Inc.
1959 SLOAN PLACE (612) 774-6021 ST. PAUL, MINNESOTA 55117

REVISIONS	DATE	DESCRIPTION	DESIGNED	CHECKED	DRAWN

GRAPHIC SCALE
HORIZ. 50
VERT. 5

CITY OF ELK RIVER
SANITARY SEWER AND WATERMAIN
CARSON STREET

DATE JULY, 1989 SHEET 3 OF 16 SHEETS PROJECT NO. 230-073