
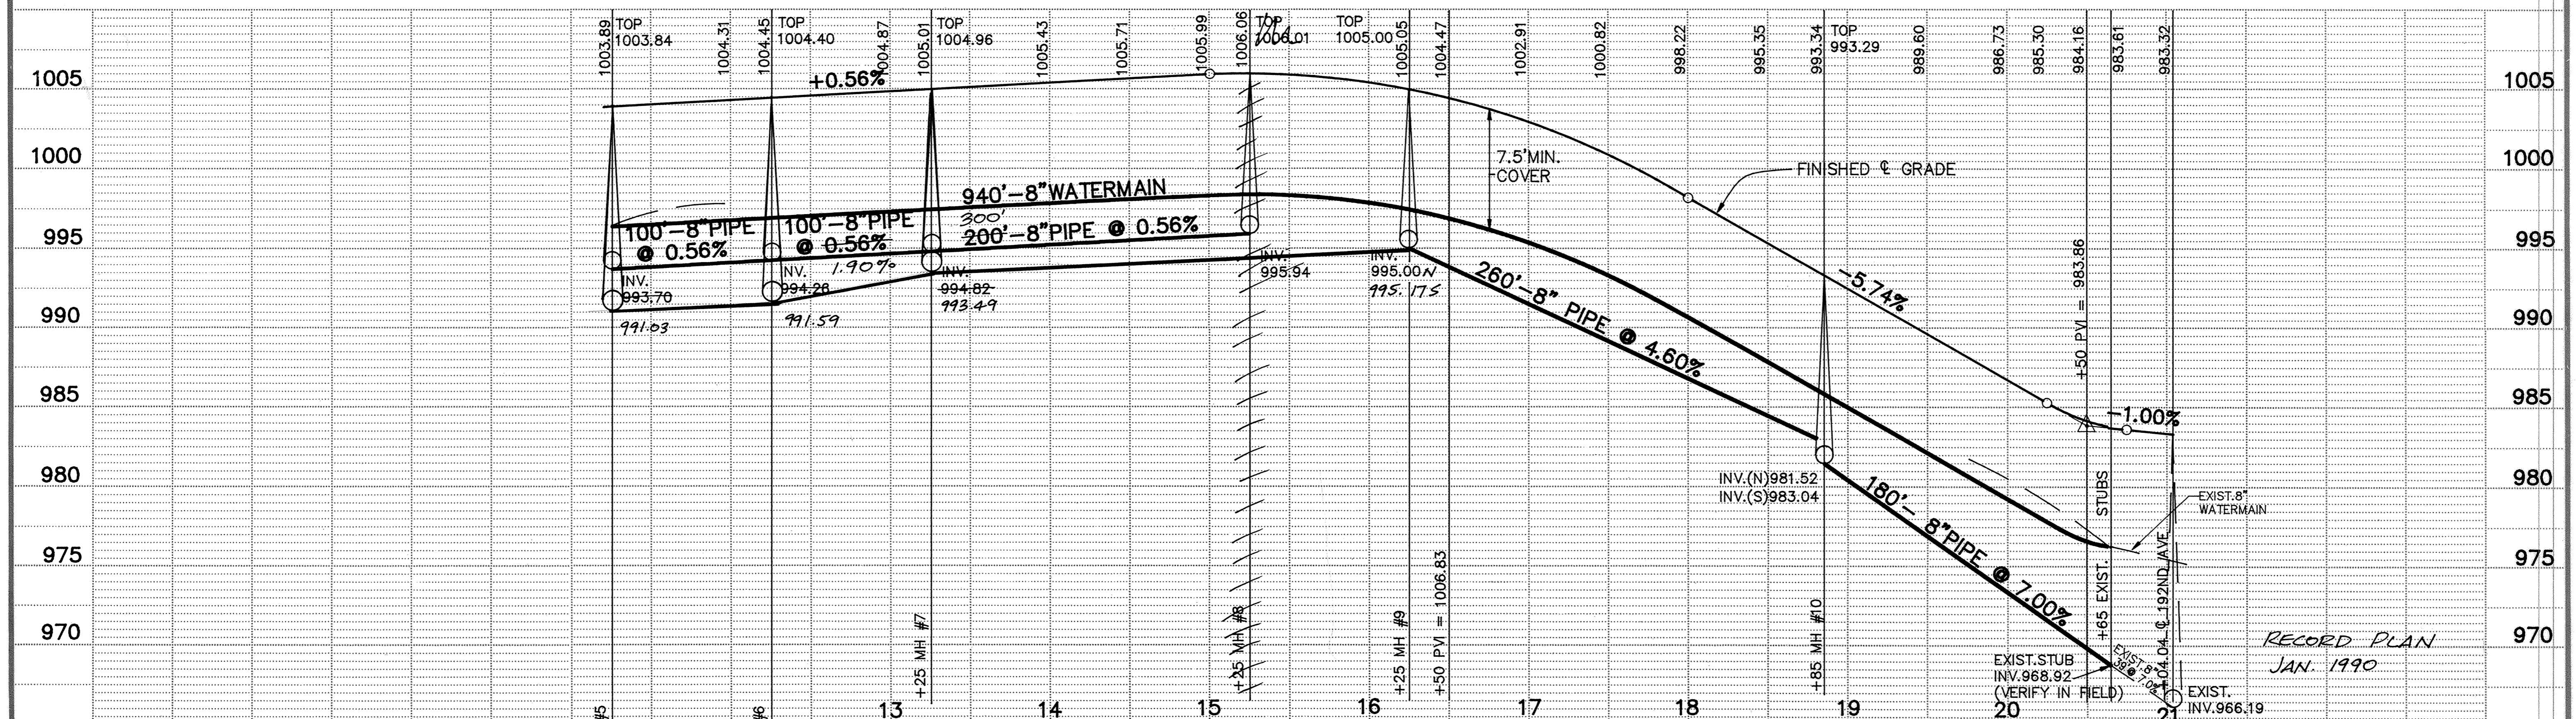


# CARSON STREET

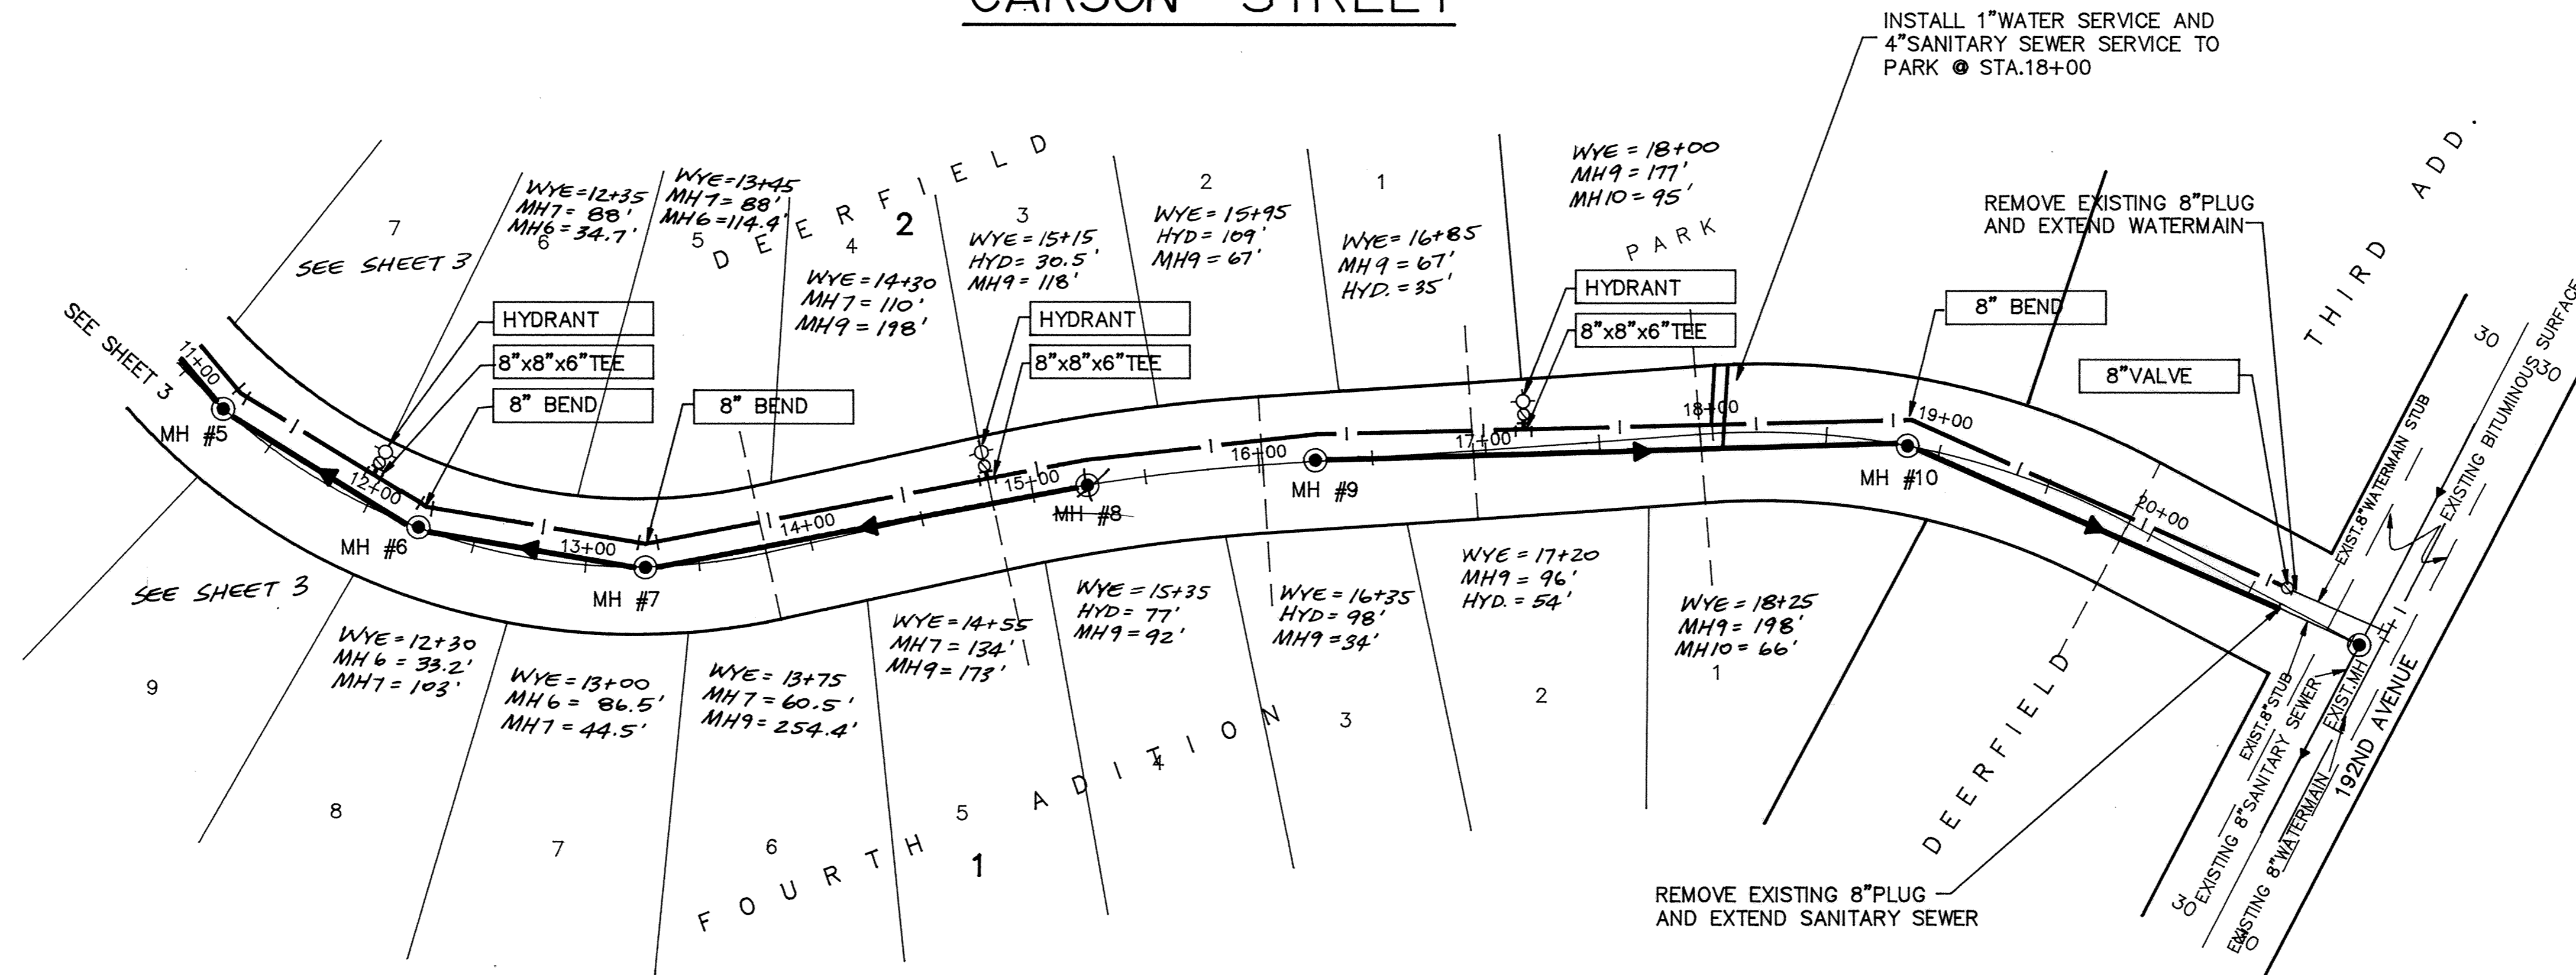

I HEREBY CERTIFY THAT THIS PLAN, SPECIFICATION, OR REPORT WAS PREPARED BY ME OR UNDER MY DIRECT SUPERVISION AND THAT I AM A DULY REGISTERED PROFESSIONAL ENGINEER UNDER THE LAWS OF THE STATE OF MINNESOTA.

*Larry J. Maun*

DATE 8/21/89 REG. NO. 15314

**MSA** CONSULTING ENGINEERS

**Maier Stewart & Associates Inc.**

1959 SLOAN PLACE (612) 774-6021 ST. PAUL, MINNESOTA 55117

DATE	DESCRIPTION	DESIGNED
		CHECKED
		DRAWN
		GRAPHIC SCALE
		0' HORIZ. 50'
		0' VERT. 5'

**CITY OF ELK RIVER**

SANITARY SEWER AND WATERMAIN  
CARSON STREET

DATE JULY, 1989 SHEET 4 OF 16 SHEETS PROJECT NO. 230-073