




# TYLER STREET

☒ DENOTES 25mm WATER SERVICE RISER SEE DETAIL ON G4

CLEAR AND GRUB  
0.2573 HA

SEE SHEET C1-20

SEE SHEET C1-22

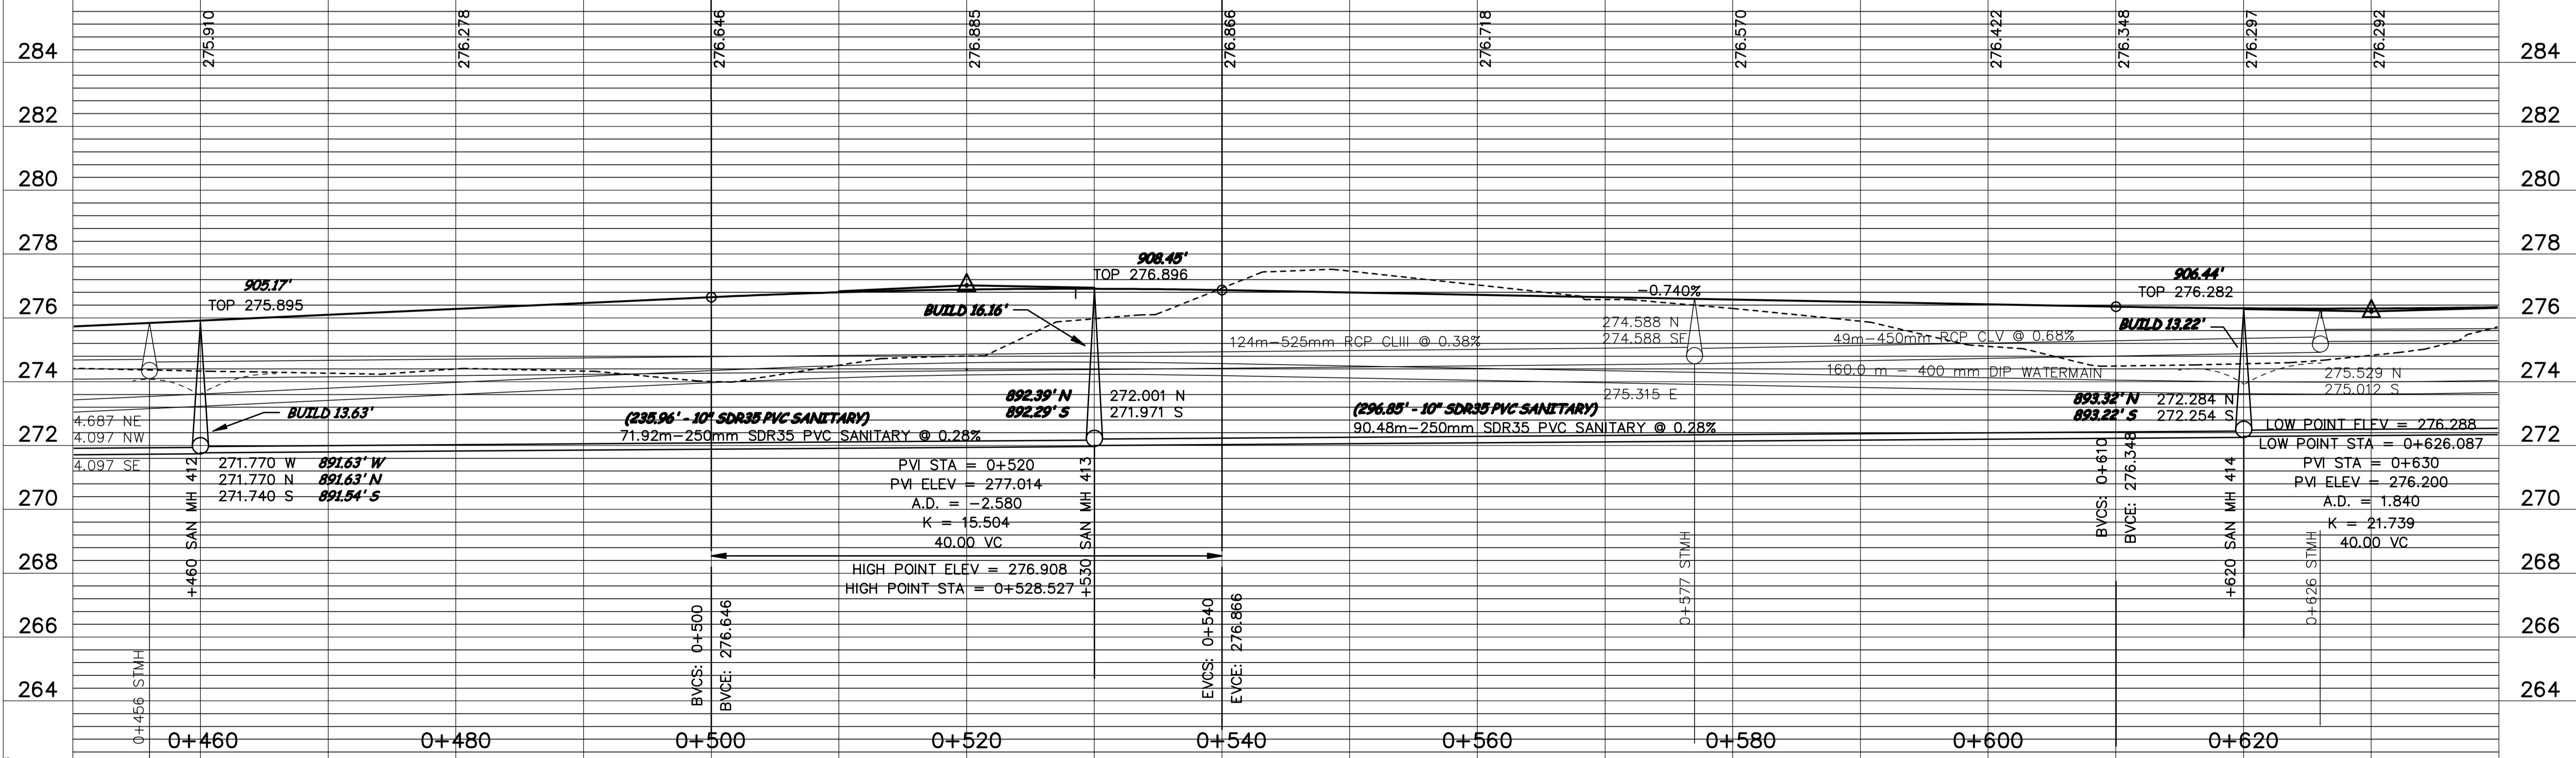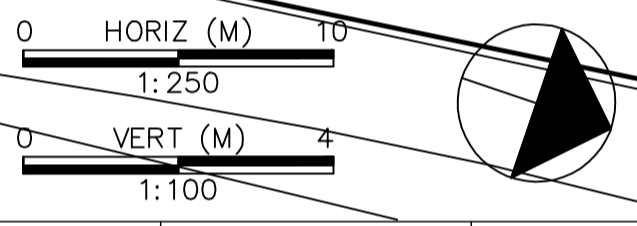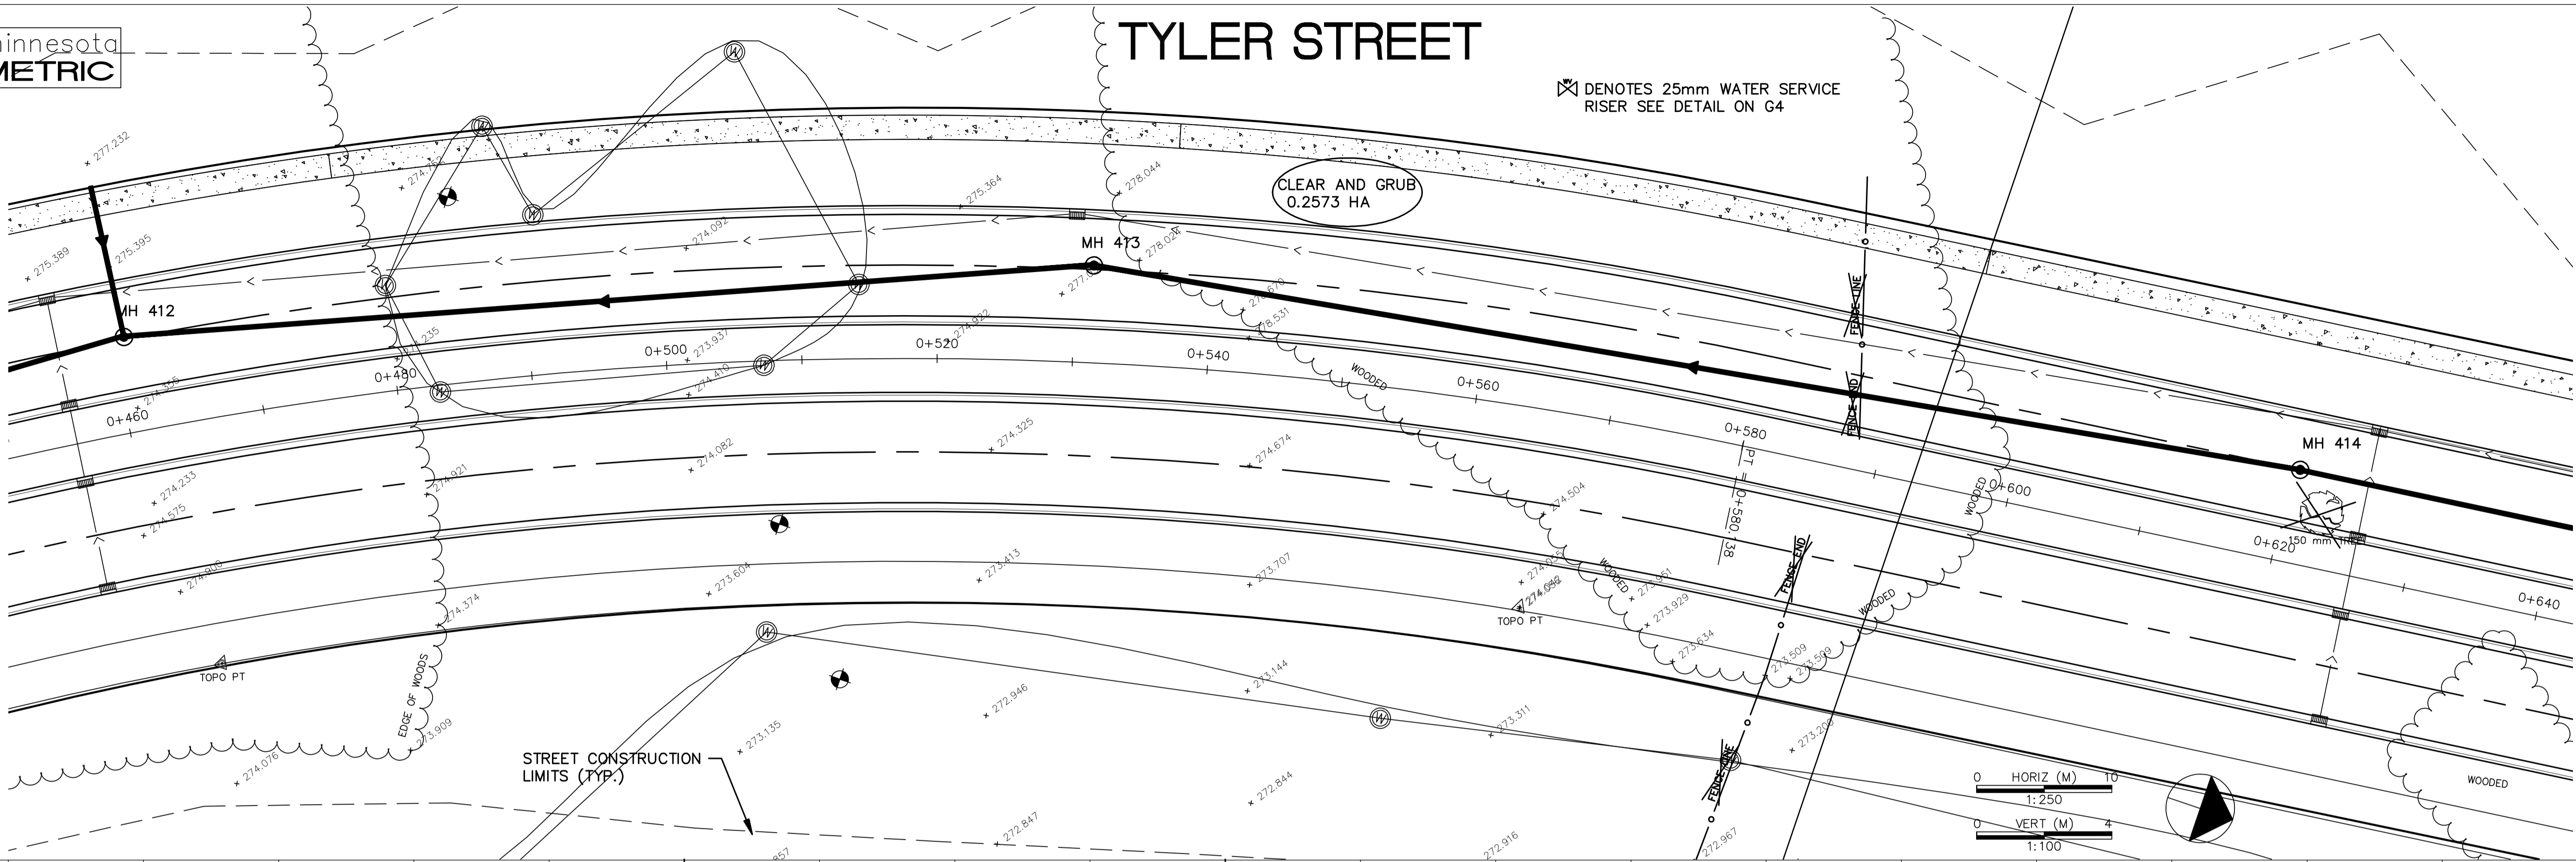

I HEREBY CERTIFY THAT THIS PLAN, SPECIFICATION, OR REPORT WAS PREPARED BY ME OR UNDER MY DIRECT SUPERVISION AND THAT I AM A DULY REGISTERED PROFESSIONAL ENGINEER UNDER THE LAWS OF THE STATE OF MINNESOTA.  
 DATE: \_\_\_\_\_ REG. NO.: 15316

NO.	DATE	BY	REVISION DESCRIPTION
1	1-22-99	PH	DELETED WM C.O. NO.1

1326 ENERGY PARK DRIVE  
 ST. PAUL, MINNESOTA 55108  
 (612) 644-4389

Howard R. Green Company  
 CONSULTING ENGINEERS

CITY OF ELK RIVER  
 EASTERN AREA  
 PHASE I IMPROVEMENTS

STREET AND UTILITY IMPROVEMENTS  
 TYLER STREET  
 0+460 TO 0+620

SHEET NO.  
**C1-21**