
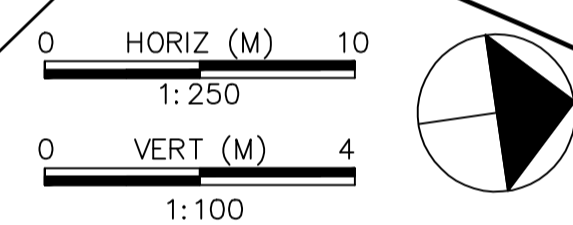


TYLER STREET


minnesota
METRIC

SEE SHEET C1-22

SEE SHEET C2-9

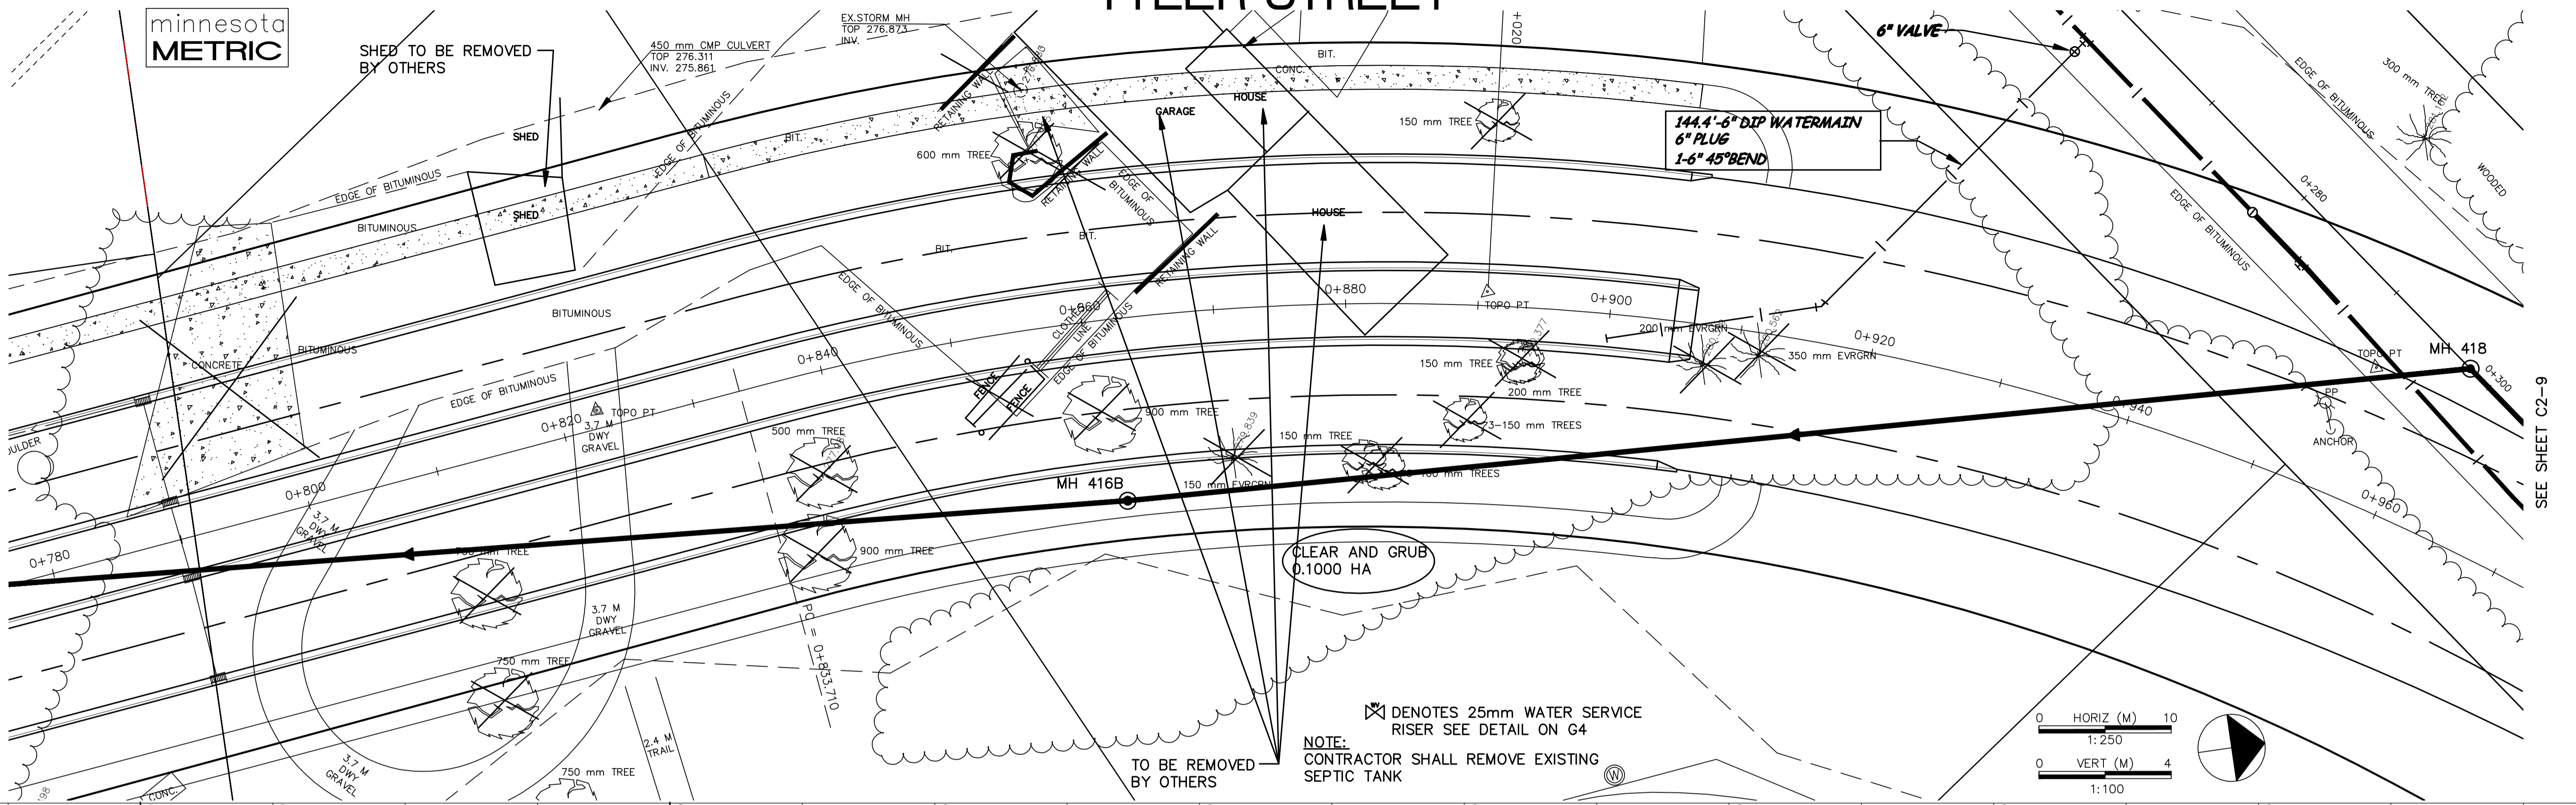

NOTE:
CONTRACTOR SHALL REMOVE EXISTING SEPTIC TANK

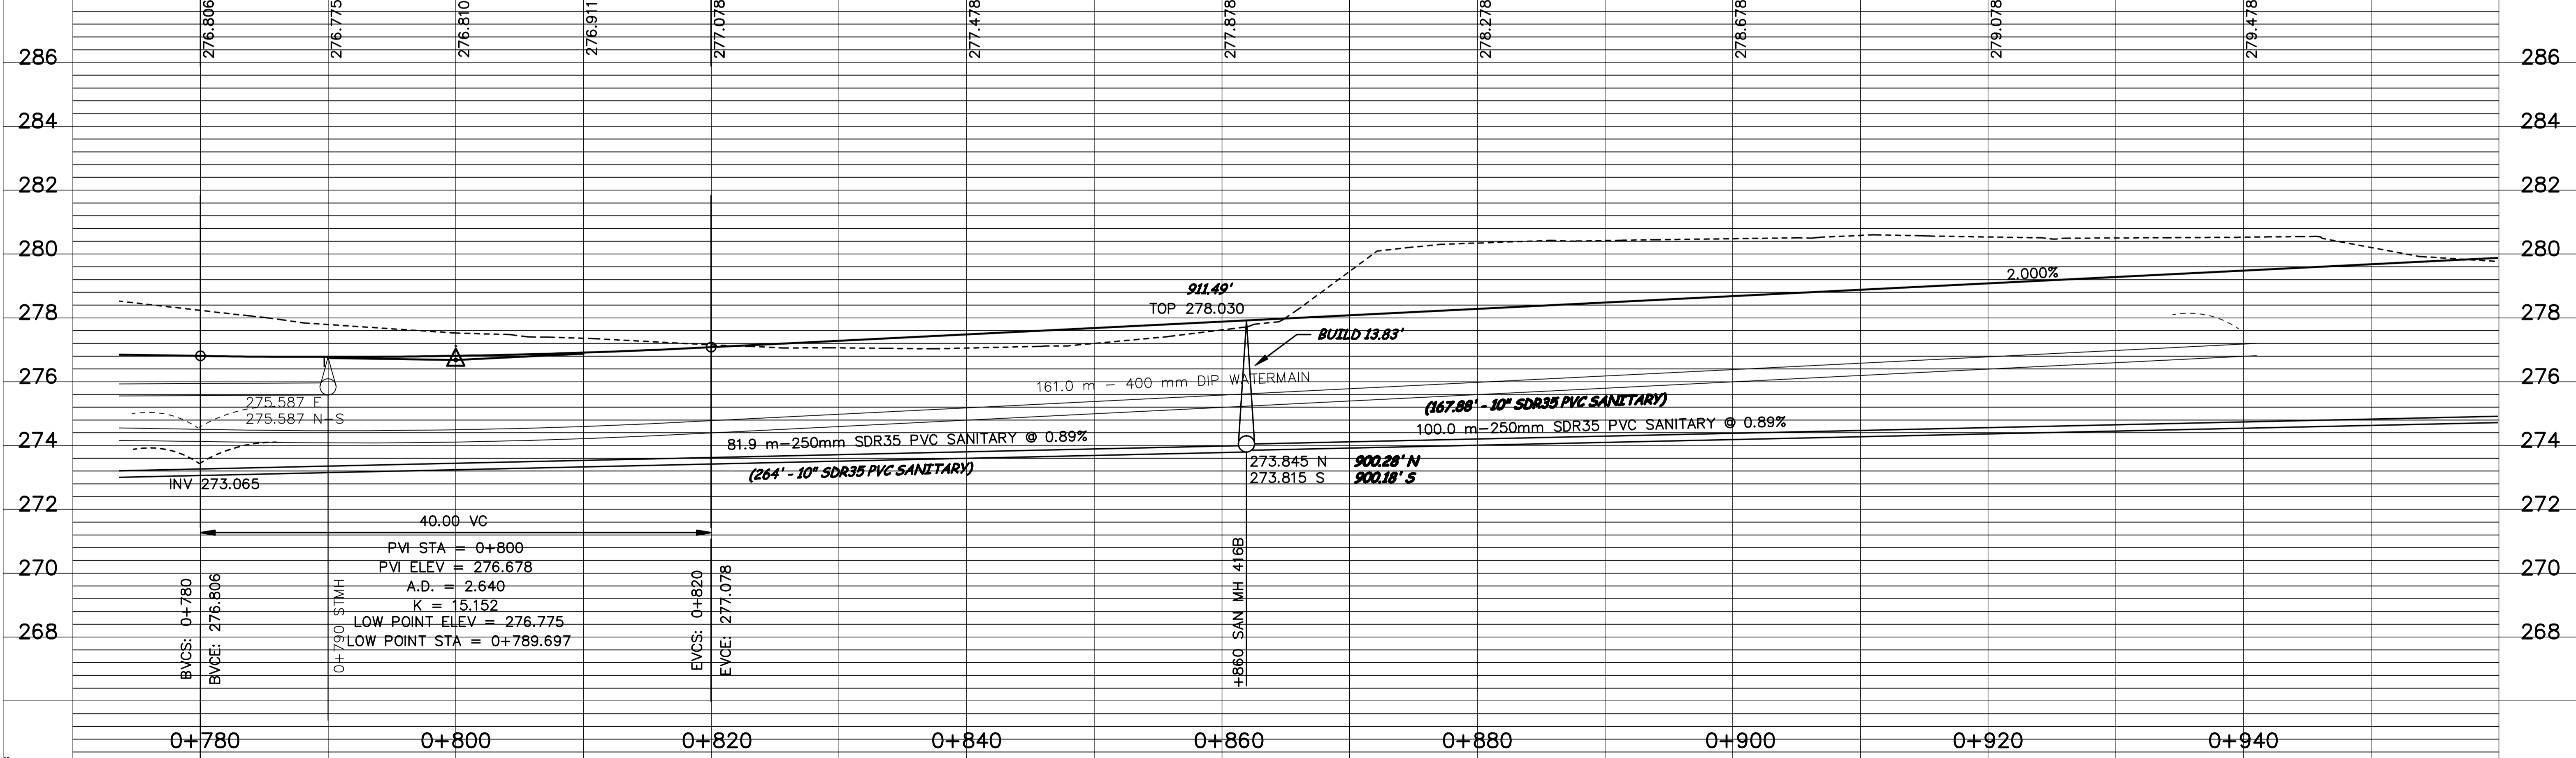

DESIGNED BY: AB JOB DATE: MARCH 1998
 DRAWN BY: [Signature] JOB NUMBER: 800110J
 APPROVED: [Signature] CAD DATE: [Signature]
 CAD FILE: September 16, 1999 11:35:42 a.m.
 800110j\Draws\NORTH_TYLER\06.DWG

I HEREBY CERTIFY THAT THIS PLAN, SPECIFICATION, OR REPORT WAS PREPARED BY ME OR UNDER MY DIRECT SUPERVISION AND THAT I AM A DULY REGISTERED PROFESSIONAL ENGINEER UNDER THE LAWS OF THE STATE OF MINNESOTA.
 DATE: _____ REG. NO.: 15316

NO.	DATE	BY	REVISION DESCRIPTION
1	1-22-99	PH	DELETED WM C.O. NO.1
2	9-16-99	RM	REVISE SANITARY ALIGNMENT

1326 ENERGY PARK DRIVE
 ST. PAUL, MINNESOTA 55108
 (612) 644-4389

Howard R. Green Company
 CONSULTING ENGINEERS

CITY OF ELK RIVER
 EASTERN AREA
 PHASE I IMPROVEMENTS

STREET AND UTILITY IMPROVEMENTS
 TYLER STREET
 0+780 TO 0+940

SHEET NO.
C1-23