
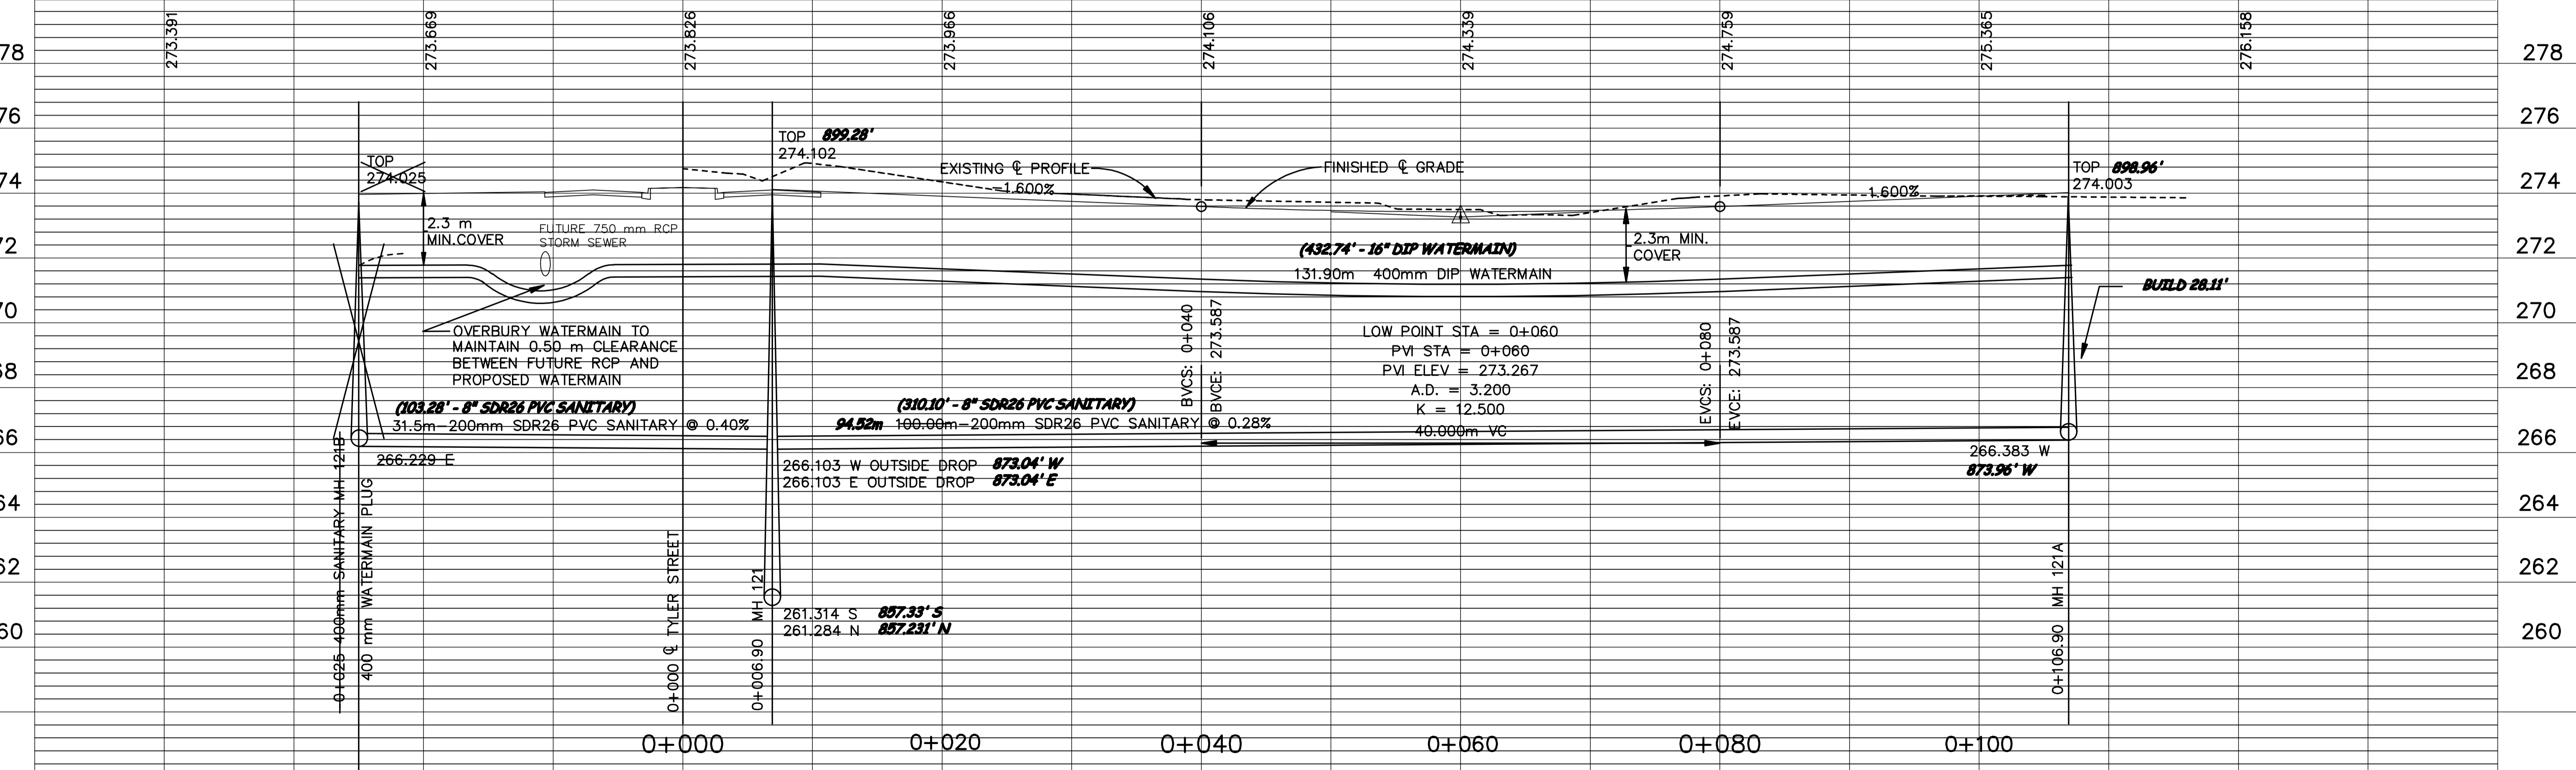
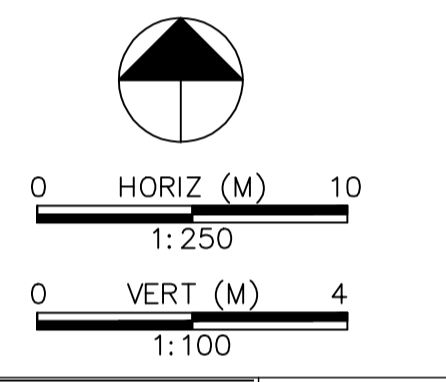


175TH AVENUE

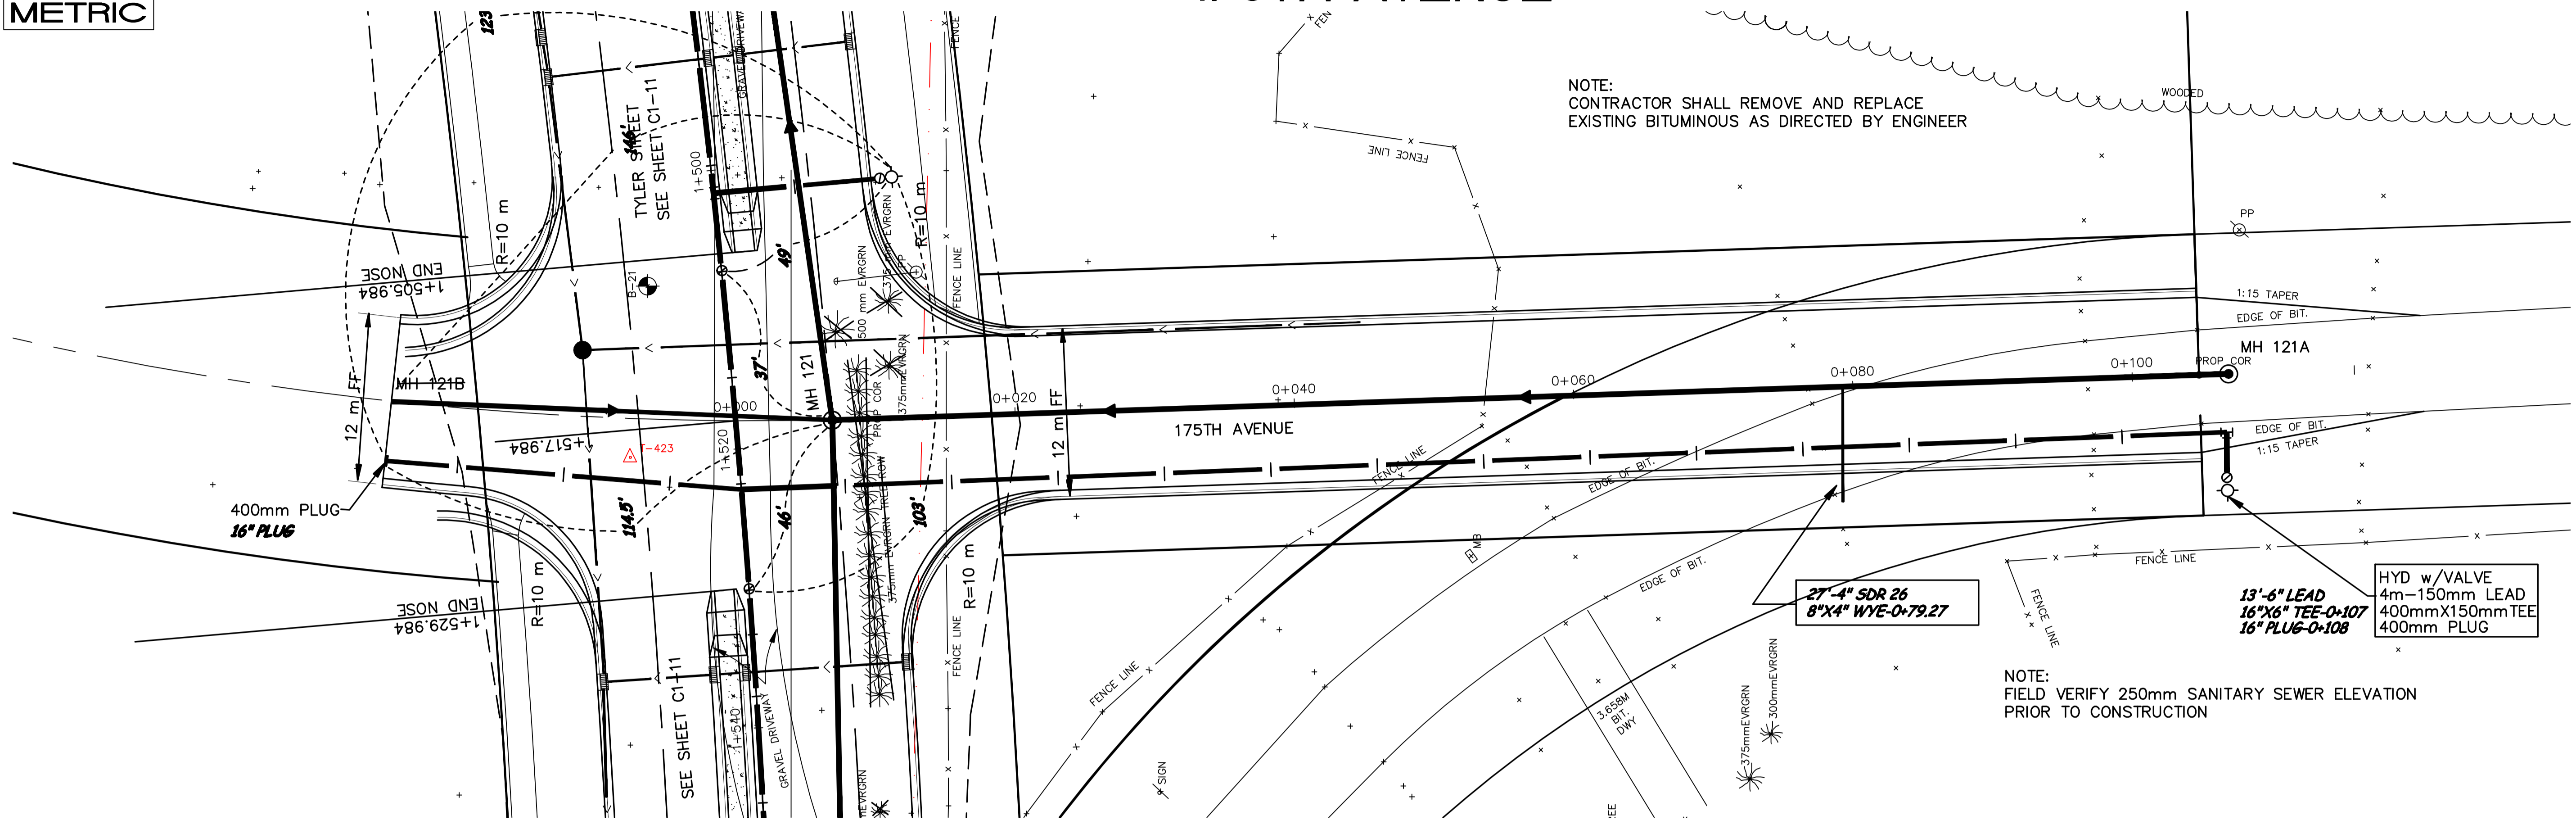

DESIGNED BY: AB JOB DATE: OCT1998
DRAWN BY: [Signature] JOB NUMBER: 800110J
APPROVED: [Signature] CAD DATE:
CAD FILE: October 09, 1998 7:34:17 a.m.
800110j\Draws\Tyler_BASE\17.DWG

I HEREBY CERTIFY THAT THIS PLAN, SPECIFICATION,
OR REPORT WAS PREPARED BY ME OR UNDER MY DIRECT
SUPERVISION AND THAT I AM A DULY REGISTERED
PROFESSIONAL ENGINEER UNDER THE LAWS OF THE
STATE OF MINNESOTA.

DATE 10/15/98 REG. NO. 15316

| NO. | DATE | BY | REVISION DESCRIPTION |
|-----|------|----|----------------------|
| | | | |

1326 ENERGY PARK DRIVE
ST. PAUL, MINNESOTA 55108
(612) 644-4389

Howard R. Green Company
CONSULTING ENGINEERS

CITY OF ELK RIVER
EASTERN AREA
PHASE I IMPROVEMENTS

STREET AND UTILITY IMPROVEMENTS
175TH AVENUE
0+000 TO 1+006.9

SHEET NO.
C1-24