
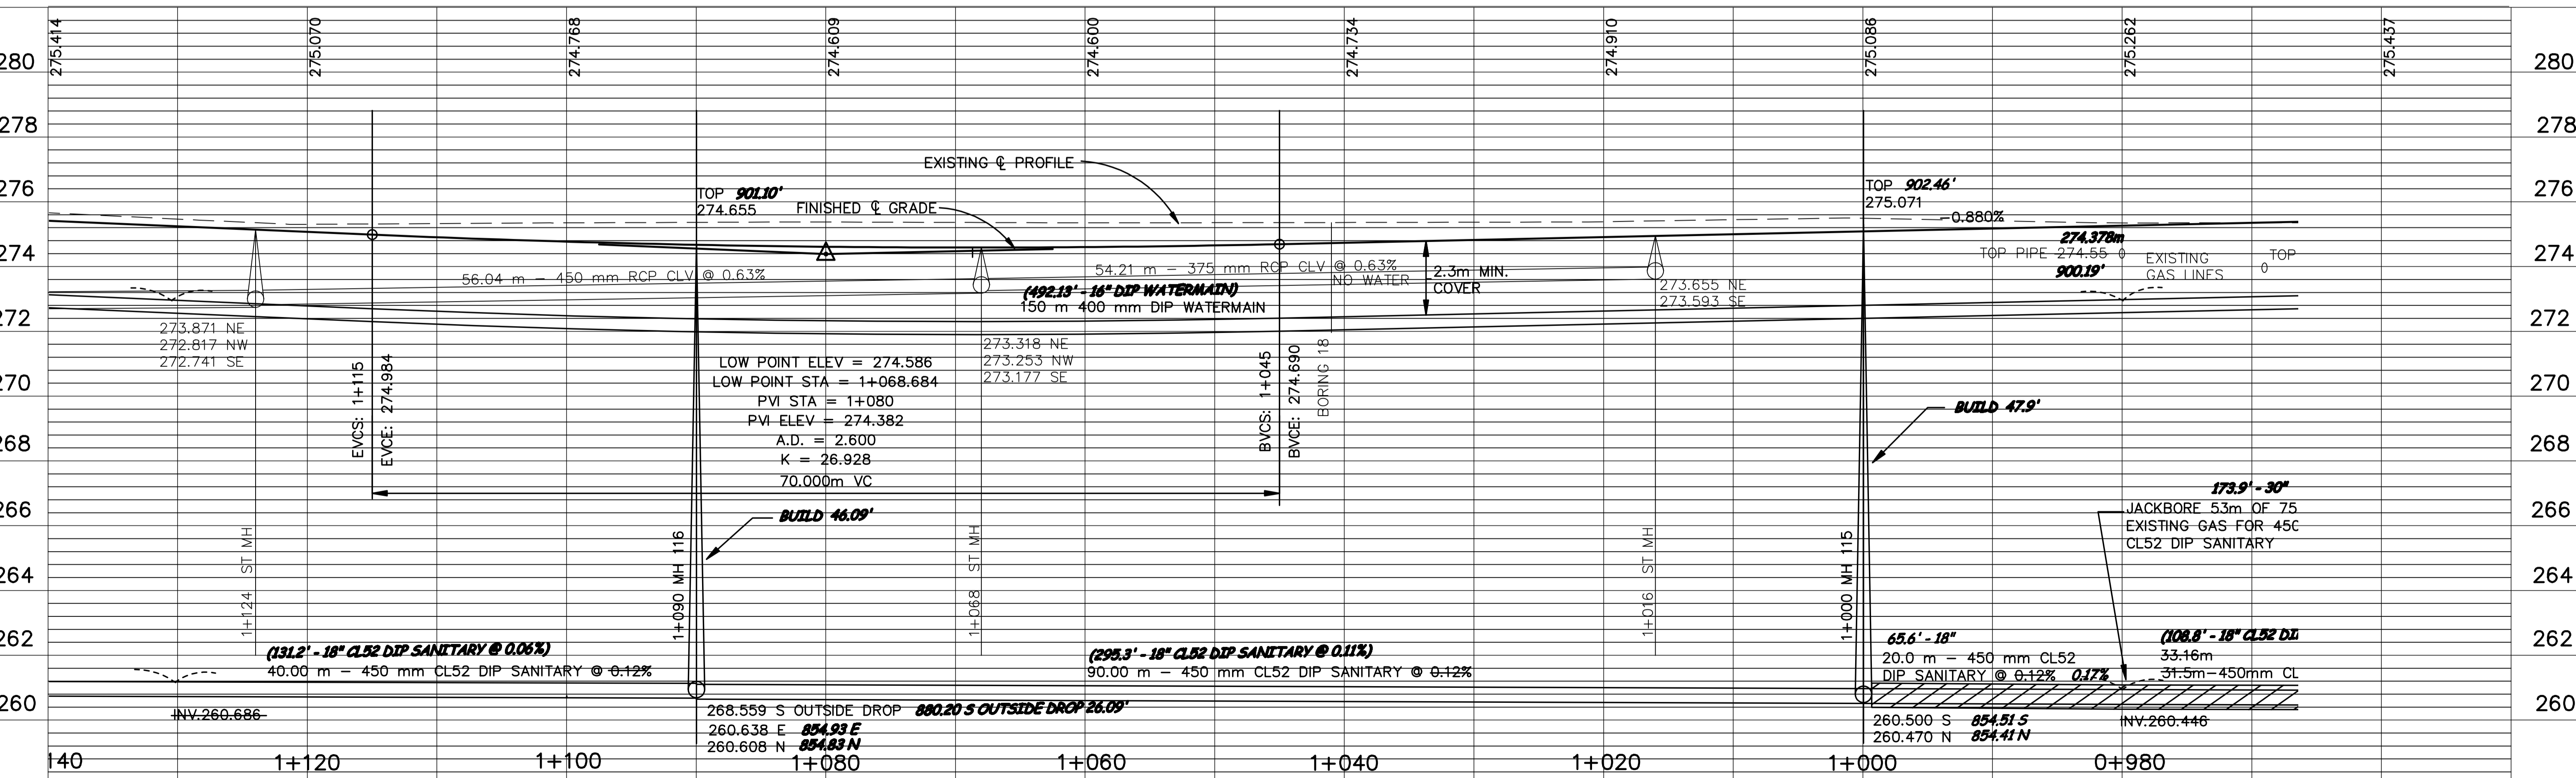


TYLER STREET

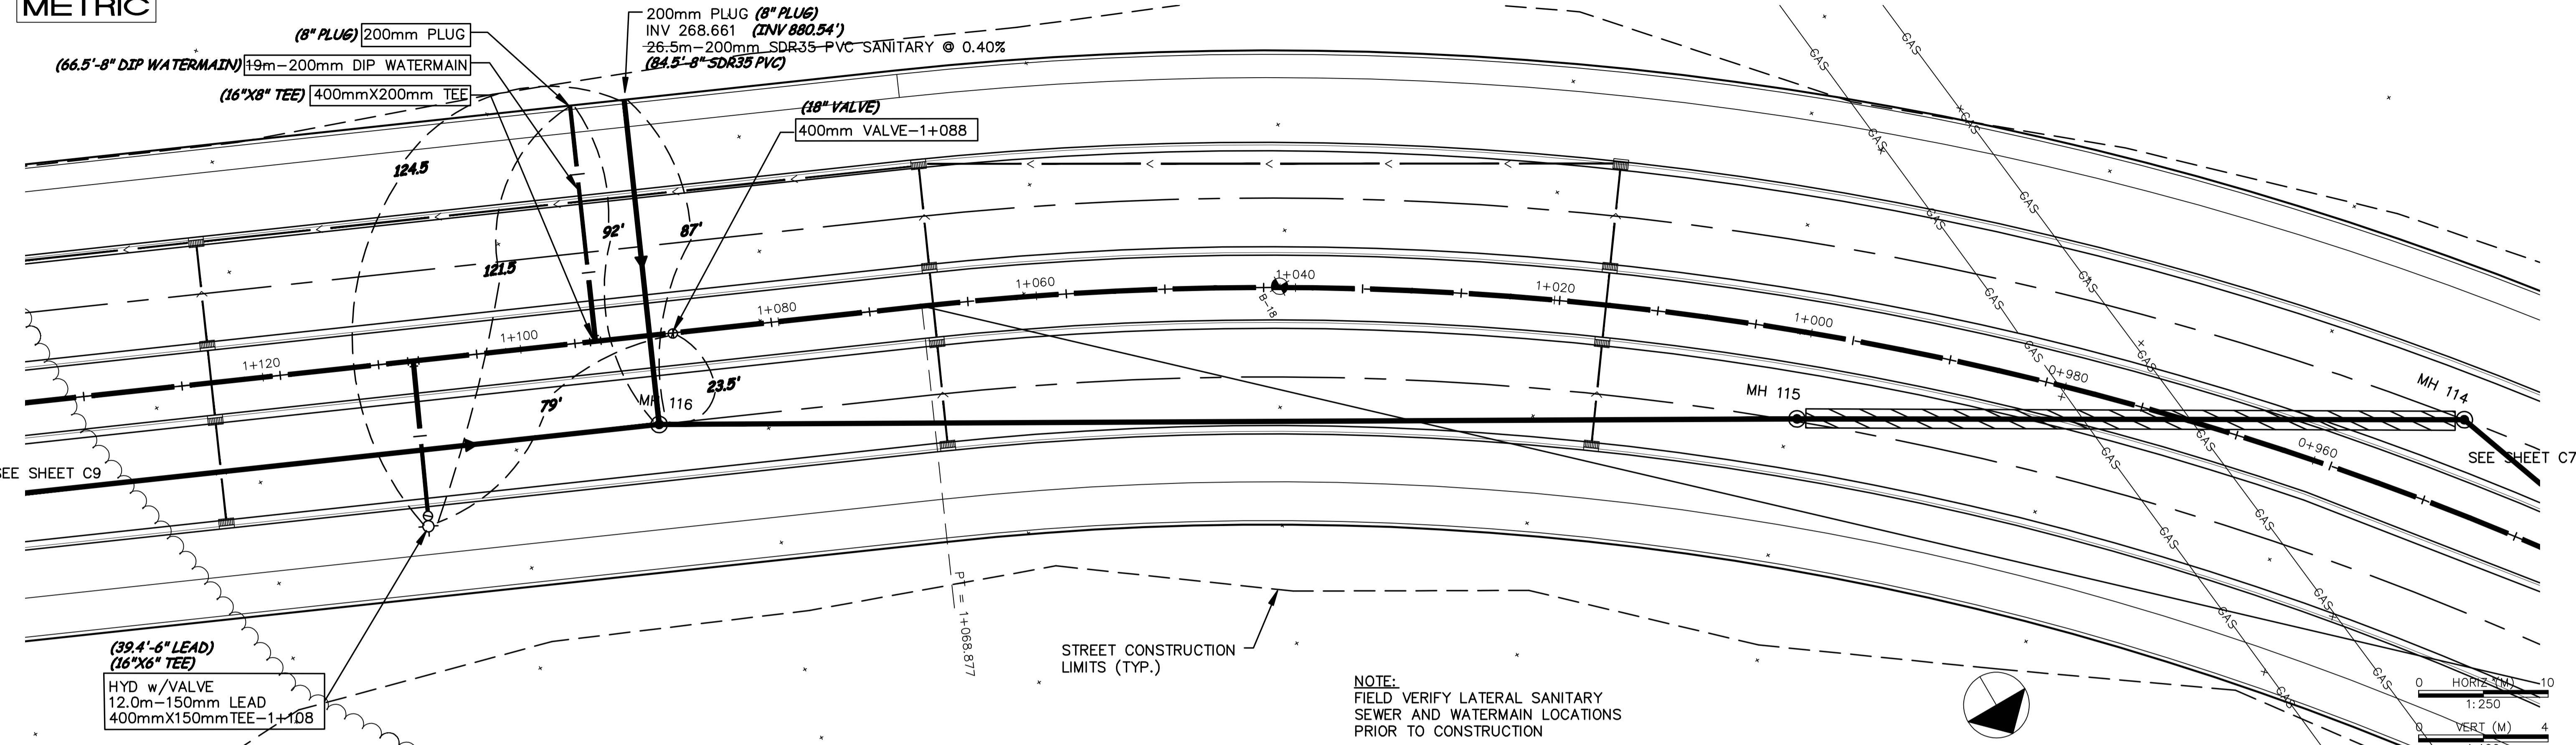

DESIGNED BY: AB JOB DATE: MARCH 1998
DRAWN BY: [Signature] JOB NUMBER: 800110J
APPROVED: [Signature] CAD DATE: [Signature]
CAD FILE: February 08, 1999 11:20:22 a.m.
800110j\Draws\Tyler_BASE\07.DWG

I HEREBY CERTIFY THAT THIS PLAN, SPECIFICATION,
OR REPORT WAS PREPARED BY ME OR UNDER MY DIRECT
SUPERVISION AND THAT I AM A DULY REGISTERED
PROFESSIONAL ENGINEER UNDER THE LAWS OF THE
STATE OF MINNESOTA.

DATE 10/15/98 REG. NO. 15316

NO.	DATE	BY	REVISION DESCRIPTION
1	1-21-99	PH	DELETED MH 116A

1326 ENERGY PARK DRIVE
ST. PAUL, MINNESOTA 55108
(612) 644-4389

Howard R. Green Company
CONSULTING ENGINEERS

CITY OF ELK RIVER
EASTERN AREA
PHASE I IMPROVEMENTS

STREET AND UTILITY IMPROVEMENTS
TYLER STREET
0+980 TO 1+130

SHEET NO.
C1-8