

- F&I:
- 1 EA 8"X6" TEE
 - 1 EA 6" GV & BOX
 - 1 EA HYDRANT
 - 63+20.24, 18.67' LT
 - G=892.85
 - 9 LF 6" WMN
 - 7.5'

402 2ND ST
 35' - 4" PVC SAN SERV
 25' - 1" COPPER WAT SERV
 1+05 WYE


200 FREEPPOINT AVE
 35' - 4" PVC SAN SERV
 21' - 1" COPPER WAT SERV
 3+41 WYE

324 2ND ST
 15' - 4" PVC SAN SERV
 24' - 1" COPPER WAT SERV
 2+85 WYE

401 2ND ST
 35' - 4" PVC SAN SERV
 25' - 1" COPPER WAT SERV
 1+05 WYE

329 2ND ST
 32' - 4" PVC SAN SERV
 43' - 1" COPPER WAT SERV
 2+90 WYE

323 2ND ST
 30' - 4" PVC SAN SERV
 42' - 1" COPPER WAT SERV
 2+56 WYE

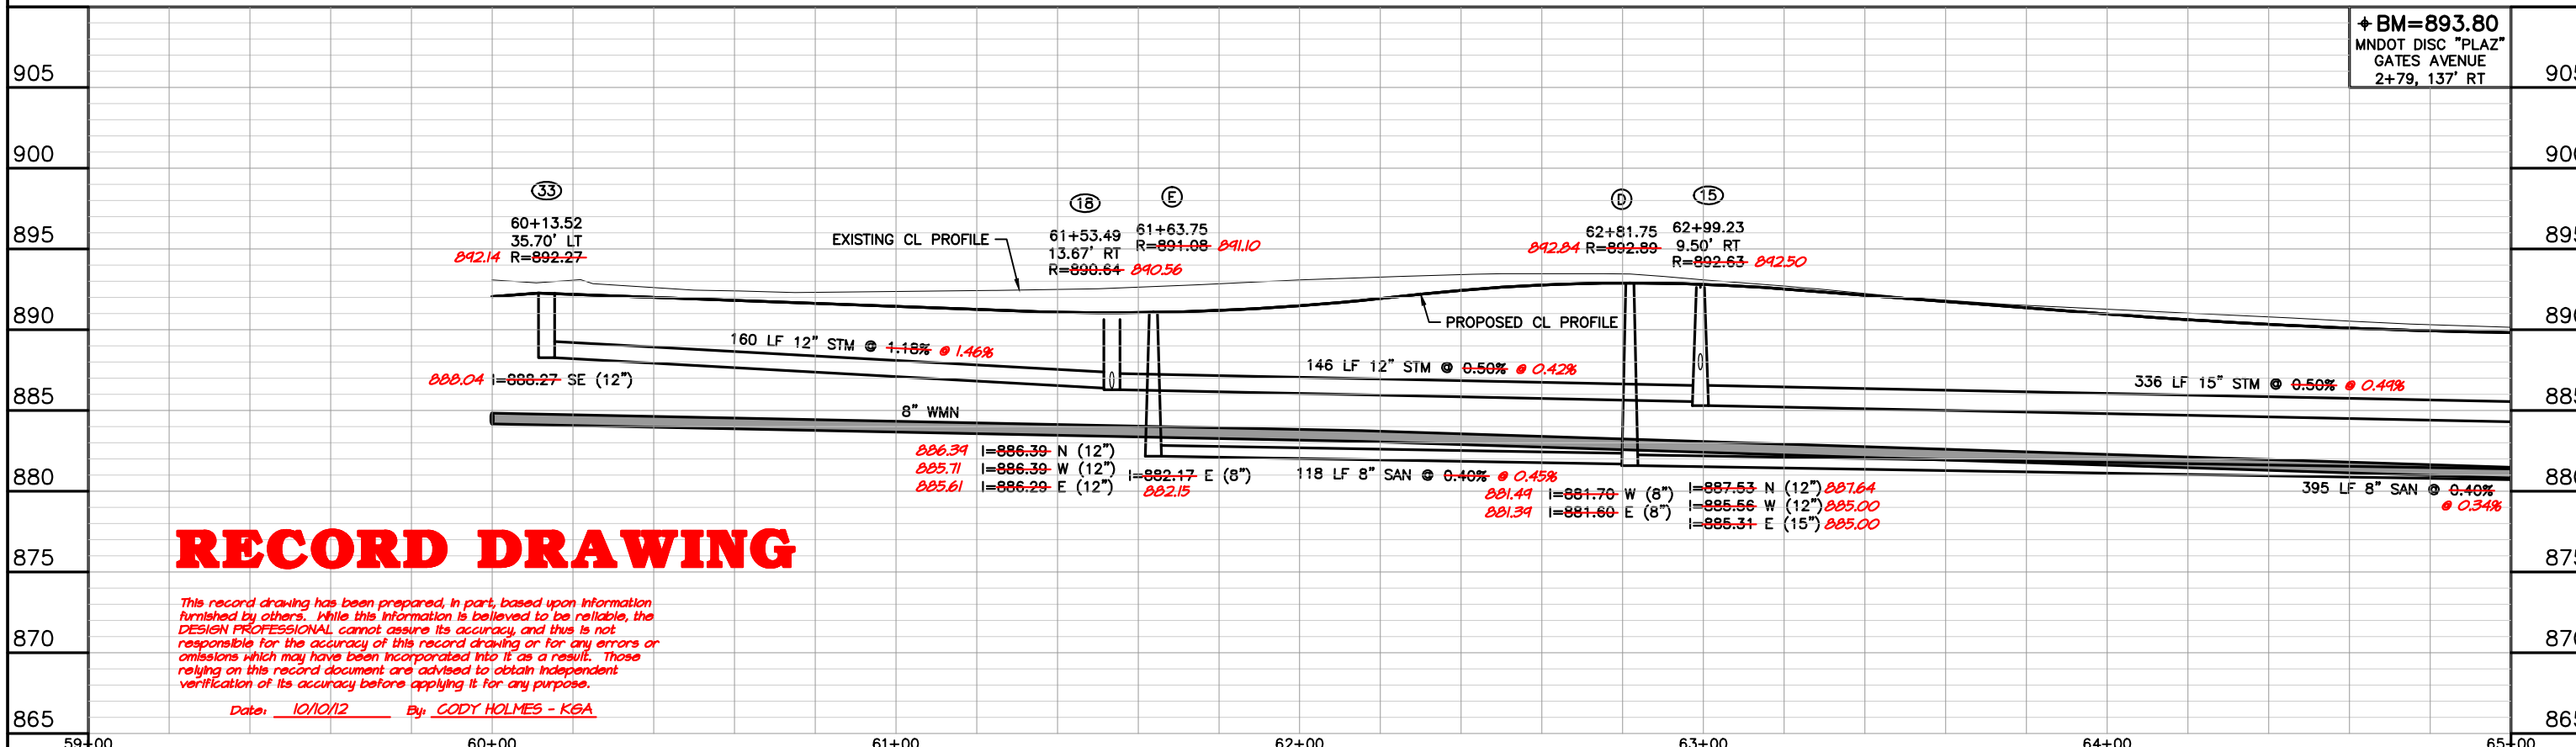

+ BM=893.80
 MNDOT DISC "PLAZ"
 GATES AVENUE
 2+79, 137' RT

RECORD DRAWING

This record drawing has been prepared, in part, based upon information furnished by others. While this information is believed to be reliable, the DESIGN PROFESSIONAL cannot assure its accuracy, and thus is not responsible for the accuracy of this record drawing or for any errors or omissions which may have been incorporated into it as a result. Those relying on this record document are advised to obtain independent verification of its accuracy before applying it for any purpose.

Date: 10/10/12 By: CODY HOLMES - KGA

<p>DESIGNED N. HUETTL</p> <p>DRAWN J. COOK</p> <p>CHECKED K. BITTNER</p>	<p>DESIGNED N. HUETTL</p> <p>DRAWN J. COOK</p> <p>CHECKED K. BITTNER</p>	<p>DATE 6/8/2011</p>	<p>REV. BY DATE</p>	<p>CITY OF ELK RIVER, MINNESOTA</p> <p>2011 STREET IMPROVEMENTS</p> <p>2ND STREET NW - UTILITY PLAN</p> <p>60+00 - 65+00</p>	<p>SHEET 15.1</p>
--	--	--------------------------	---------------------	--	-----------------------