
Zane Street & 179th Avenue N.W. Elk River Crossing

Elk River, Minnesota

Presented by:

Associated Developers

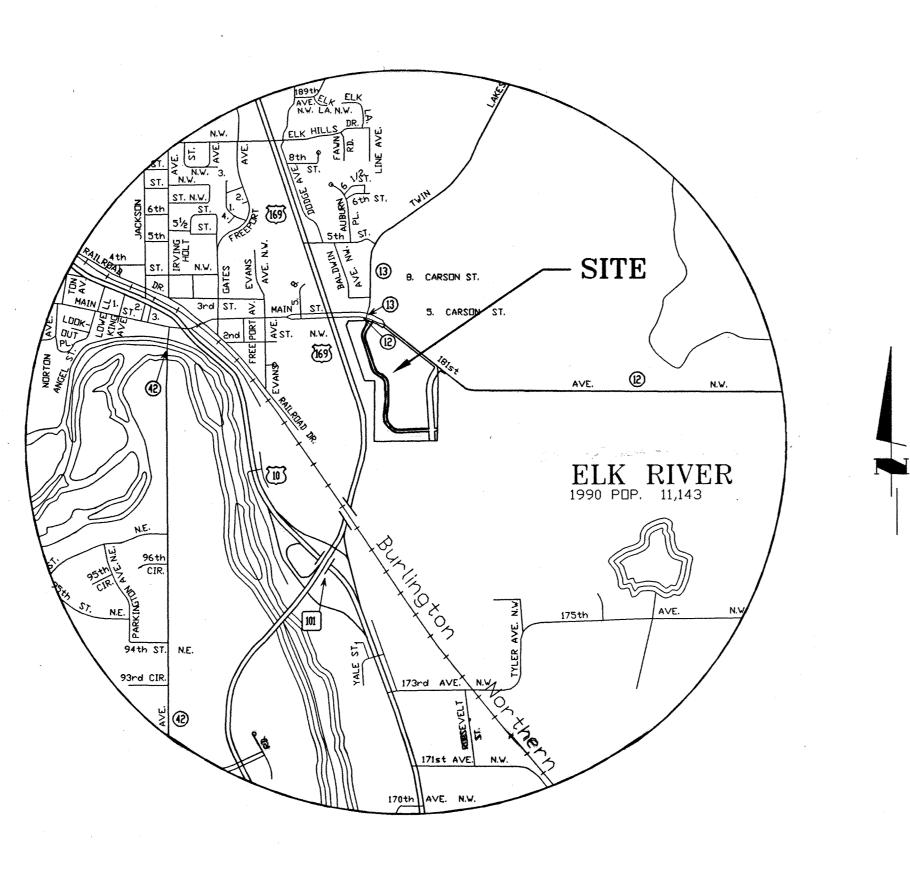

LOCATION MAP

CAUTION NOTES:

THE CONTRACTOR IS SPECIFICALLY CAUTIONED THAT THE LOCATION AND/OR ELEVATION OF EXISTING UTILITIES AS SHOWN ON THESE PLANS IS BASED ON RECORDS OF THE VARIOUS UTILITY COMPANIES AND, WHERE POSSIBLE, MEASUREMENTS TAKEN IN THE FIELD. THE INFORMATION IS NOT TO BE RELIED ON AS BEING EXACT OR

THE CONTRACTOR MUST CONTACT ALL THE APPROPRIATE UTILITY COMPANIES AT LEAST 48 HOURS BEFORE ANY EXCAVATION TO COMPANIES AT LEAST 48 HOURS BEFORE ANY EXCAVATION TO REQUEST EXACT FIELD LOCATION OF UTILITIES. IT SHALL BE THE RESPONSIBILITY OF THE CONTRACTOR TO RELOCATE ALL EXISTING UTILITIES WHICH CONFLICT WITH THE PROPOSED IMPROVEMENTS SHOWN ON THE PLANS. THE LOCATIONS OF SMALL UTILITIES SHALL BE OBTAINED BY THE CONTRACTOR BY CALLING GOPHER STATE ONE CALL AT 612-454-0002

BENCHMARKS:

- BM #1: MNDOT BRASS DISC IN CONCRETE" POWER AZIMUTH MARK" SOUTHWEST QUADRANT HIGHWAY 169 AND COUNTY ROAD 12
- BENCHMARK ELEVATION = 902.23 BM #2: TNH NORTH SIDE OF COUNTY ROAD 12 EASTERLY OF DRIVEWAY TO SOUTHEAST OF "NORTHBOUND LIQUOR"

INDEX OF SHEETS

- Title Sheet
- Site Plan
- Street Plan and Profile
- Street Plan and Profile
- Street Plan and Profile
- Sanitary Sewer and Watermain Plan and Profile
- Sanitary Sewer and Watermain Plan and Profile
- Storm Sewer Plan and Profile
- Storm Sewer Plan and Profile
- Storm Sewer Plan and Profile
- Detail Sheet
- **Detail Sheet**
- 13 Detail Sheet

PLANNER/ENGINEER:

McCombs Frank Roos Associates, Inc. 15050 23rd Avenue North Plymouth, Minnesota 55447 Phone: (612) 476-6010 Fax: (612) 476-8532 Contact: Greg Frank Dave Nash

DEVELOPER:

Associated Developers 6801 West 150th Street Apple Valley, Minnesota 55124 Phone: (612) 339-7131 Fax: (612) 339-6591 Contact: Anthony J. Gleekel

RECORD PLAN **JUNE 2001**

Engineering • Planning • Surveying



Associated Developers

Apple Valley, MN

Elk River Crossing Elk River, MN

Sheet Title

Title Sheet

Checked DJN

8/2/99

EWM

Revisions No. Date By Remarks A 9/9/99 EWM Revised per city comment B |10/7/99 | EWM | Revised sheets 2-10 C |11/18/99 | EWM | Revised sheets 2-13 D |2/28/00 | EWM | Revised sheets 2-10 E 6/29/01 MRJ RECORD PLAN

Approved

Sheet

Revision

MFRA FILE NO.: 10667