


TYPICAL STREET SECTION
ZANE STREET & 179TH AVENUE N.W.

STORM SEWER STRUCTURE SCHEDULE

STRUCTURE NO.	STRUC. TYPE	CASTING*	SIZE/DIA. (IN)
CBMH 1	SLAB TOP	R-3067-V	84"
CBMH 2	SLAB TOP	R-3067-V	60"
CBMH 3	SLAB TOP	R-3067-V	60"
CBMH 4	SLAB TOP	R-3067-V	48"
CB 5	SLAB TOP	R-3067-V	48"
CB 6	SLAB TOP	R-3067-V	48"
CBMH 7	SLAB TOP	R-3067-V	48"
CBMH 8	SLAB TOP	R-3067-V	48"
CB 9	SLAB TOP	R-3067-V	48"
CBMH 10	SLAB TOP	R-3067-V	96"
CBMH 11	SLAB TOP	R-3067-V	60"
CBMH 12	SLAB TOP	R-3067-V	84"
CBMH 13	SLAB TOP	R-3067-V	84"
CBMH 14	SLAB TOP	R-3067-V	48"
CBMH 15	SLAB TOP	R-3067-V	48"
CB 16	CATCH BASIN	R-3067-V	24" x 36"
CBMH 17	SLAB TOP	R-3067-V	48"
CBMH 18	SLAB TOP	R-3067-V	60"
CBMH 19	SLAB TOP	R-3067-V	48"
CBMH 20	SLAB TOP	R-3067-V	48"
CB 21	CATCH BASIN	R-3067-V	24" x 36"
STMH 22	SLAB TOP	R-1733	48"

* INDICATES NEENAH FOUNDARY CASTING NO., OR APPROVED EQUAL.

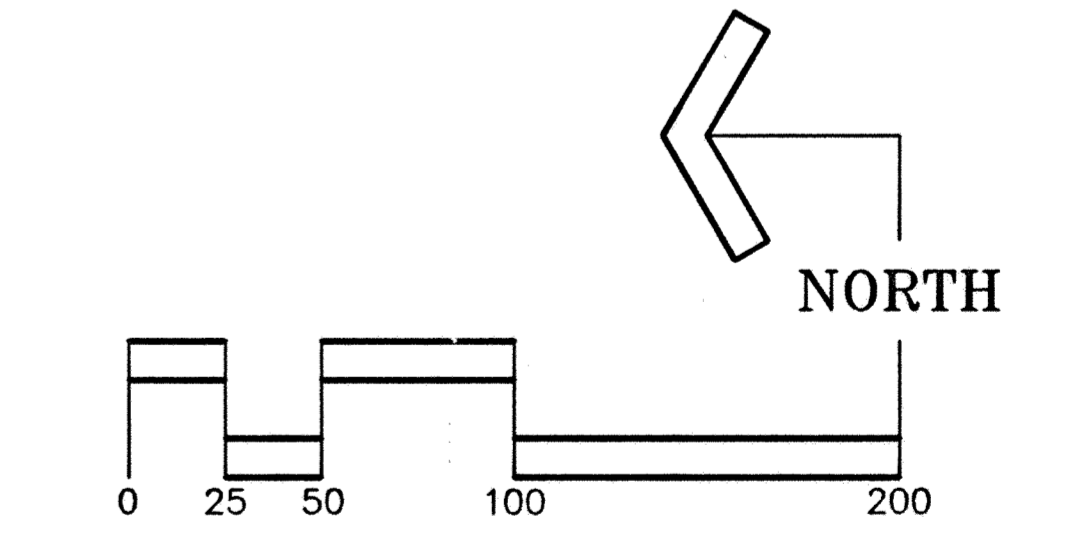

**SITE WORK FOR ELK RIVER CROSSING INCLUDES ZANE STREET, 179TH AVENUE NW, STORM DETENTION PONDS AND POND OUTLET PIPES ONLY. ADJACENT LOT SITE PLANS SHOWN ARE PRELIMINARY ONLY AND NOT INCLUDED IN THIS PROJECT.

RECORD PLAN
JUNE 2001

Revisions

No.	Date	By	Remarks
A	9/9/99	EWM	Revised per city comment
B	10/7/99	EWM	Revised Storm sewer structure schedule
C	11/18/99	EWM	Revised per city comment
D	2/28/00	EWM	Miscellaneous revisions
E	6/29/01	MRJ	RECORD PLAN

I hereby certify that this plan was prepared by me or under my direct supervision and that I am a duly Registered Professional Engineer under the laws of the State of Minnesota.

Name David J. Nash David J. Nash
Date 9/9/99
Registration Number 21836

Scale 1"=100'
Designed EWM
Drawn EWM
Date 8/2/99
Checked DJN
Approved



Engineering • Planning • Surveying
15050 23rd Avenue North • Plymouth, Minnesota • 55447
phone 612/476-6010 • fax 612/476-8532
E-Mail: cadd@mfra.com

Client
Associated Developers
Apple Valley, MN

Project
Elk River Crossing
Elk River, MN

Sheet Title
Site Plan

Sheet 2 / 13
Revision E
MFRA FILE NO.: 10667