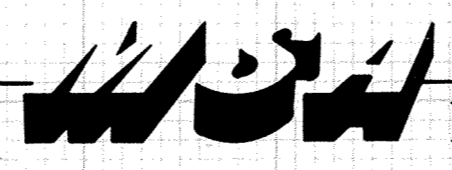


RECORD PLAN NOV 1987

 <b>CONSULTING ENGINEERS</b> <b>Maier Stewart &amp; Associates Inc.</b> 480 CEDAR STREET    (612)227-9475    ST. PAUL, MINNESOTA 55101	DATE	DESCRIPTION	DESIGNED	<b>CITY OF ELK RIVER</b> <b>ELK RIVER INDUSTRIAL PARK</b> <b>LOCATION MAP</b> DATE <u>JAN. 1987</u> SHEET <u>3</u> OF <u>17</u> SHEETS    PROJECT NO. <u>230-002</u>
			CHECKED	
			DRAWN <u>MRJ</u>	
			GRAPHIC SCALE	
REVISIONS			0 HORIZ. 1/30	
			0 VERT.	