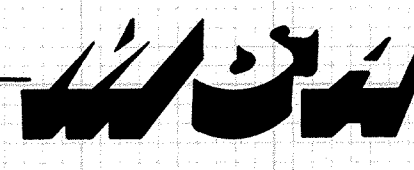


NOTE: CONTRACTOR TO KEEP ALL EQUIPMENT OFF GAS COMPANY EASEMENT

LEGEND:
 ---916--- EXISTING CONTOURS
 —918— PROPOSED CONTOURS

RECORD PLAN NOV 1987

 Maier Stewart & Associates Inc. CONSULTING ENGINEERS 480 CEDAR STREET (612)227-9475 ST. PAUL, MINNESOTA 55101	DATE	DESCRIPTION	DESIGNED	CITY OF ELK RIVER ELK RIVER INDUSTRIAL PARK PHASE II GRADING PLAN DATE JAN 1987 SHEET 4 OF 17 SHEETS PROJECT NO. 230-002
			CHECKED	
			DRAWN MRJ	
			GRAPHIC SCALE 0 HORIZ. 100 0 VERT.	