
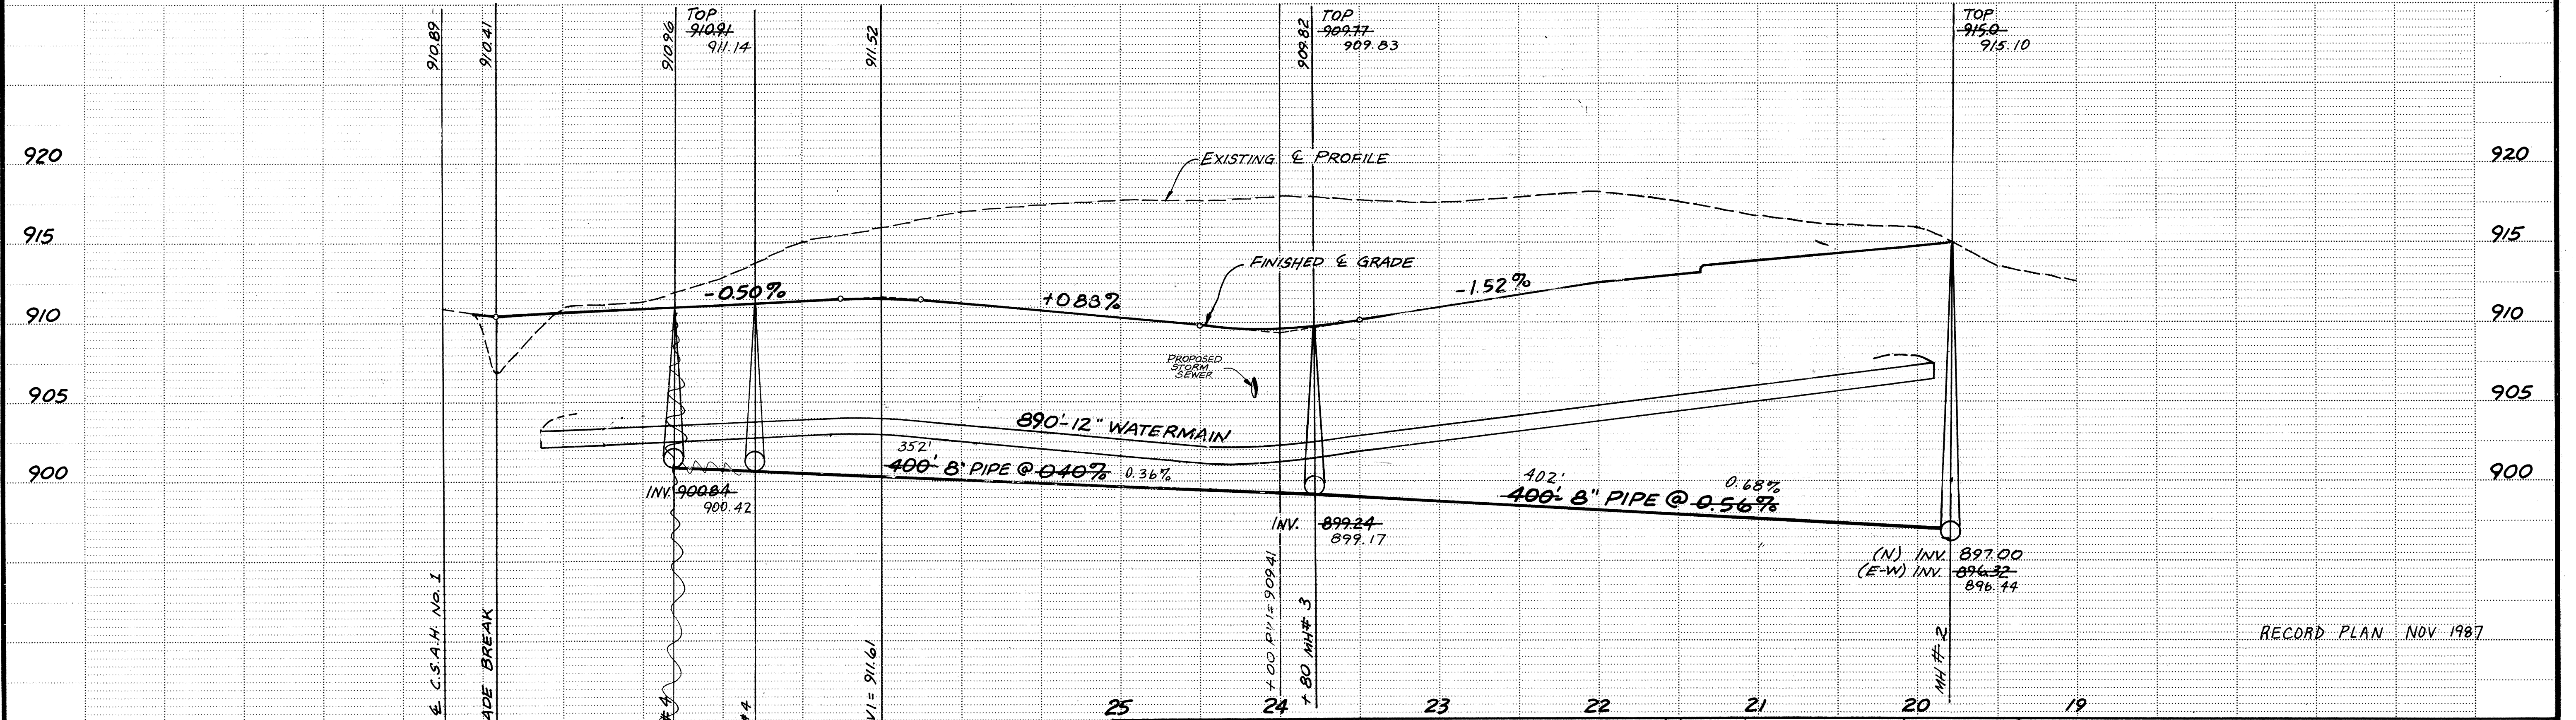


INDUSTRIAL BOULEVARD

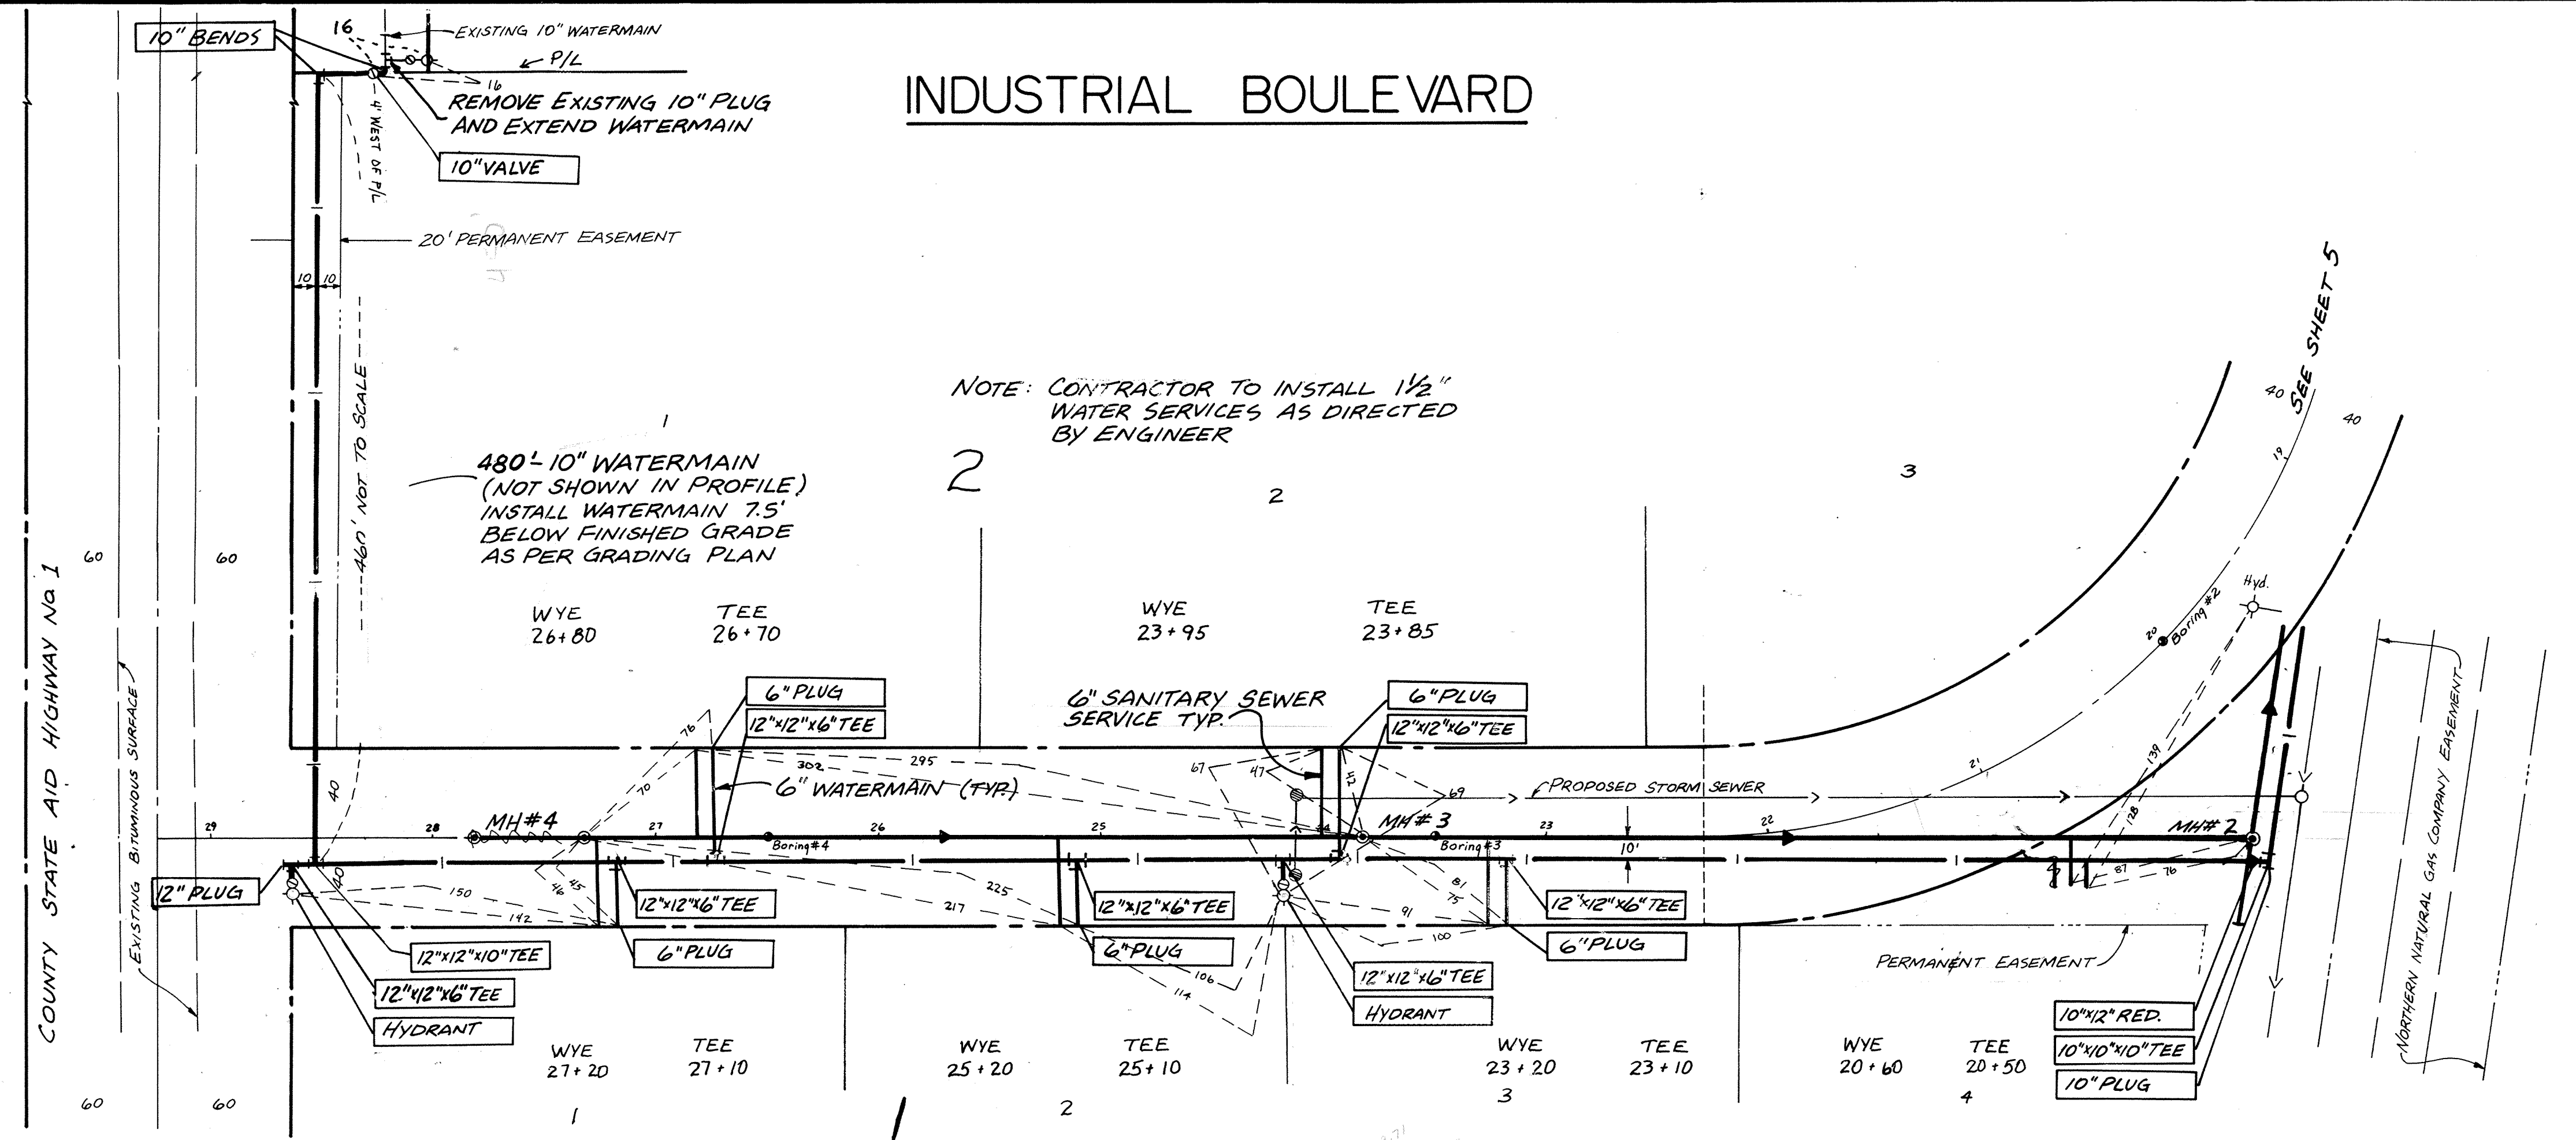

<p>CONSULTING ENGINEERS Maier Stewart & Associates Inc. 480 CEDAR STREET (612)227-9475 ST. PAUL, MINNESOTA 55101</p>	<p>DATE 2/24/87</p>	<p>DESCRIPTION WM along Hwy#1</p>	<p>DESIGNED _____</p> <p>CHECKED _____</p> <p>DRAWN MSJ</p> <p>GRAPHIC SCALE 0 HORIZ. 50 0 VERT. 5</p>	<p>CITY OF ELK RIVER SANITARY SEWER AND WATERMAIN INDUSTRIAL BOULEVARD</p>
	<p>REVISIONS</p>	<p>DATE JAN 1987</p>	<p>SHEET 6 OF 17 SHEETS</p>	<p>PROJECT NO. 230-002</p>