
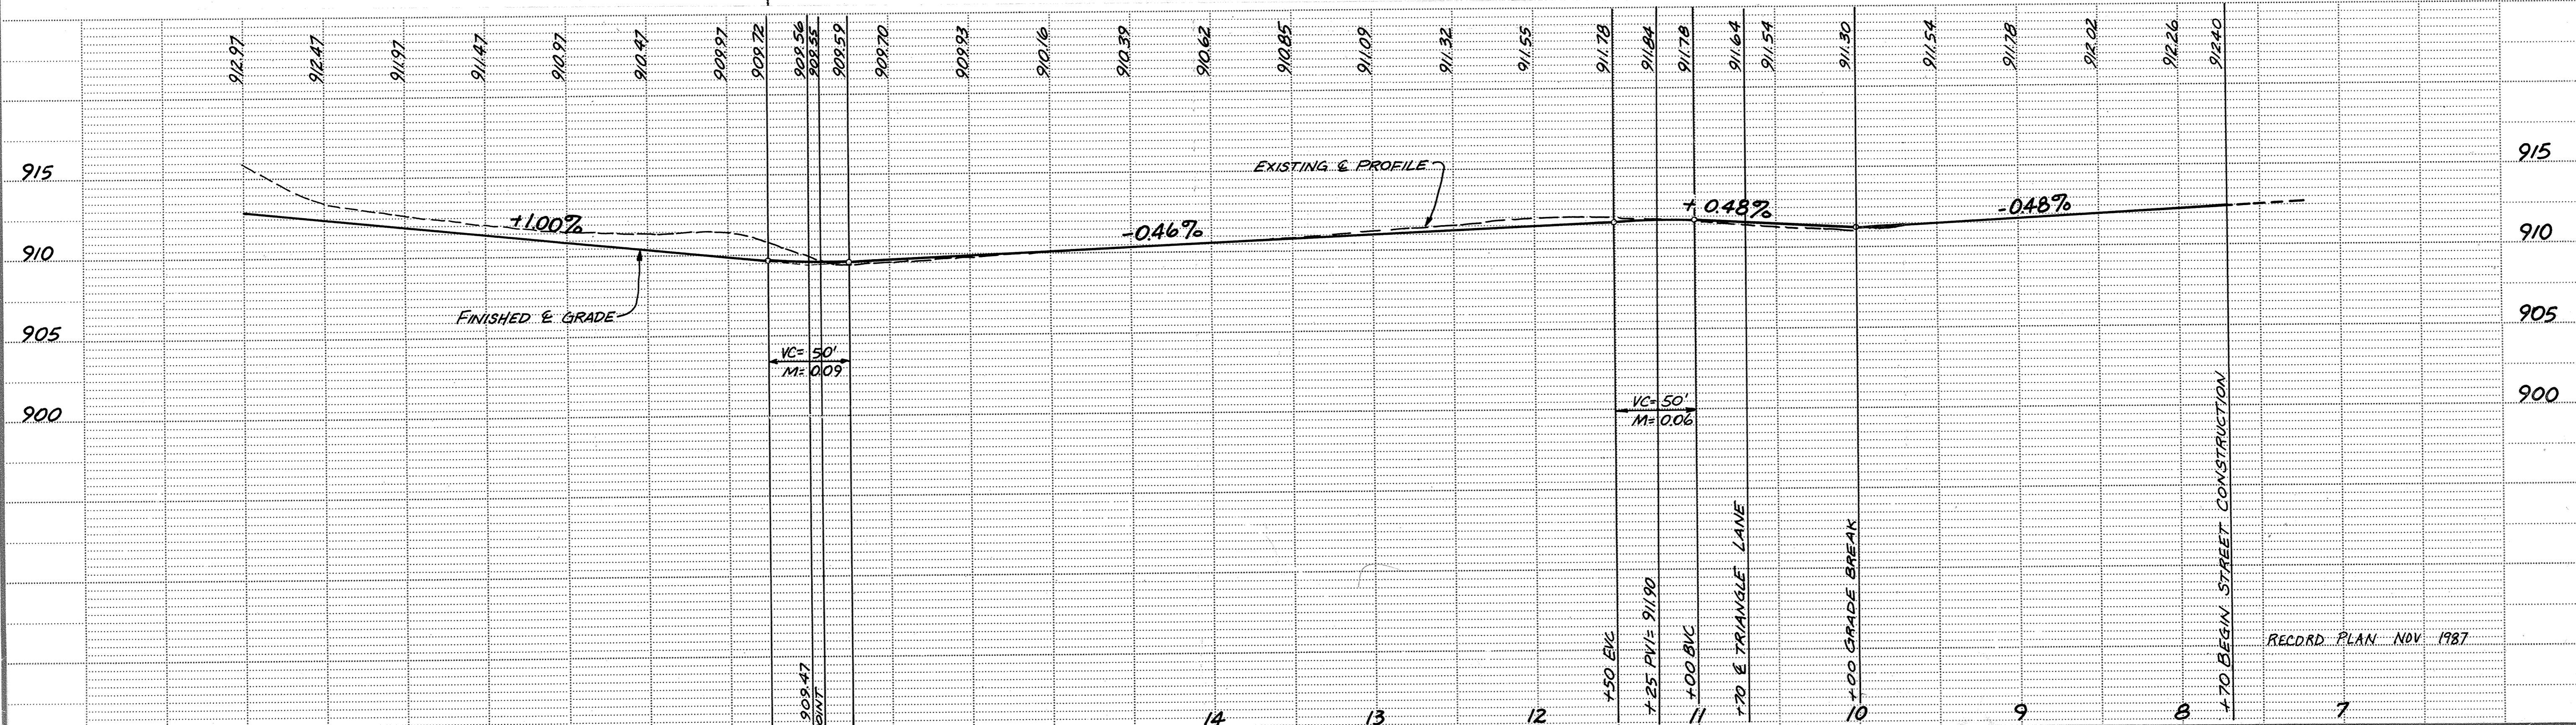


# INDUSTRIAL BOULEVARD

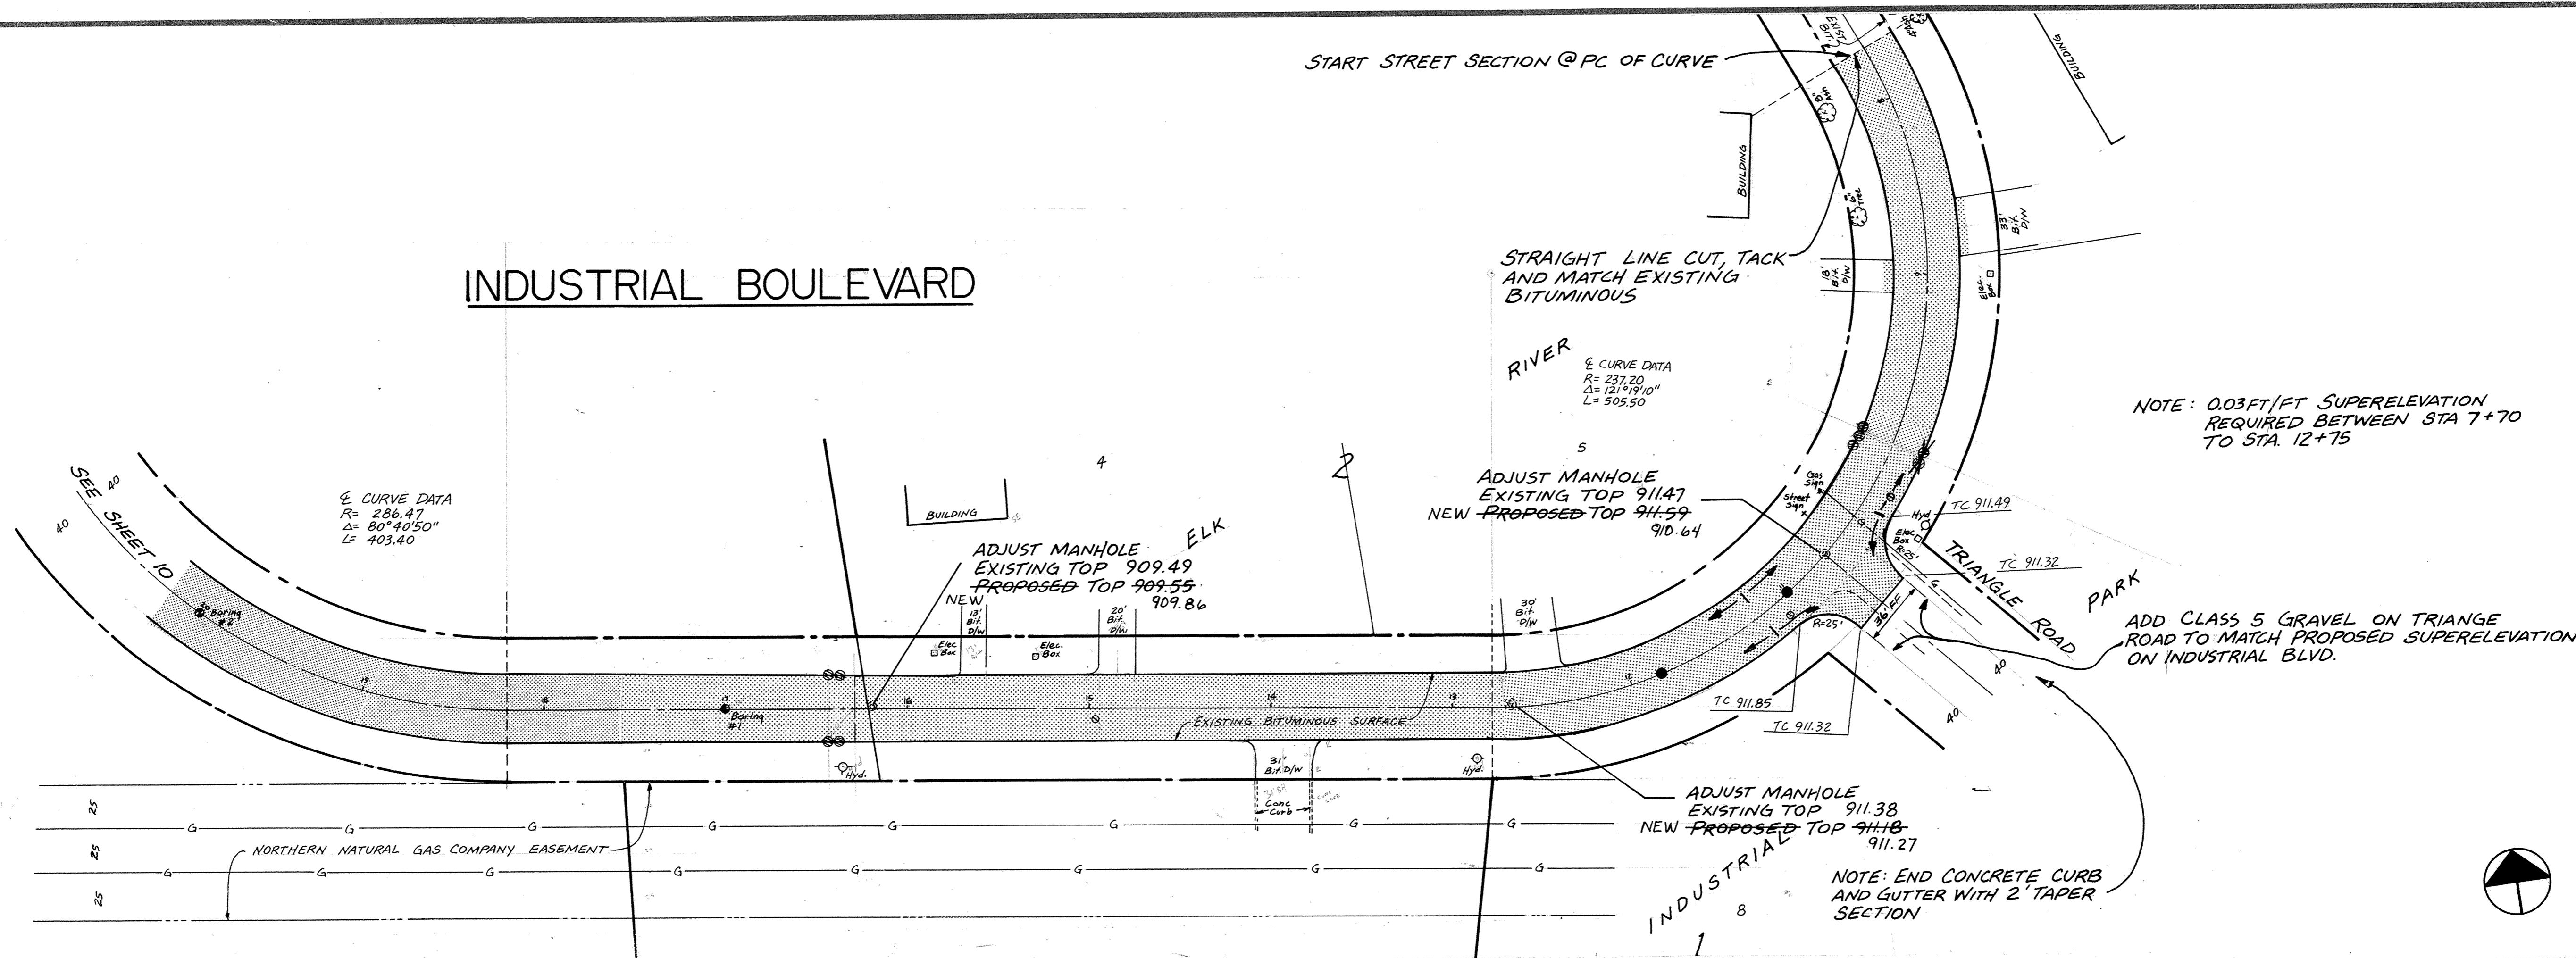

<b>Maier Stewart &amp; Associates Inc.</b> CONSULTING ENGINEERS 480 CEDAR STREET (612)227-9475 ST. PAUL, MINNESOTA 55101		DATE 2/24/87 DESCRIPTION Begin Sta 8+70, Superlevation Note DESIGN ID CHECKED DRAWN MRI GRAPHIC SCALE 1" = 50' HORIZ. 5" VERT.	<b>CITY OF ELK RIVER</b> STREET CONSTRUCTION SAP 204-125-01 INDUSTRIAL BOULEVARD DATE JAN 1987 SHEET 9 OF 17 SHEETS PROJECT NO. 230-002
--	--	--	---

SDCO PRODUCTS • NEW HAVEN, CONNECTICUT  
 REPRODUCED BY PART NUMBER 6533  
 SDCO PRODUCTS • NEW HAVEN, CONNECTICUT  
 REPRODUCED BY PART NUMBER 6533  
 SDCO PRODUCTS • NEW HAVEN, CONNECTICUT  
 REPRODUCED BY PART NUMBER 6533  
 SDCO PRODUCTS • NEW HAVEN, CONNECTICUT  
 REPRODUCED BY PART NUMBER 6533