



# INDUSTRIAL BOULEVARD

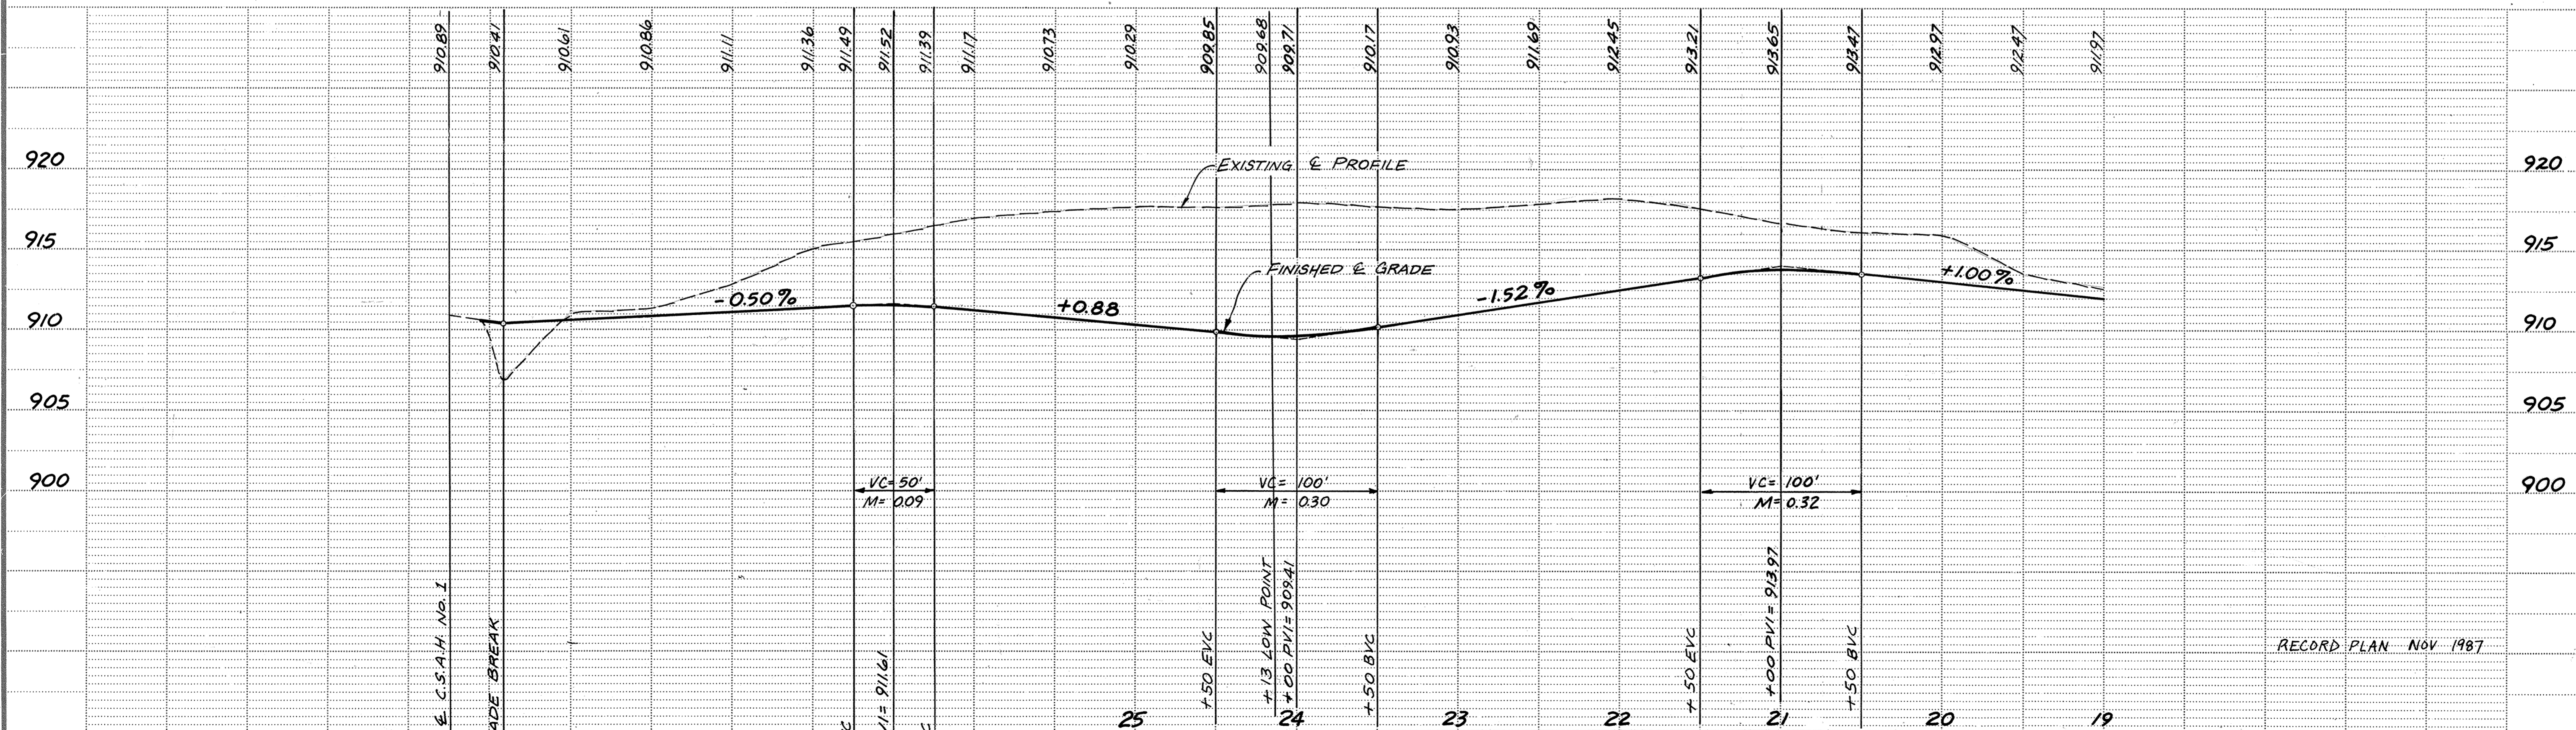

RECORD PLAN NOV 1987

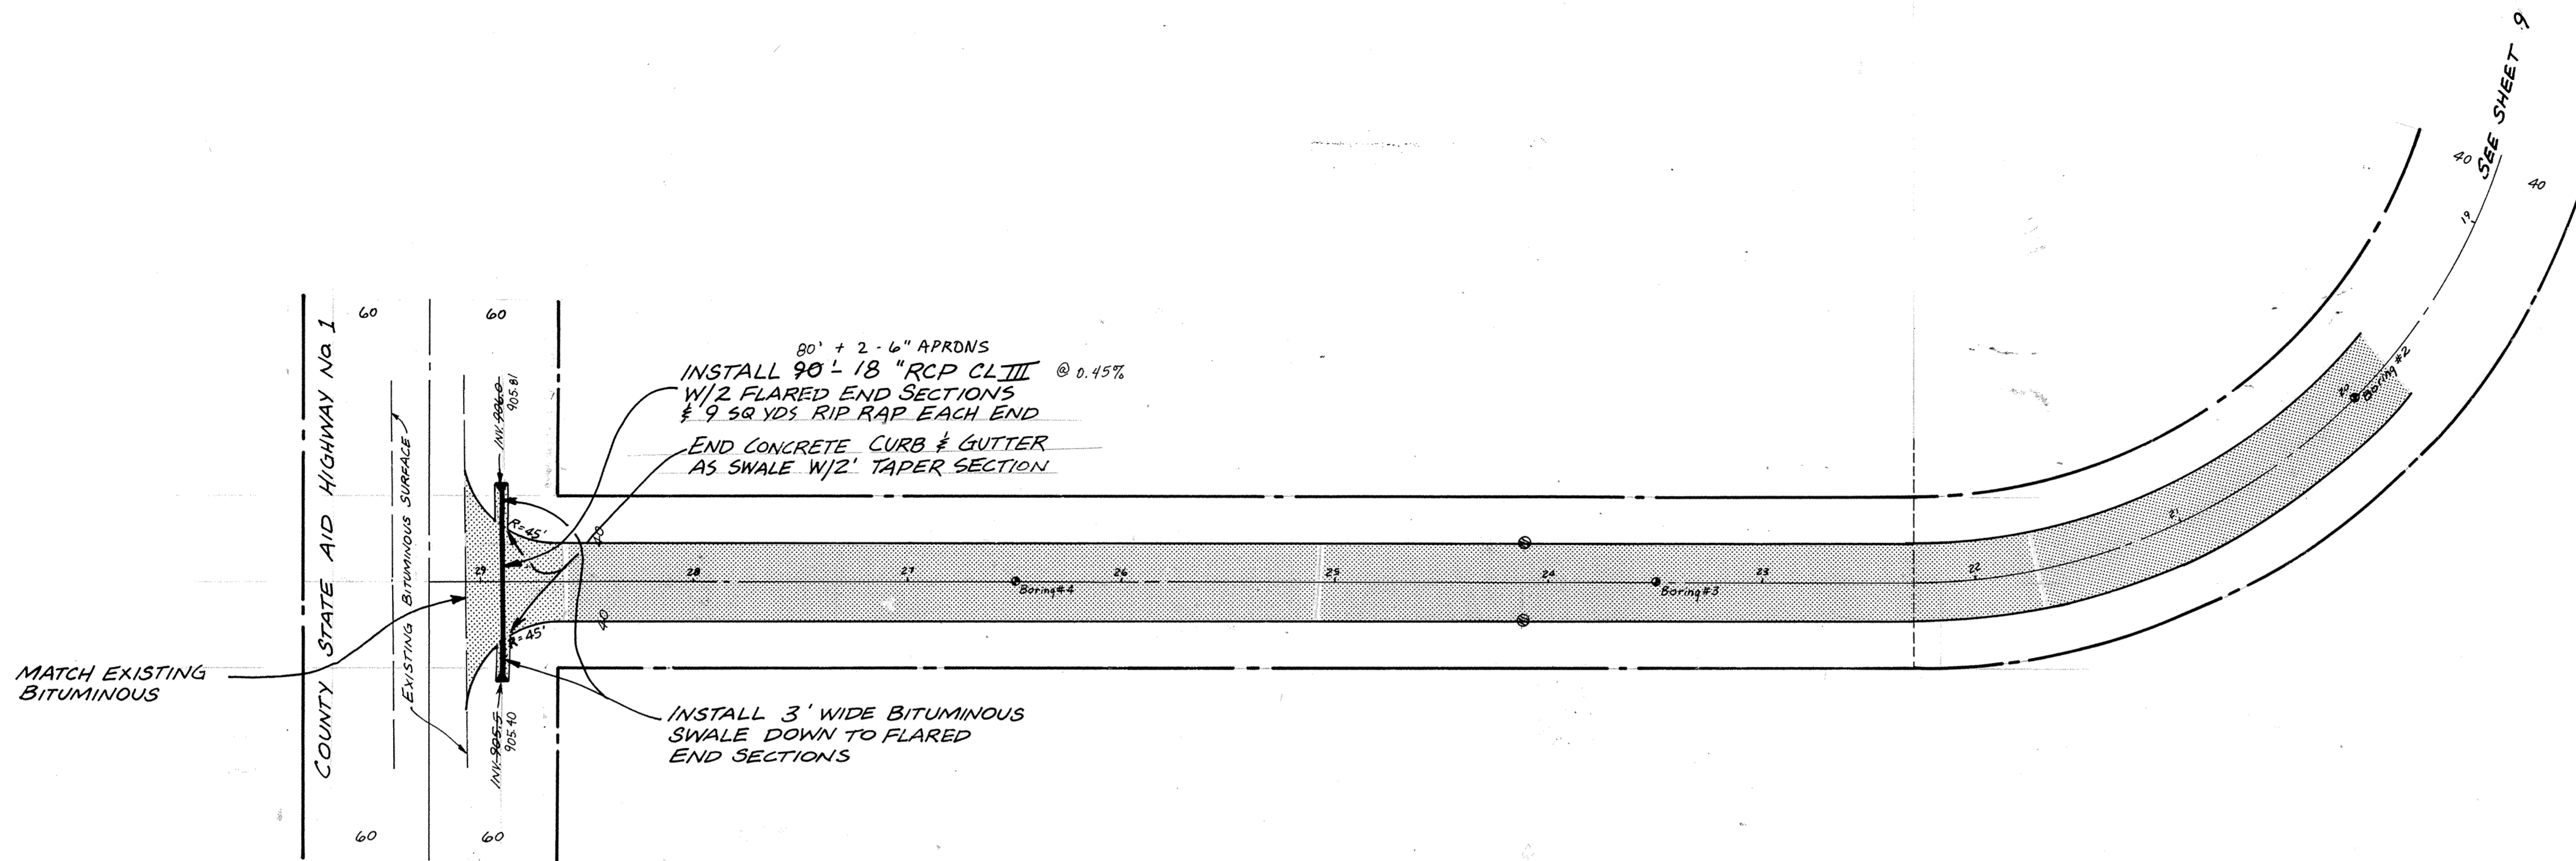

CONSULTING ENGINEERS  
**Maier Stewart & Associates Inc.**

480 CEDAR STREET (612)227-9475 ST. PAUL, MINNESOTA 55101

| DATE | DESCRIPTION |
|------|-------------|
|      |             |
|      |             |
|      |             |

|               |            |
|---------------|------------|
| DESIGNED      |            |
| CHECKED       |            |
| DRAWN         | MRJ        |
| GRAPHIC SCALE |            |
|               | HORIZ. 50' |
|               | VERT. 5'   |

**CITY OF ELK RIVER**  
 STREET CONSTRUCTION  
 SAP 204-125-01  
 INDUSTRIAL BOULEVARD

DATE JAN 1987 SHEET 10 OF 17 SHEETS PROJECT NO. 230-002

DRAWING NUMBER  
 ERIND 87  
 10  
 186