
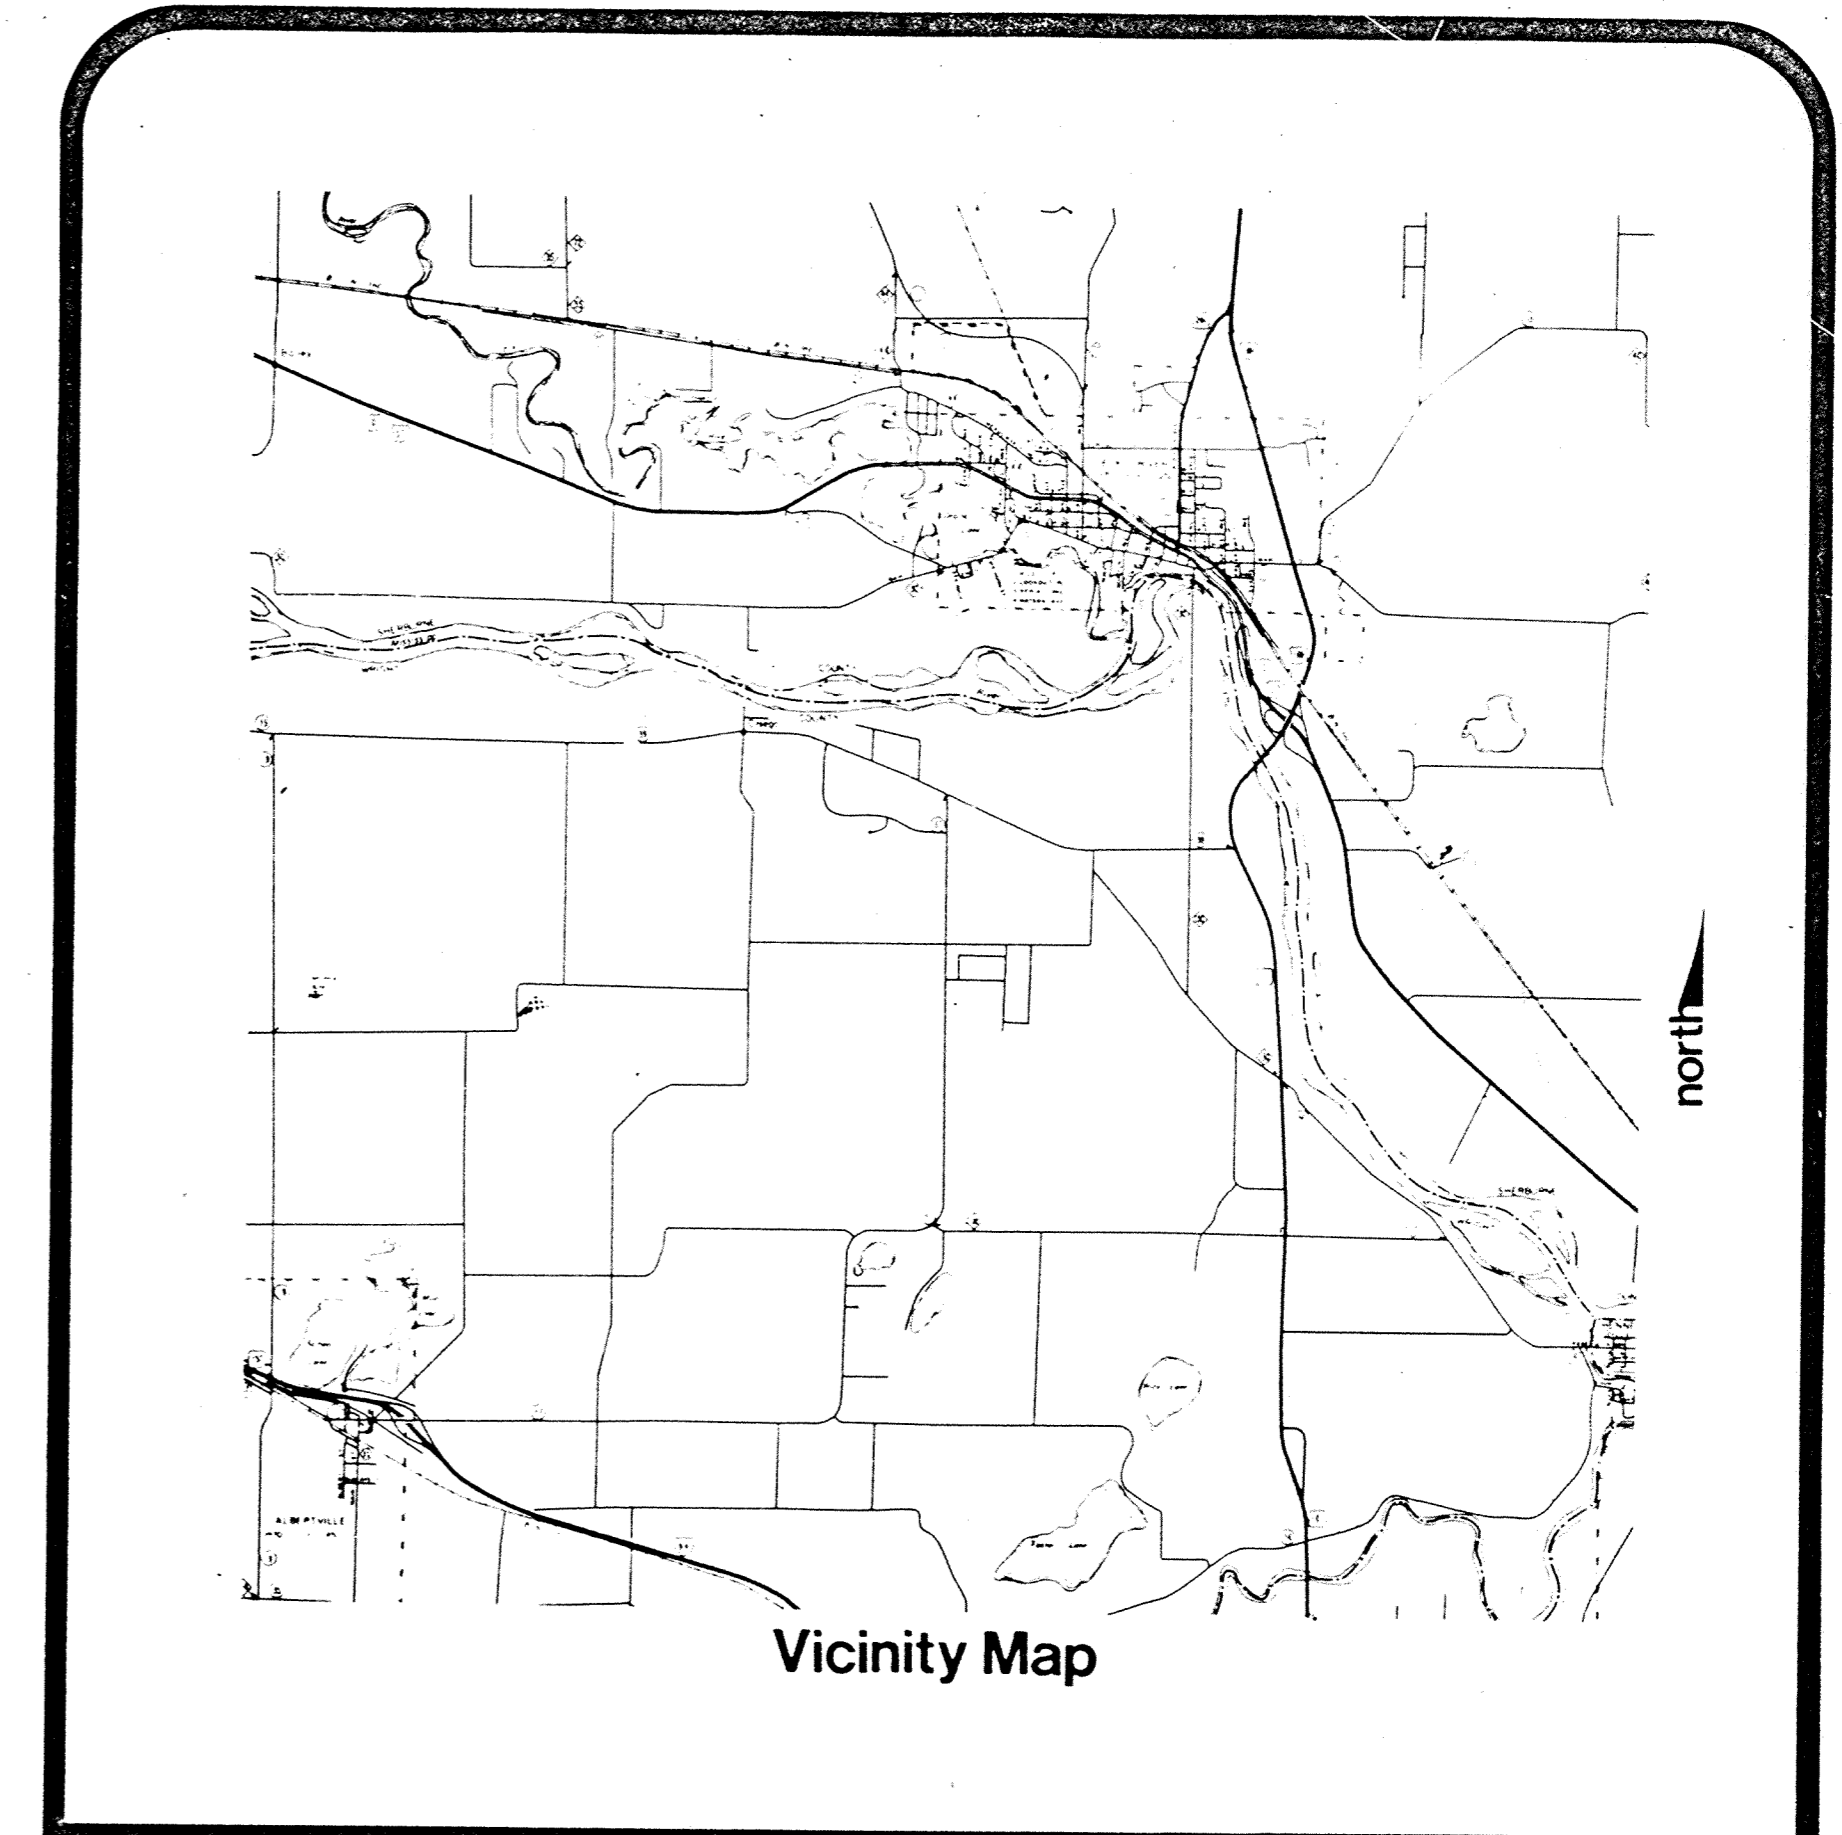


TRUNK WATERMAIN IMPROVEMENT ELK RIVER PLAZA PUD TO BARRINGTON PLACE

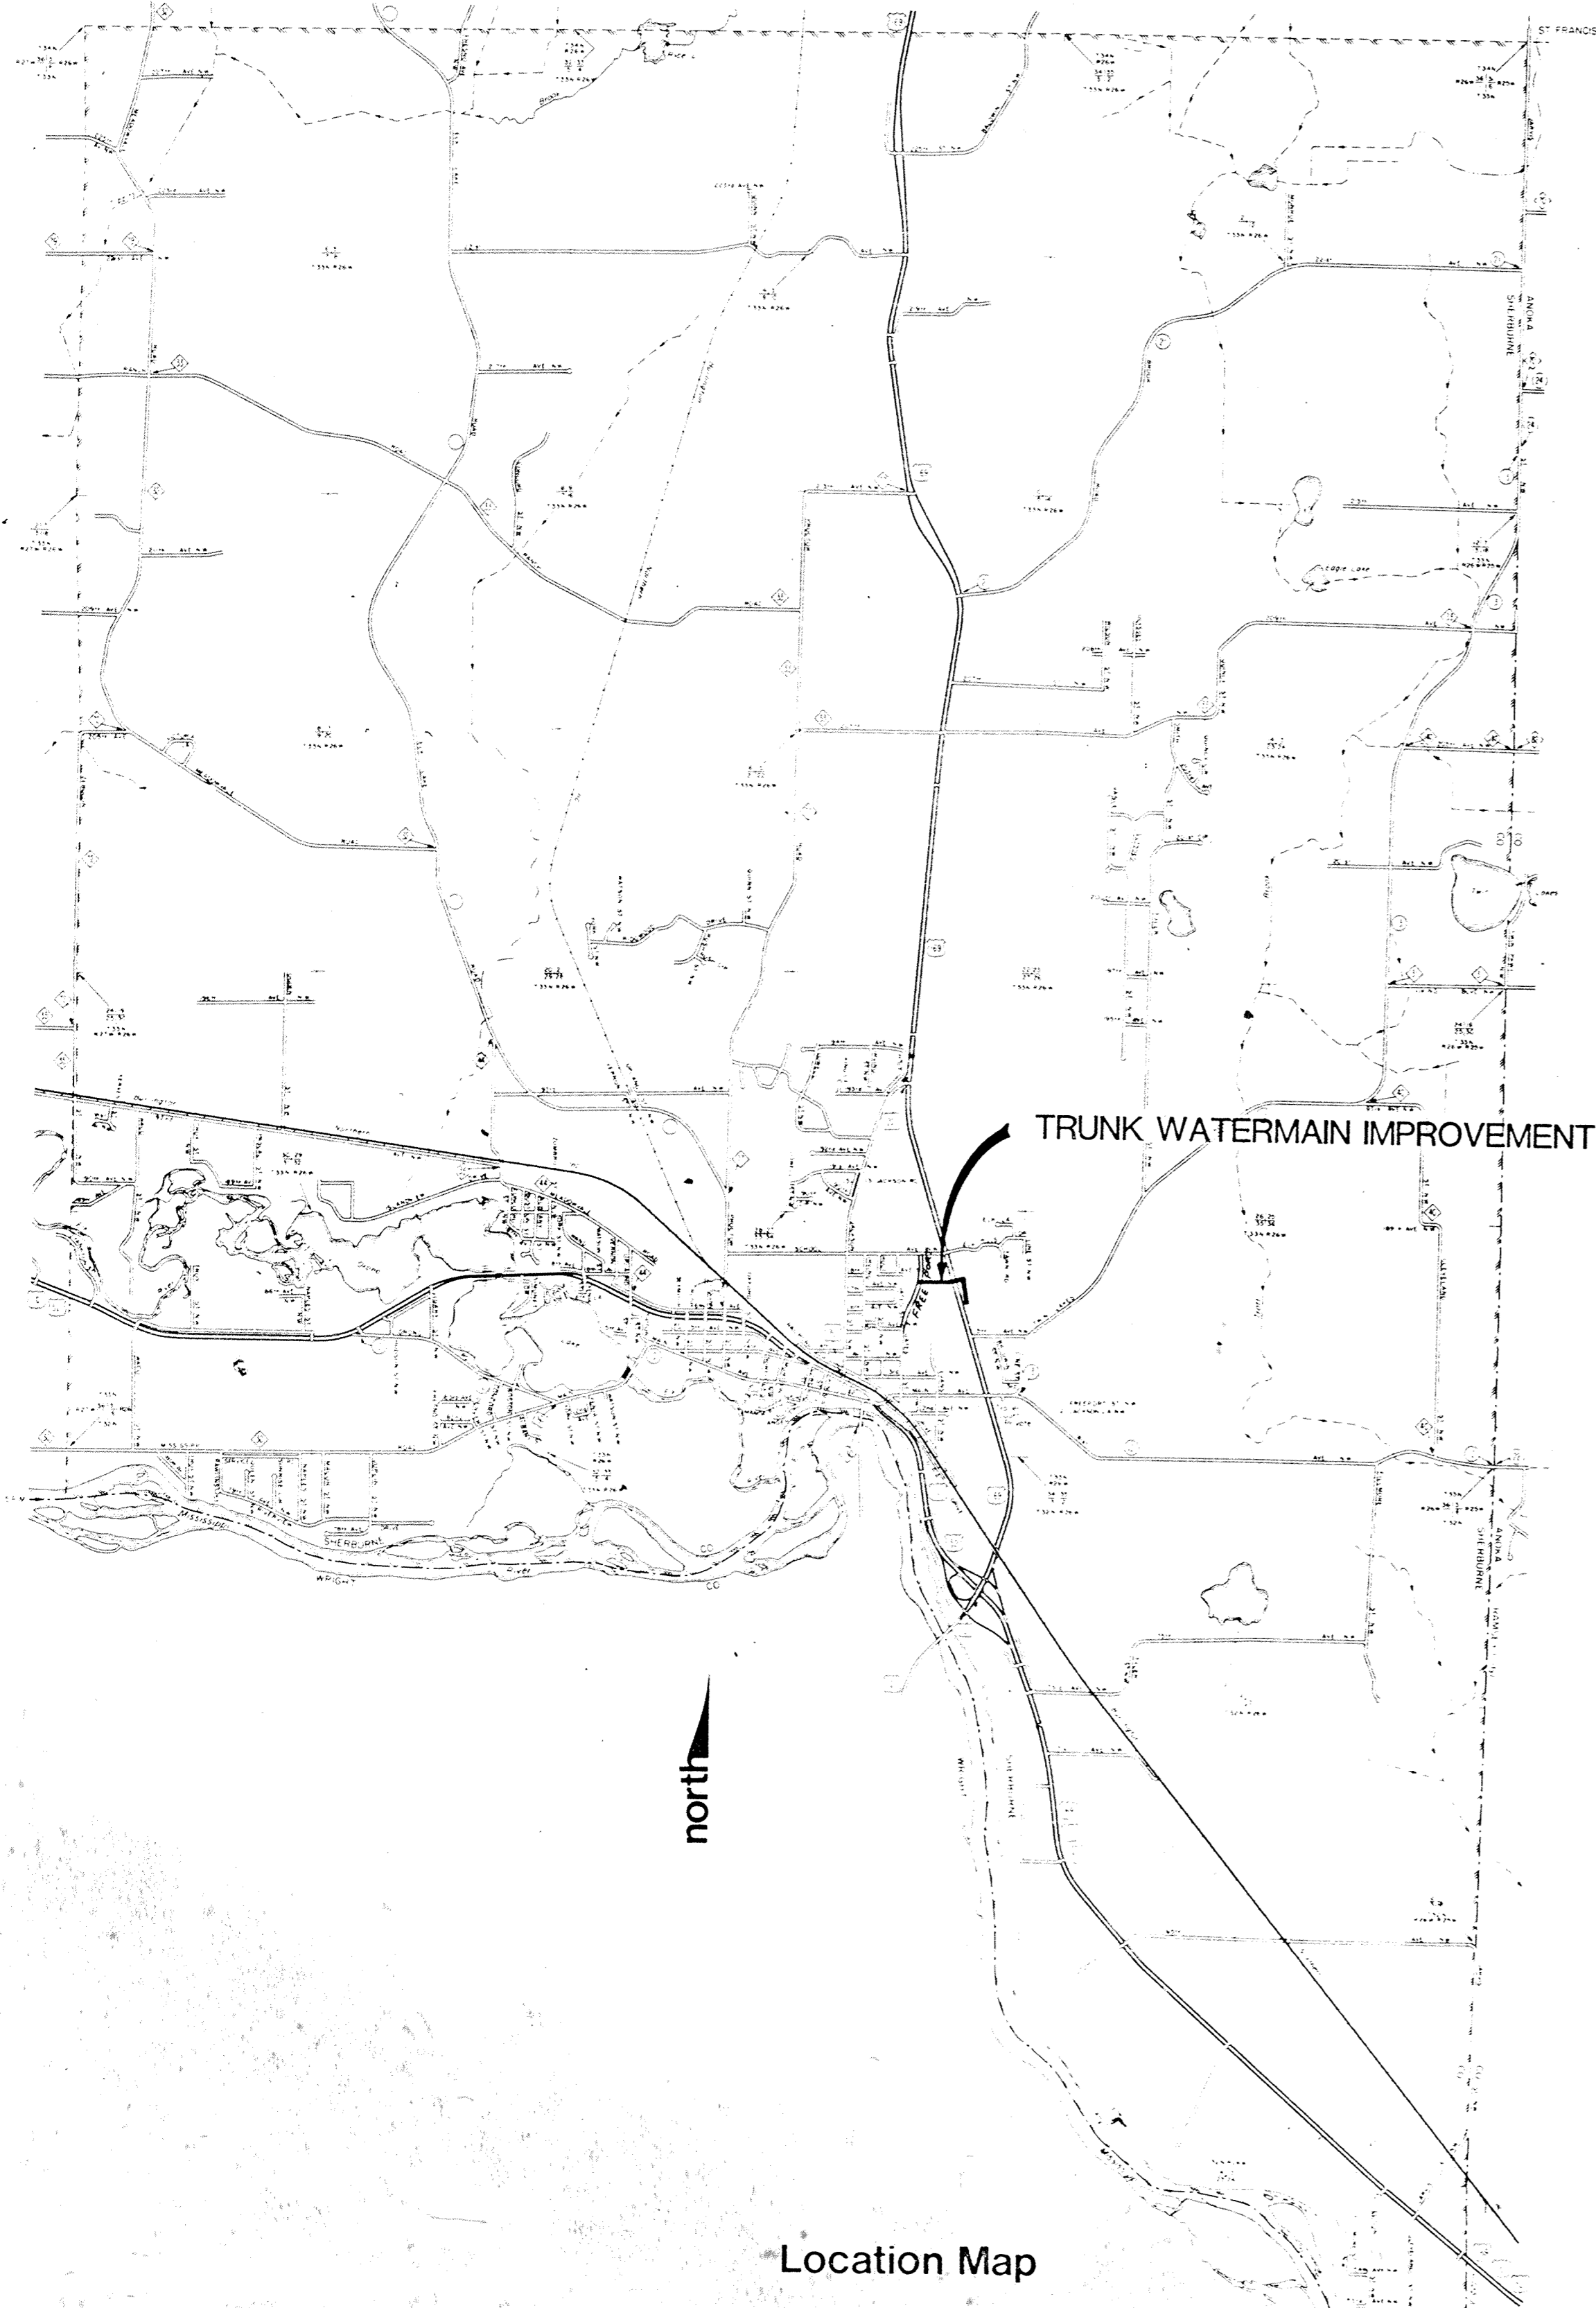

I hereby certify that this plan, specification or report was prepared by me or under my direct supervision and that I am duly Registered Professional Engineer under State of Minnesota Statutes Section 326.02 to 326.16.

John A. Peterson
Date: 8/20/84 Minnesota Registration No. 14224

consulting
engineers
diversified
inc. 

civil
municipal
planning
environmental
land surveying
geotechnics

p.o. box j, osseo, minnesota 55369 (612) 425-2181

AS-BUILT
DRAWN BY: MRK Date: 12-26-84
CHECKED BY:
INSPECTOR: JCH Date: 1-22-85
DESIGN ENG: JCH Date: 1-22-85
PARTY CHIEF: JCH Date: 1-22-85



DRAWING NUMBER

DRAWING NUMBER

DRAWING NUMBER

DRAWING NUMBER
ERPLA 84
1