

Construction Plans

for

Sanitary Sewer, Water Main, Storm Sewer and Streets

for

Elk River Station - Phase I Elk River, Minnesota

Prepared for:

CENTEX HOMES

12400 Whitewater Drive, Suite #120

Minnetonka, Minnesota 55343

Contact: Ian Peterson

Phone: (952) 988-8210


Fax: (952) 936-7839

Prepared by:



Project Number: 20021058

Contact: Jason McCarty

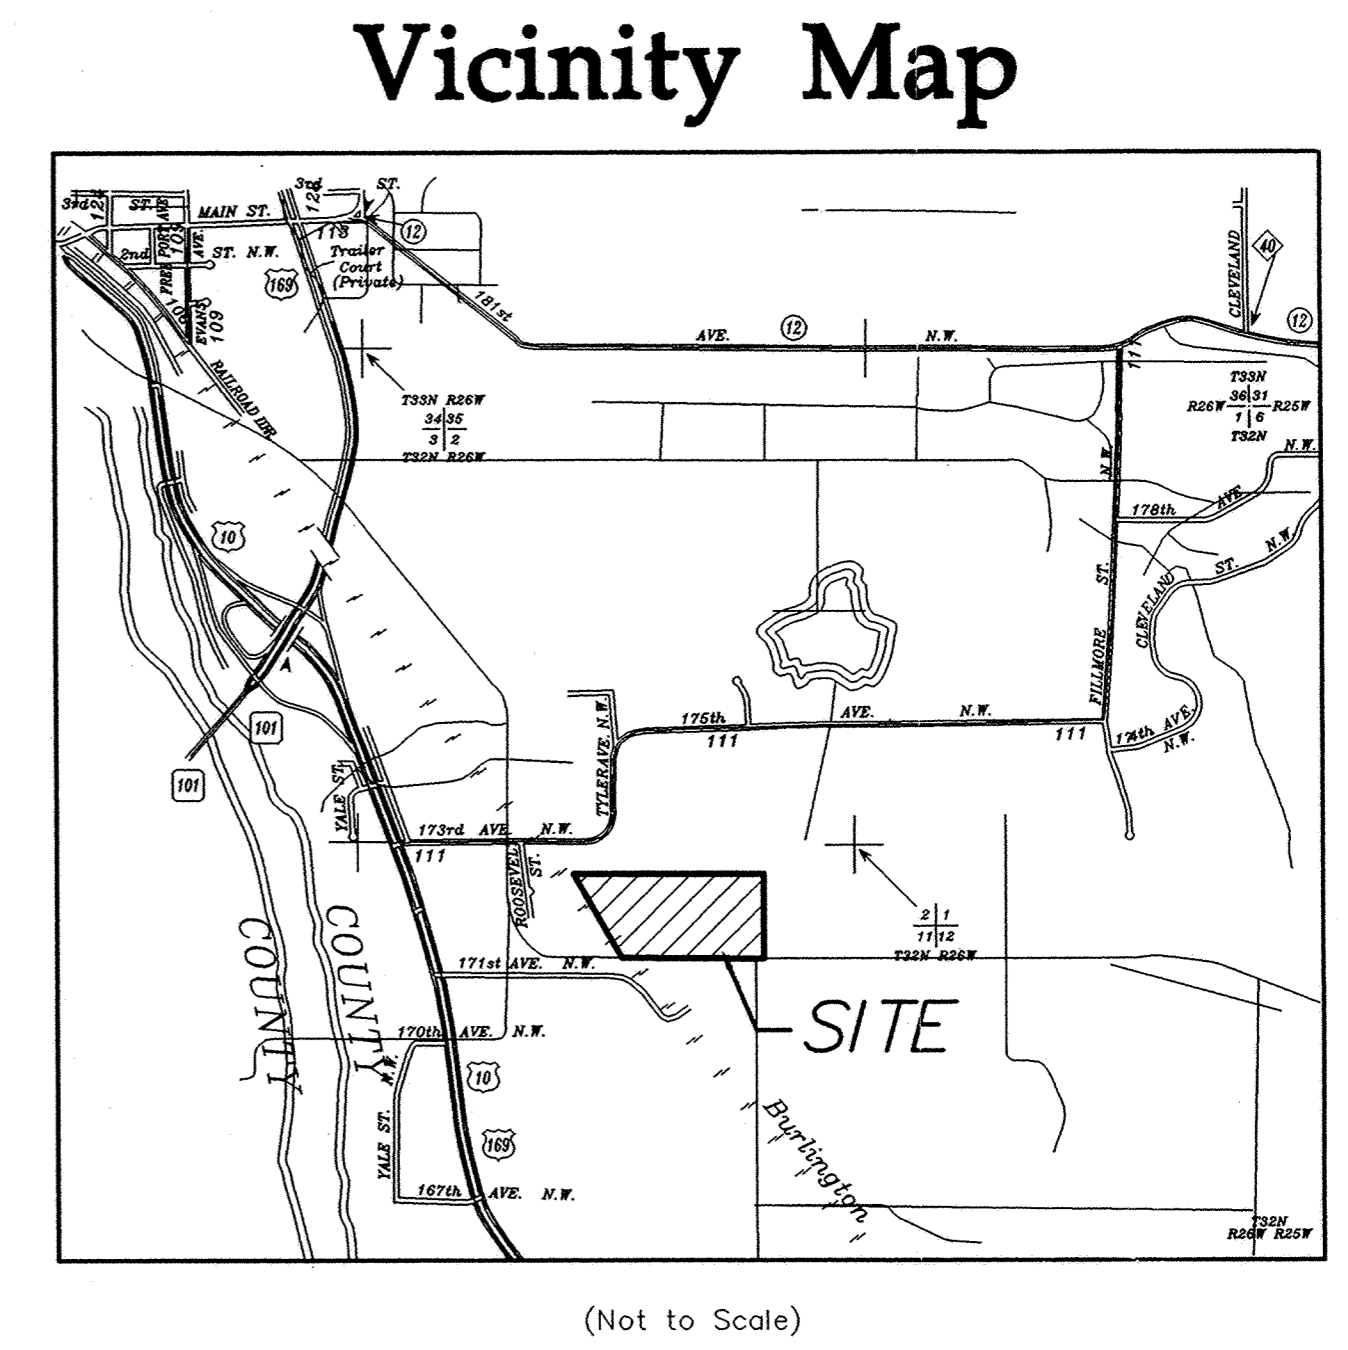

(Not to Scale)

NO.	DATE	REVISION	SHEETS
1	04/02/03	GENERAL COMMENTS	ALL
2	05/05/03	CITY REVIEW	ALL
3	05/21/03	CITY REVIEW	ALL
4	06/04/03	IRRIGATION SERVICE REVISIONS	1, 3-6
5	06/09/03	DRAINTILE STUBS	ALL
6	01/30/04	RECORD DRAWINGS	ALL

CONTRACTOR: RYAN CONTRACTOR

RECORD DRAWING
CONFORMING TO CONSTRUCTION RECORDS.
BY AL SPILLES DATE 01/31/04
WESTWOOD PROFESSIONAL SERVICES, INC.

Construction Plans

for

Sanitary Sewer, Water Main, Storm Sewer and Streets

for

Elk River Station - Phase I Elk River, Minnesota

Date: 03/21/03 Sheet: 1 of 16

INDEX	
SHEET NO.	DESCRIPTION
1	COVER
2	OVERALL PLAN
3	SANITARY SEWER & WATER MAIN - 172ND AVE NW (STA. 0+00 TO STA. 9+50)
4	SANITARY SEWER & WATER MAIN - 172ND LANE NW
5	SANITARY SEWER & WATER MAIN - OLSON STREET NW / OLSON DRIVE NW
6	SANITARY SEWER & WATER MAIN - 171ST LANE NW (STA. 0+00 TO STA. 12+50)
7	STORM SEWER & STREET CONST. - 172ND AVE NW (STA. 0+00 TO STA. 9+50)
8	STORM SEWER & STREET CONST. - 172ND LANE NW
9	STORM SEWER & STREET CONST. - OLSON STREET NW
10	STORM SEWER & STREET CONST. - 171ST LANE NW (STA. 0+00 TO STA. 12+50)
11	STORM SEWER & STREET CONST. - 171ST AVENUE NW
12	STORM SEWER & STREET CONST. - TWIN LAKES ROAD
13-16	DETAILS

SACO PRODUCTS • NEW HOPKINS, MINNESOTA
 REQUESTED BY PART NUMBER 5532
 PROJECT NUMBER 20021058
 SHEET 1 OF 16
 ERSTA1.03
 1