
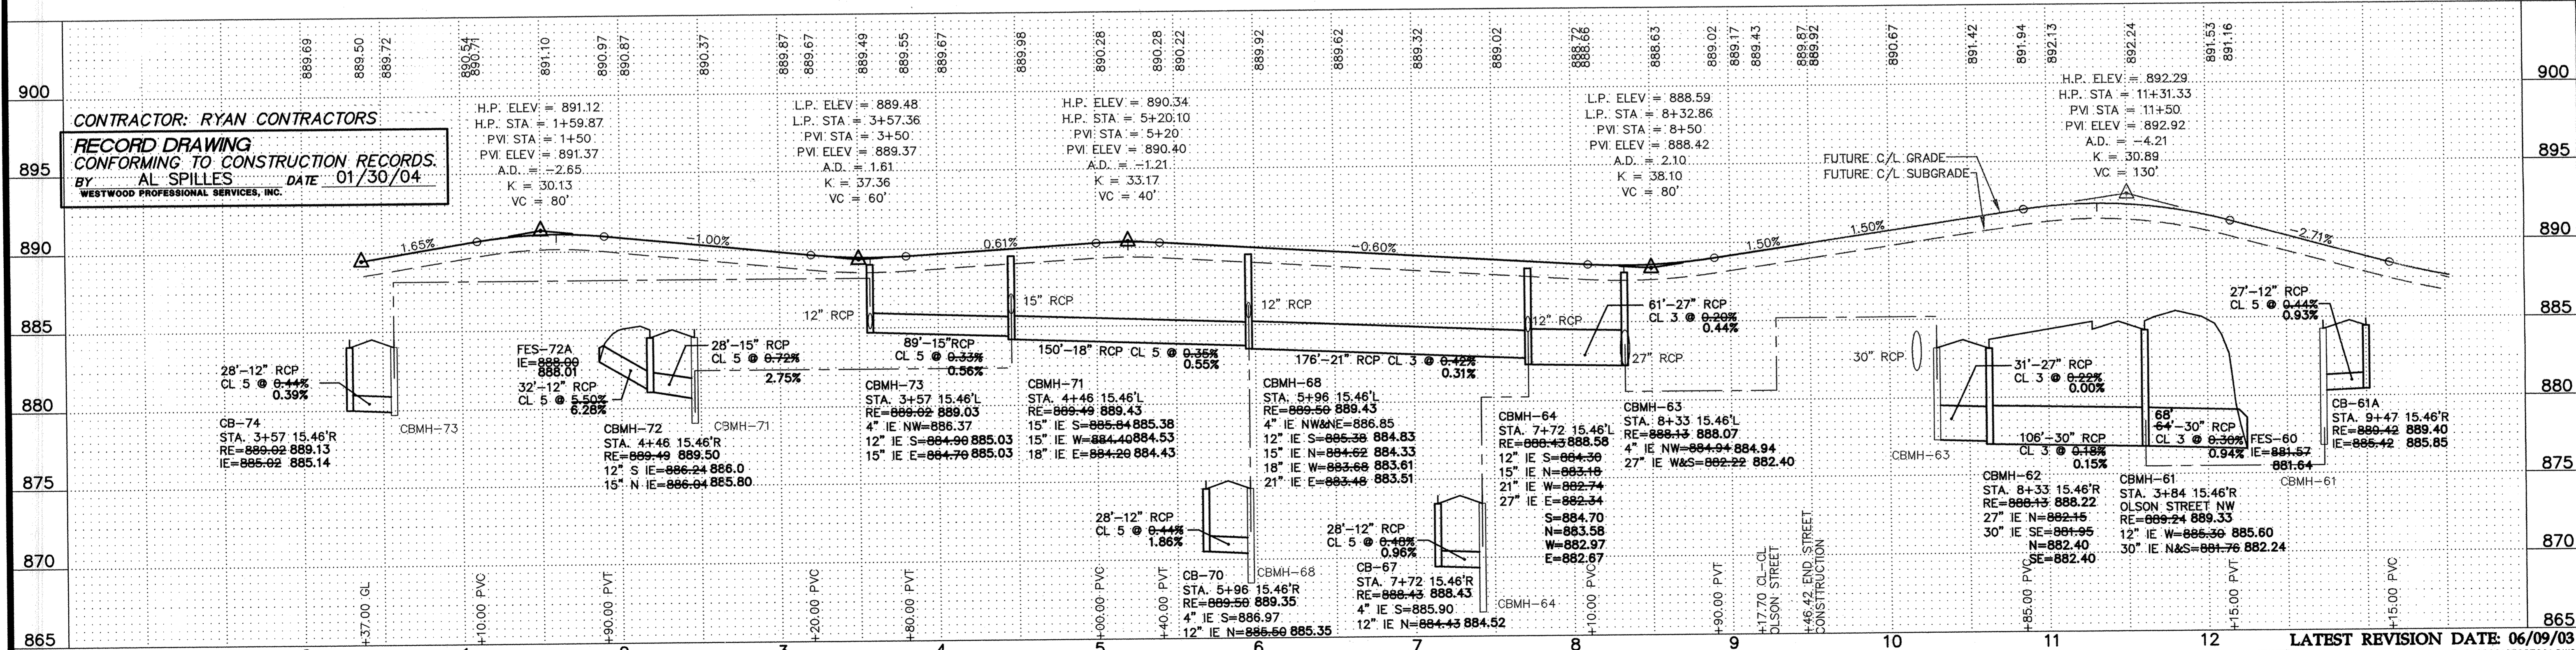


GENERAL NOTES:

- RADIUS TO BE TYPE B618 CURB AND GUTTER WITH 5 FOOT TRANSITION FROM SURMOUNTABLE CURB PER CITY OF ELK RIVER STANDARDS.
- TYPE B618 CURB & GUTTER SHALL BE CONSTRUCTED AT ALL INTERSECTIONS AND CATCH BASINS.
- 48.09 = 848.09
- RADIUS TO BE B618 C. & G. AS PER ELK RIVER DETAIL 2000 (TYP.)
- ALL RADI TO BE 20' BOC UNLESS OTHERWISE NOTED
- STEEL ADJUSTING RINGS SHOULD BE USED FOR MANHOLE ADJUSTMENTS PRIOR TO WEAR COURSE PLACEMENT AND SHOULD BE TYPE R-1979.
- DENOTES GUTTER LINE ELEVATION AT INTERSECTIONS

CASTING NOTE:

ALL CATCH BASIN CASTINGS IN CURB SHALL BE SUMPED 0.10 FEET AND MANHOLE CASTINGS IN PAVED AREAS SHALL BE SUMPED 0.05 FEET. RIM ELEVATIONS ON PLAN PROFILES REFLECT THE SUMPED ELEVATIONS.

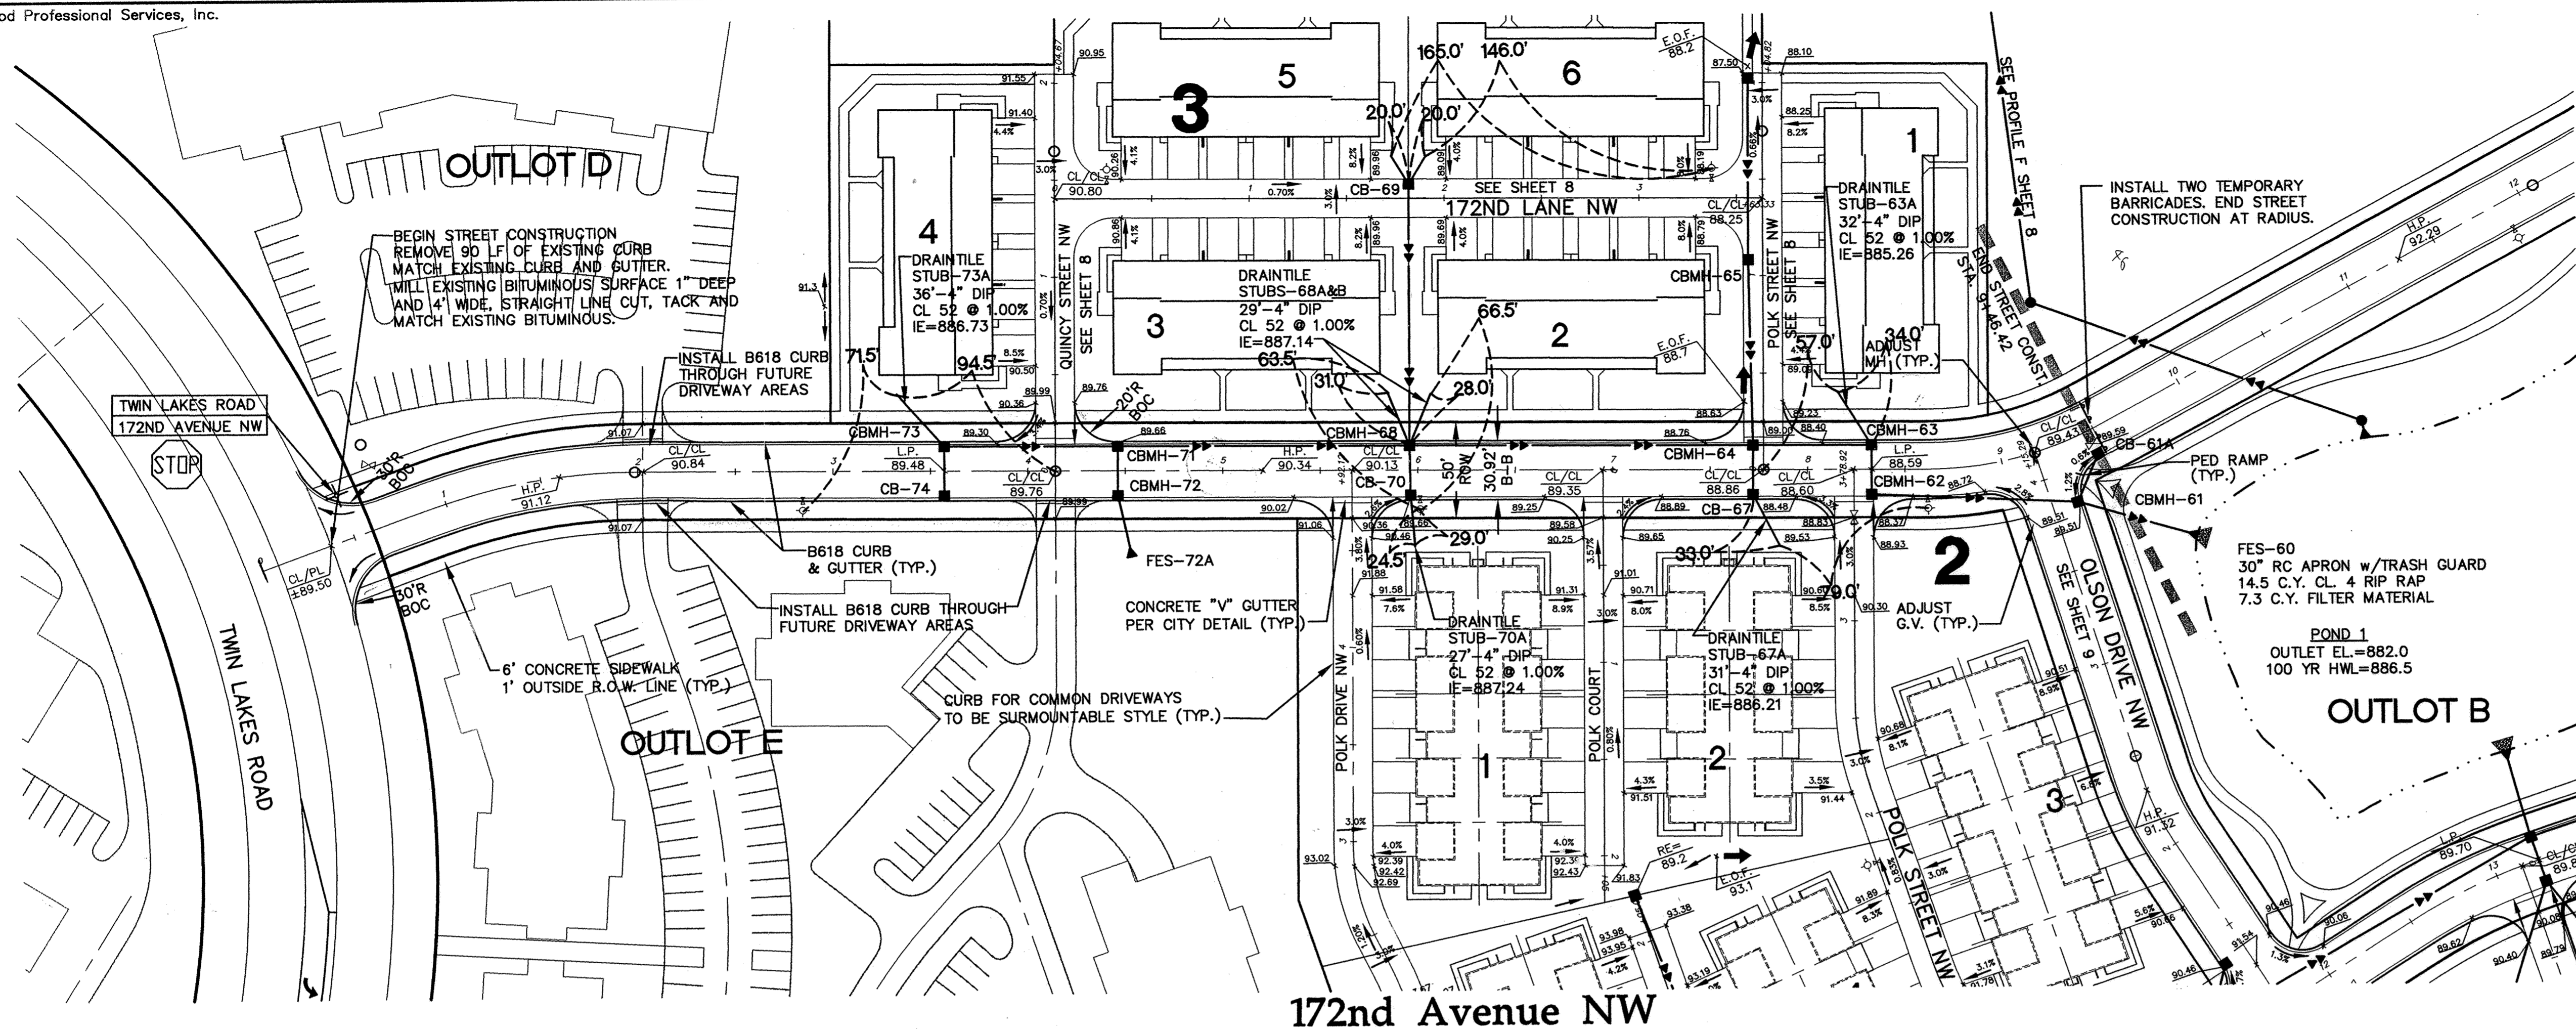

CONTRACTOR: RYAN CONTRACTORS
RECORD DRAWING
 CONFORMING TO CONSTRUCTION RECORDS.
 BY AL SPILLES DATE 01/30/04
 WESTWOOD PROFESSIONAL SERVICES, INC.

LATEST REVISION DATE: 06/09/03
E-8 20021058T001.DWG

Date: 03/21/03 Sheet: 7 OF 16

Westwood Professional Services, Inc.
 7599 Anagram Drive
 Eden Prairie, MN 55344
 Phone: 952/937-5150 Fax: 952/937-5822

I hereby certify that this plan was prepared by me or under my direct supervision and that I am a duly licensed PROFESSIONAL ENGINEER under the laws of the State of Minnesota.
 Jason M. McCarty
 Date: 01/30/04 License No. 41955

Revisions:
 04/02/03 General Comments - CLJ
 05/05/03 City Review - CLJ
 05/21/03 City Review - CLJ
 06/09/03 Drainage Stub - CLJ

Designed: JMM
 Checked: JMM
 Drawn: WH
 Record Drawing by date: AS 01/30/04

Prepared for:

CENTEX HOMES
 12400 Whitewater Drive, Suite #120
 Minnetonka, Minnesota 55343

Elk River Station Phase I
 Elk River, Minnesota

Storm Sewer and Street Construction Plans
 172nd Avenue NW Sta. 0+00 to Sta. 9+50

DRAWING NUMBER

DRAWING NUMBER

DRAWING NUMBER

DRAWING NUMBER
ERSTA1.03
7