
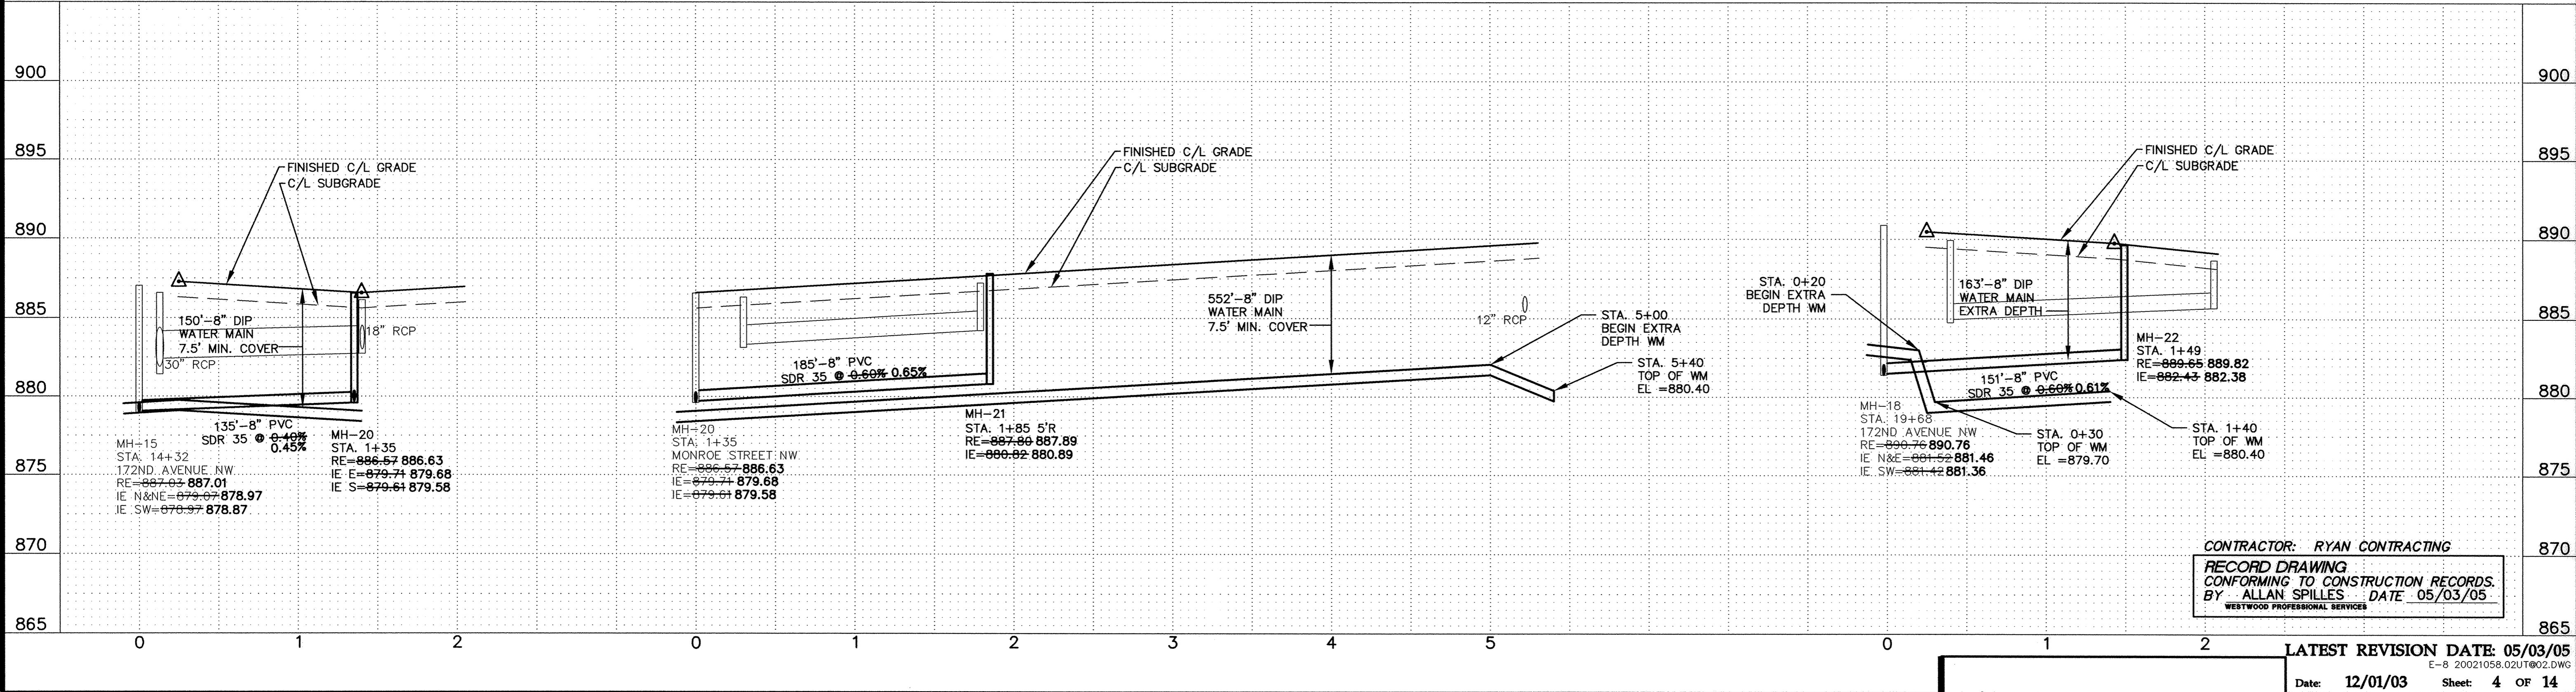


Call 48 Hours before digging:  
**GOPHER STATE ONE CALL**  
 Twin City Area 651-454-0002  
 Mn. Toll Free 1-800-252-1166

- GENERAL NOTES:**
- (XXX.X) DENOTES SANITARY SEWER SERVICE INVERT @ END OF FUTURE SERVICE STUB
  - WYE=X+XX DENOTES SANITARY SEWER SERVICE WYE LOCATED ON MAINLINE FROM DOWN STREAM M.H.
  - FLAG HYDRANTS.
  - HYDRANTS TO BE PLACED 5' BEHIND BACK OF CURB.
  - EXTEND RODS ON DEEP VALVES.
  - ALL DROP MANHOLES WITH DROPS OVER 2' TO BE CONSTRUCTED USING OUTSIDE DROPS.
  - SANITARY SERVICES SHALL BE 6" PVC (SDR26) PIPE. WATER SERVICES SHALL BE 4" DUCTILE IRON PIPE WITH 4" GATE VALVE PLACED 3' BEYOND PROPERTY LINE OR 10' BEHIND SIDEWALK OR PRIVATE STREET CURB WITH 8"x4" TEE AT THE MAIN, AND A 4" DIP PLUG WITH A THREADED 1 1/2" PLUG AT STUB.
  - ALL MAIN LINE GATE VALVES TO BE LOCATED IN STREET BITUMINOUS
  - WATER SERVICES TO BE INSTALLED UNDER SANITARY SERVICE.
  - INSTALL WATER SERVICE OVER STORM SEWER
  - INSTALL WATER SERVICE UNDER STORM SEWER

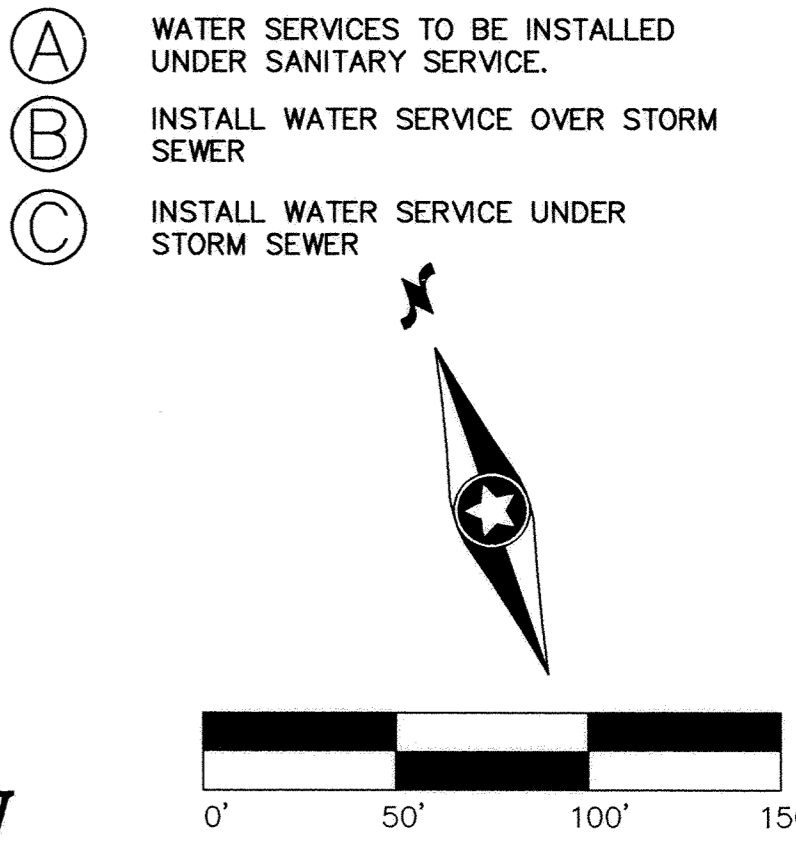

CONTRACTOR: RYAN CONTRACTING  
 RECORD DRAWING  
 CONFORMING TO CONSTRUCTION RECORDS.  
 BY ALLAN SPILLES DATE 05/03/05  
 WESTWOOD PROFESSIONAL SERVICES

LATEST REVISION DATE: 05/03/05  
 Date: 12/01/03 Sheet: 4 OF 14

**Westwood Professional Services, Inc.**  
 7599 Anagram Drive  
 Eden Prairie, MN 55344  
 Phone: 952/937-5150 Fax: 952/937-5822

I hereby certify that this plan was prepared by me or under my direct supervision and that I am a duly licensed PROFESSIONAL ENGINEER under the laws of the State of Minnesota.  
  
**Jason M. McCarty**  
 Date: 05/03/05 License No. 41955

Revisions:

02/05/04 PER CITY REVIEW (D)	Designed: JMM
04/22/04 STORM SEWER REVISION (HW)	Checked: JMM
	Drawn: NCP
05/03/05 RECORD DRAWING (G/B)	Record Drawing by/date: GKB 5/03/05

Prepared for:  
**CENTEX HOMES**  
 12701 Whitewater Drive, Suite #300  
 Minnetonka, Minnesota 55343

**Elk River Station  
 2nd Addition**  
 Elk River, Minnesota

**Sanitary Sewer  
 and Water Main  
 Construction Plans**  
 Nixon Street NW, 172nd Lane NW &  
 Monroe Street NW

DRAWING NUMBER 4