

CITY OF ELK RIVER



EAGLE MARSH

SANITARY SEWER AND WATERMAIN CONSTRUCTION

INDEX

- | | |
|-------------|------------------------------------|
| SHEET G1 | TITLE SHEET |
| SHEET G2 | SHEET INDEX AND CONSTRUCTION NOTES |
| SHEET P1-P4 | PLAN AND PROFILES |
| SHEET D1 | WATERMAIN AND CONSTRUCTION DETAILS |
| SHEET D2 | SANITARY DETAILS |

THIS PLAN CONTAINS 8 SHEETS


PREPARED FOR:



MAY 2002

SHEET G1

RECORD PLAN DECEMBER 2002

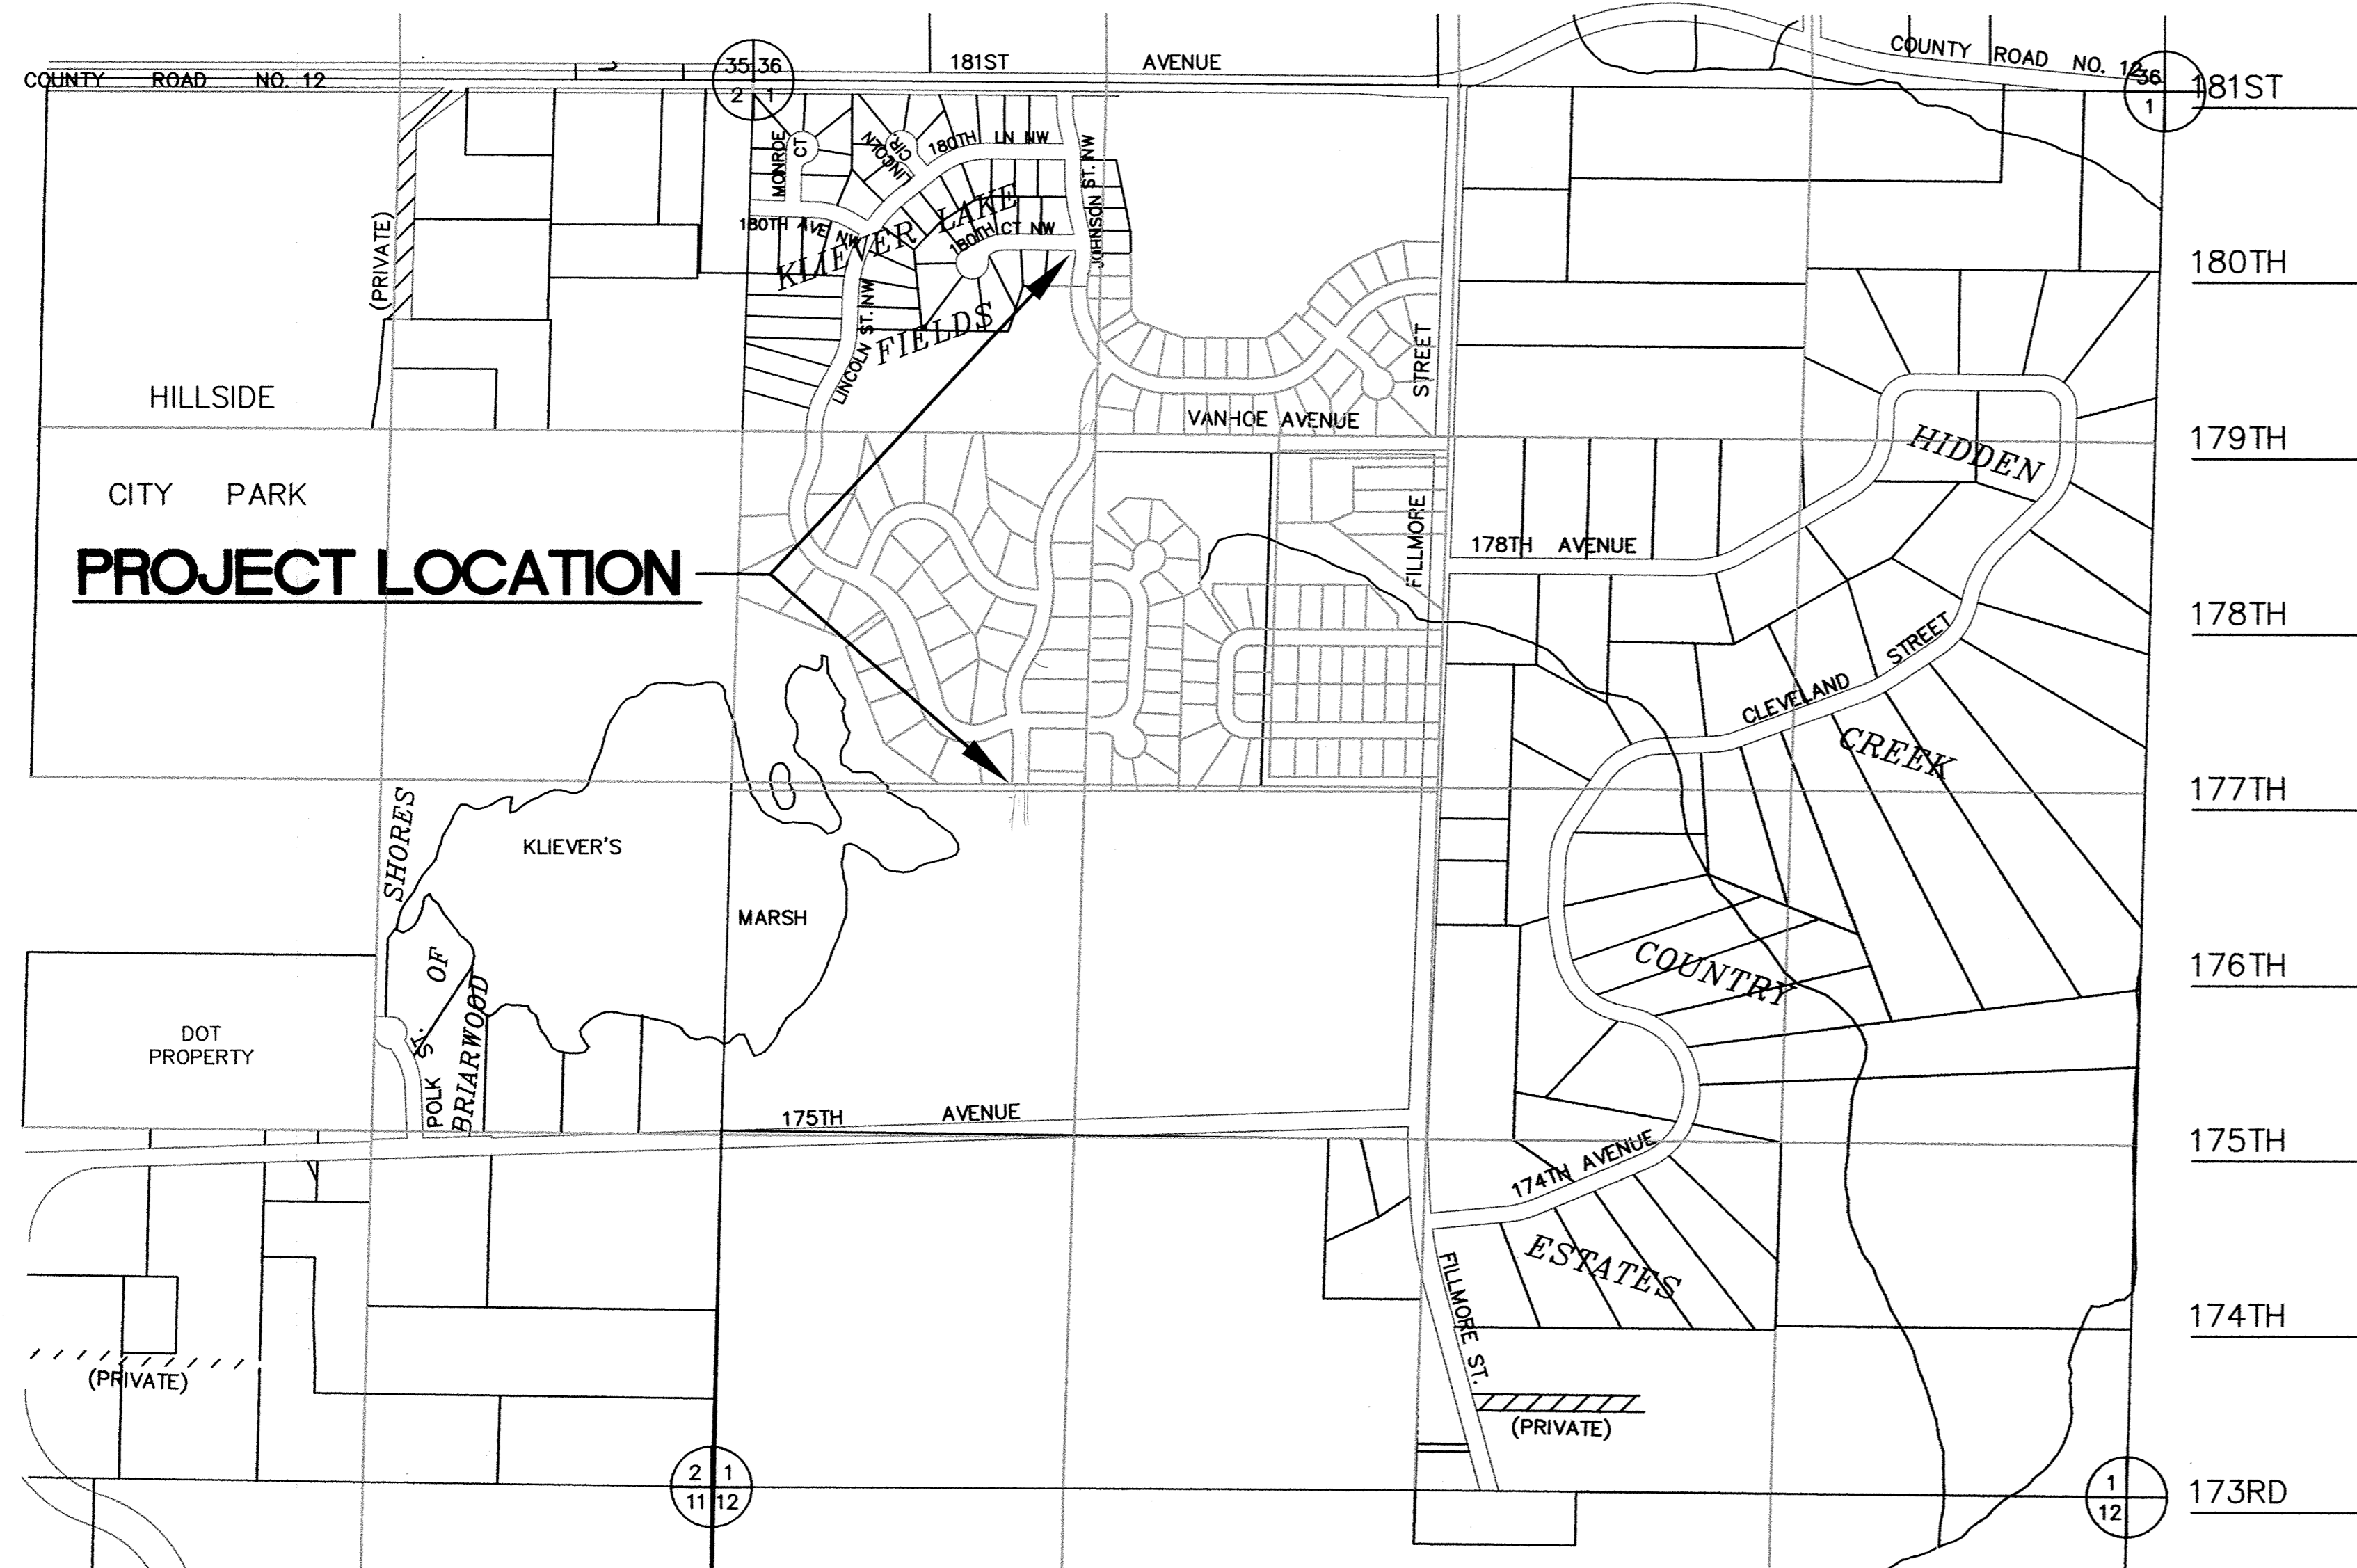

LOCATION MAP

Xref: 2003788A.DWG
 February 01, 2003 9:06:48 a.m.
 816050j\dwg\XCS-BASE.DWG (JLALLEN)

DRAWING NUMBER
 EAGLE 02
 DRAWING NUMBER
 1