

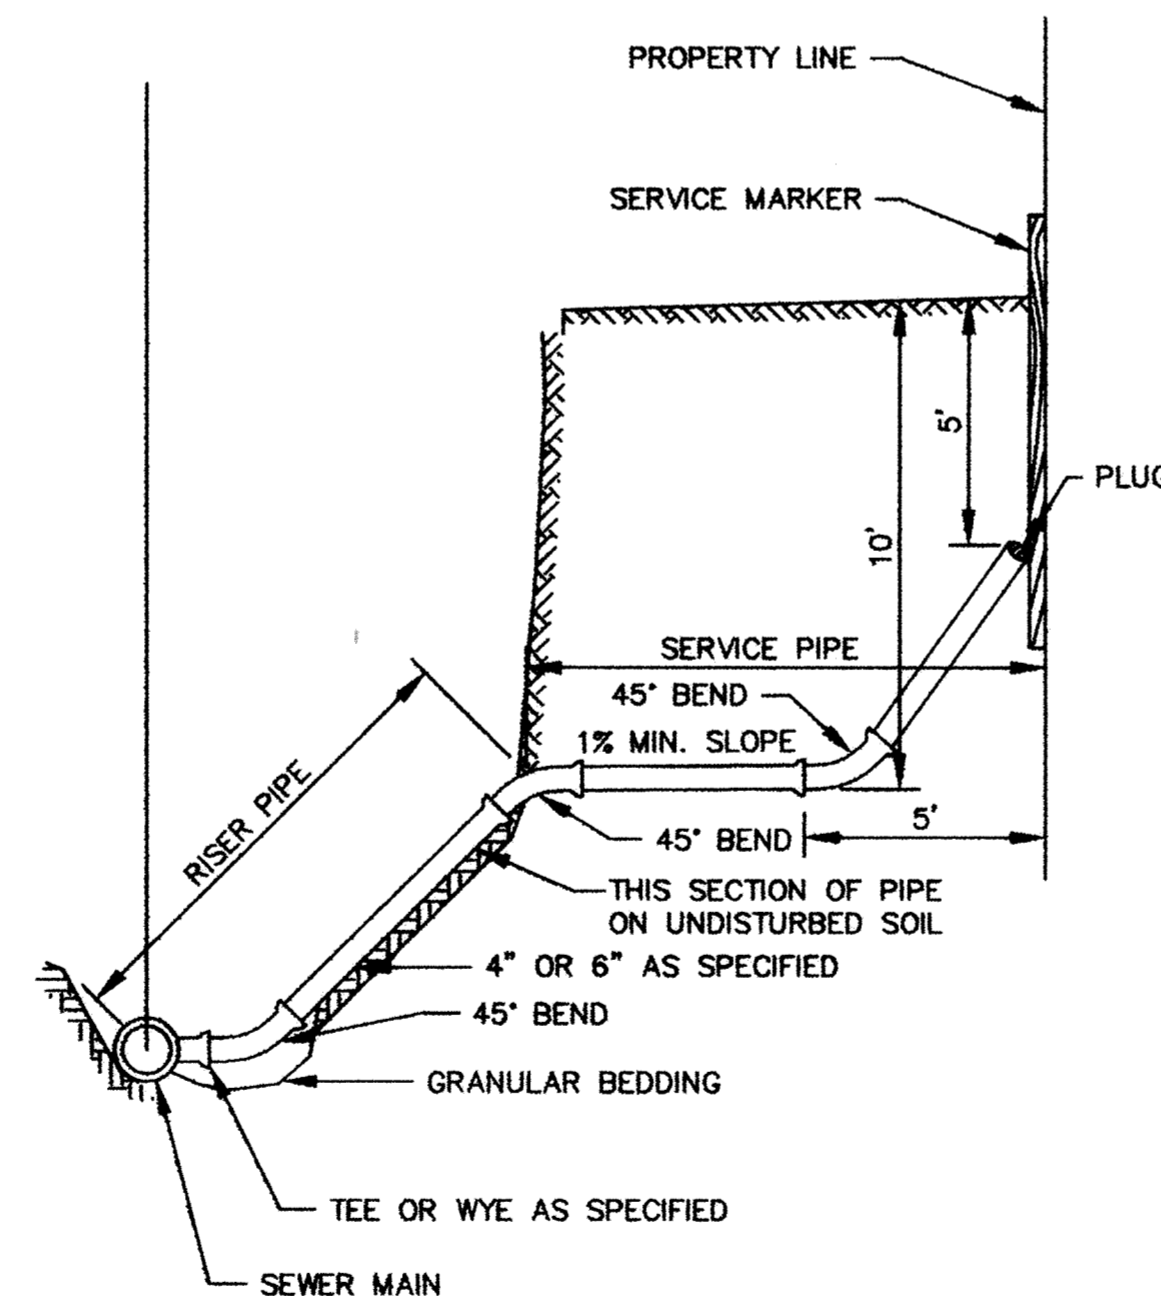


NOTE: ALL COSTS OF EXCAVATION BELOW GRADE AND PLACEMENT OF GRANULAR BEDDING SHALL BE INCLUDED IN THE BID PRICES FOR PIPE ITEMS.

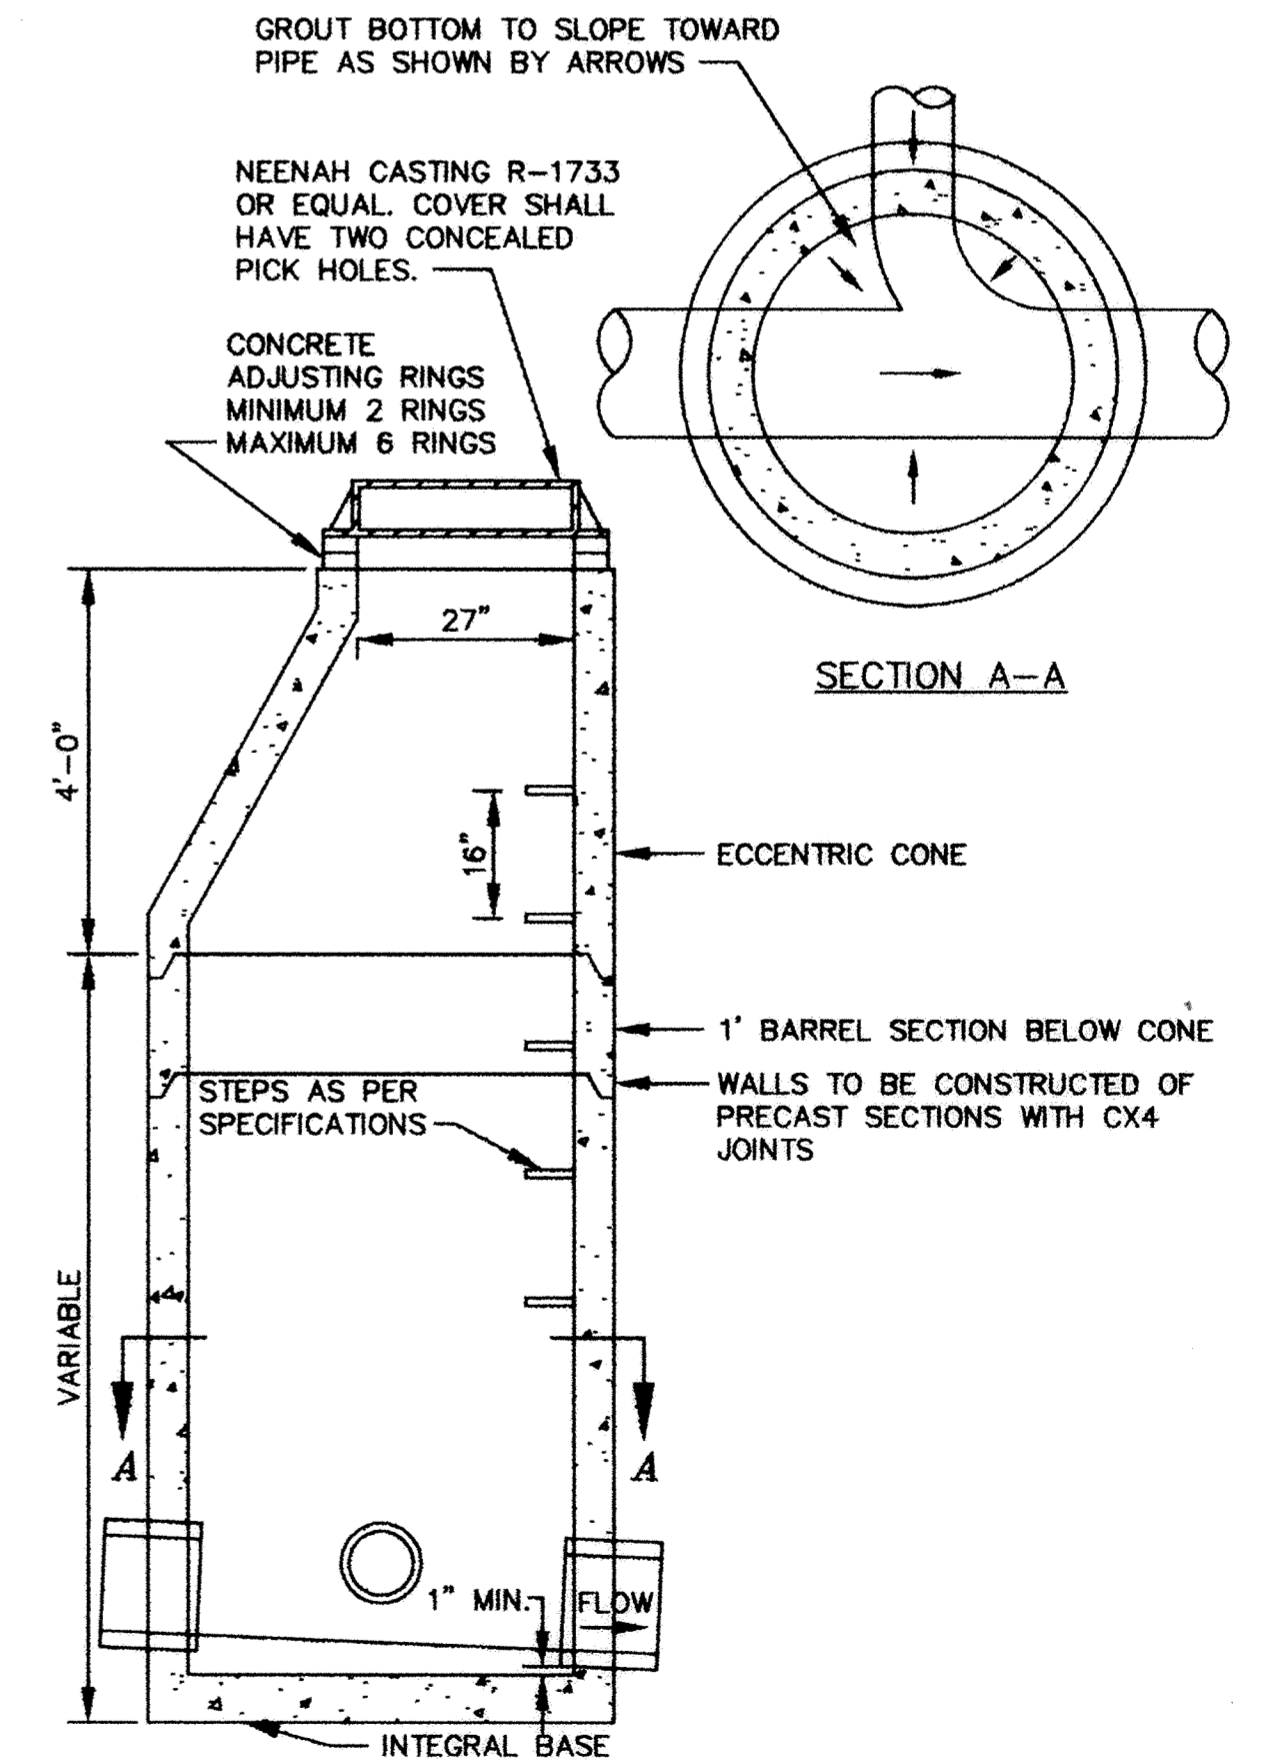

TO BE USED AS SERVICE CONNECTIONS ON DEEP LINES

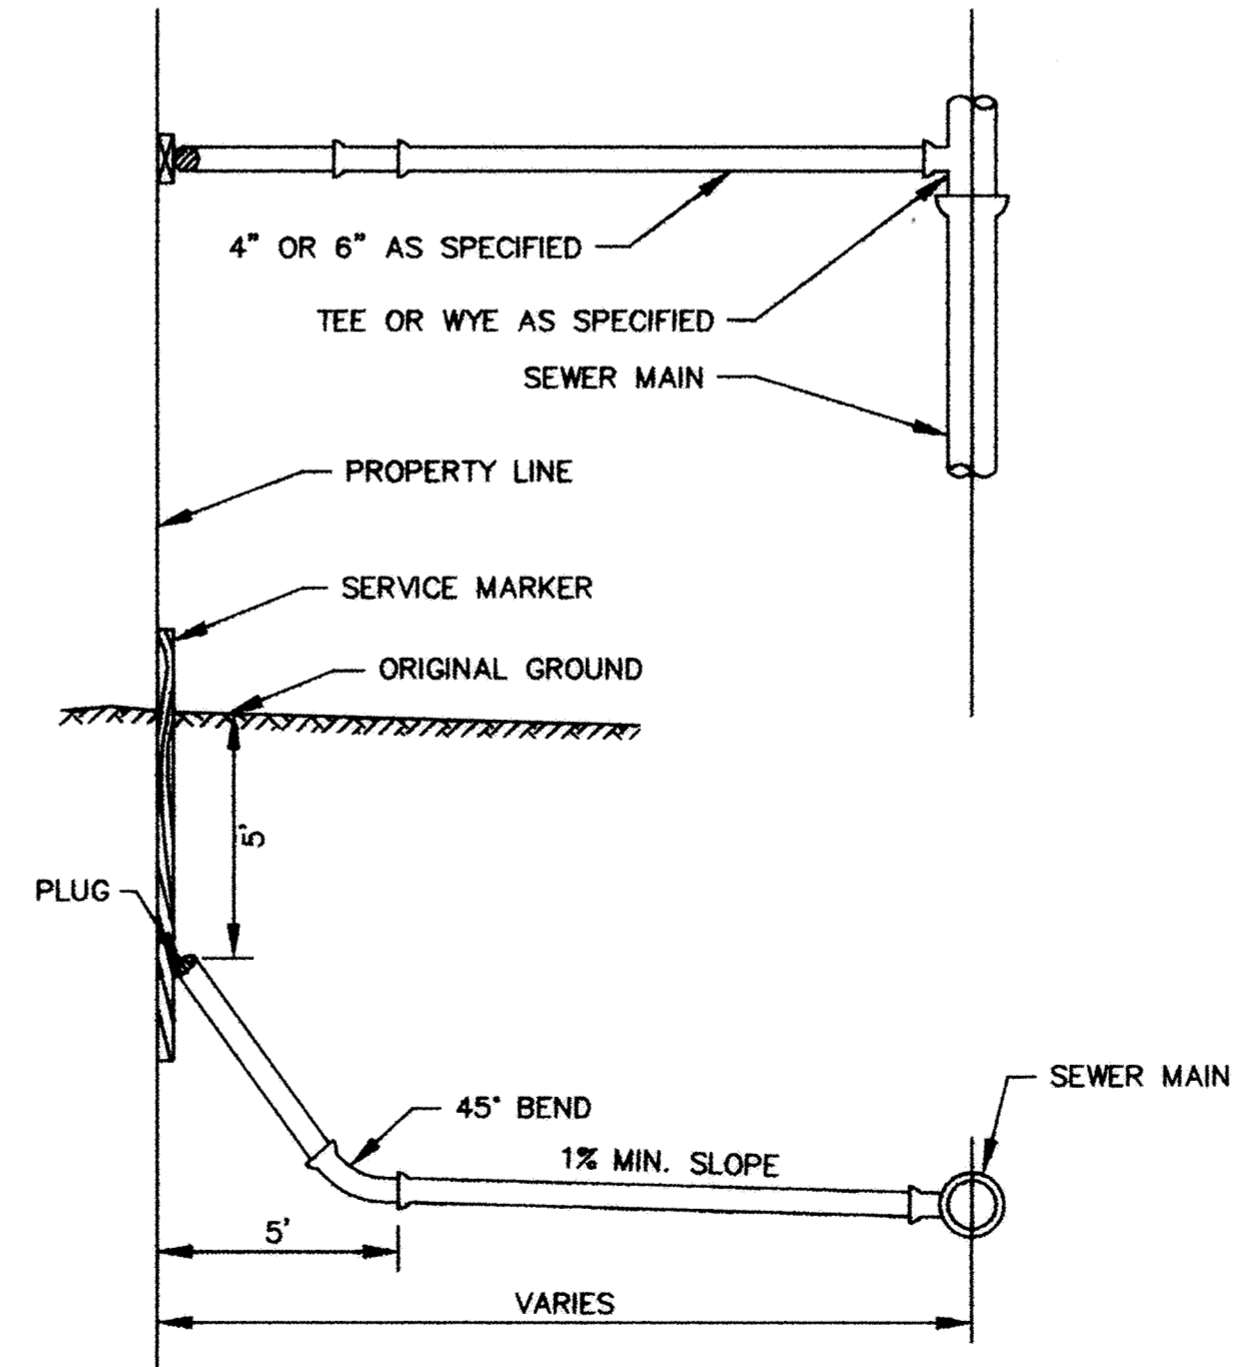

RECORD PLAN
DECEMBER 2002

DESIGNED BY: KT DRAWN BY: EY/RM
APPROVED BY: JOB NUMBER 816050J
CAD DATE: February 01, 2003 9:06:48 a.m.
CAD FILE: 816050j.dwg\XCS-BASE.DWG (JLALLEN)

I HEREBY CERTIFY THAT THIS PLAN, SPECIFICATION, OR REPORT WAS PREPARED BY ME OR UNDER MY DIRECT SUPERVISION AND THAT I AM A DULY LICENSED PROFESSIONAL ENGINEER UNDER THE LAWS OF THE STATE OF MINNESOTA.
SIGNATURE _____ DATE _____
PRINTED NAME TERRY J. MAURER LIC. NO. 15316

NO.	DATE	BY	REVISION DESCRIPTION

ELK RIVER MUNICIPAL UTILITIES
EAGLE MARSH

SANITARY SEWER DETAILS

SHEET NO.

D2

DRAWING NUMBER

EAGLE 02

DRAWING NUMBER

3D PRODUCTS • NEW HOPE, MINNESOTA
DRAWING NUMBER 8582
3D PRODUCTS • NEW HOPE, MINNESOTA
DRAWING NUMBER 8582
3D PRODUCTS • NEW HOPE, MINNESOTA
DRAWING NUMBER 8582
3D PRODUCTS • NEW HOPE, MINNESOTA
DRAWING NUMBER 8582