

**RIVERSIDE COMPANIES**  
**EAGLES MARSH 2ND ADDITION**  
**PLAN AND PROFILE**  
**JOHNSON STREET**


**BDM**  
 CONSULTING ENGINEERS, P.L.C.  
 Engineers and Surveyors  
 4176 Lovell Road, Suite 112  
 Lexington, MN 55014  
 Phone: (763) 786-4570  
 Fax: (763) 786-4574  
 bdmce.com

DRAWN BY: JL  
 CHECKED BY: JMA  
 DESIGNED BY: JL  
 JOB NO. 226088  
 SHEET **P13** SHEETS **26**

I HEREBY CERTIFY THAT THIS PLAN, SPECIFICATION, OR REPORT WAS PREPARED BY ME OR UNDER MY DIRECT SUPERVISION AND THAT I AM A DULY LICENSED PROFESSIONAL ENGINEER UNDER THE LAWS OF THE STATE OF MINNESOTA.  
 JOHN M. ANDERSON  
 March 17, 2006 25889  
 LIC. NO.

NO.	DATE	BY	DESCRIPTION
	01/27/08	EV	AS-BUILT PER CITY

**RECORD PLAN**  
**2006**

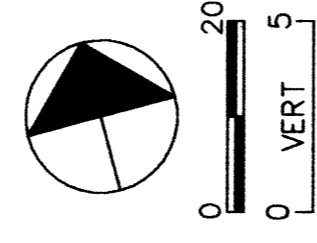

**JOHNSON STREET**

LOW POINT ELEV = 901.43  
 LOW POINT STA = 12+91.69  
 PVI STA = 12+03.45  
 PVI ELEV = 901.16  
 A.D. = 8.50  
 K = 23.53  
 200'00" VC

EX. SAN. MH  
 TOP 911.44  
 INV 892.63 N

EX. SAN. MH  
 TOP 901.70  
 INV 891.83 N

EX. SAN. MH  
 TOP 901.93  
 INV 890.83 N

EX. SAN. MH  
 TOP 901.78  
 INV 891.54 S  
 INV 891.41 N  
 INV 891.48 UTI

EX. 8" PVC SANITARY  
 INV 897.22

EX. 8" PVC SANITARY  
 INV 897.22

