

NOTE:  
RESTORE ALL DISTURBED  
AREAS WITH TOPSOIL, SEED  
AND EROSION CONTROL  
BLANKET

15" RCP APRON  
W/ TRASH  
GUARD  
INV 892.60.40  
5.8 CY CL IV  
RIPRAP



30" RCP APRON  
W/ TRASH  
GUARD  
INV 892.00  
14.5 CY CL IV  
RIPRAP

15" RCP APRON  
W/ TRASH  
GUARD  
INV 896.00.25  
5.8 CY CL IV  
RIPRAP

15" RCP APRON  
W/ TRASH  
GUARD  
INV 896.00  
895.87

SEE SHEET P1

LOT 11  
BLOCK 4

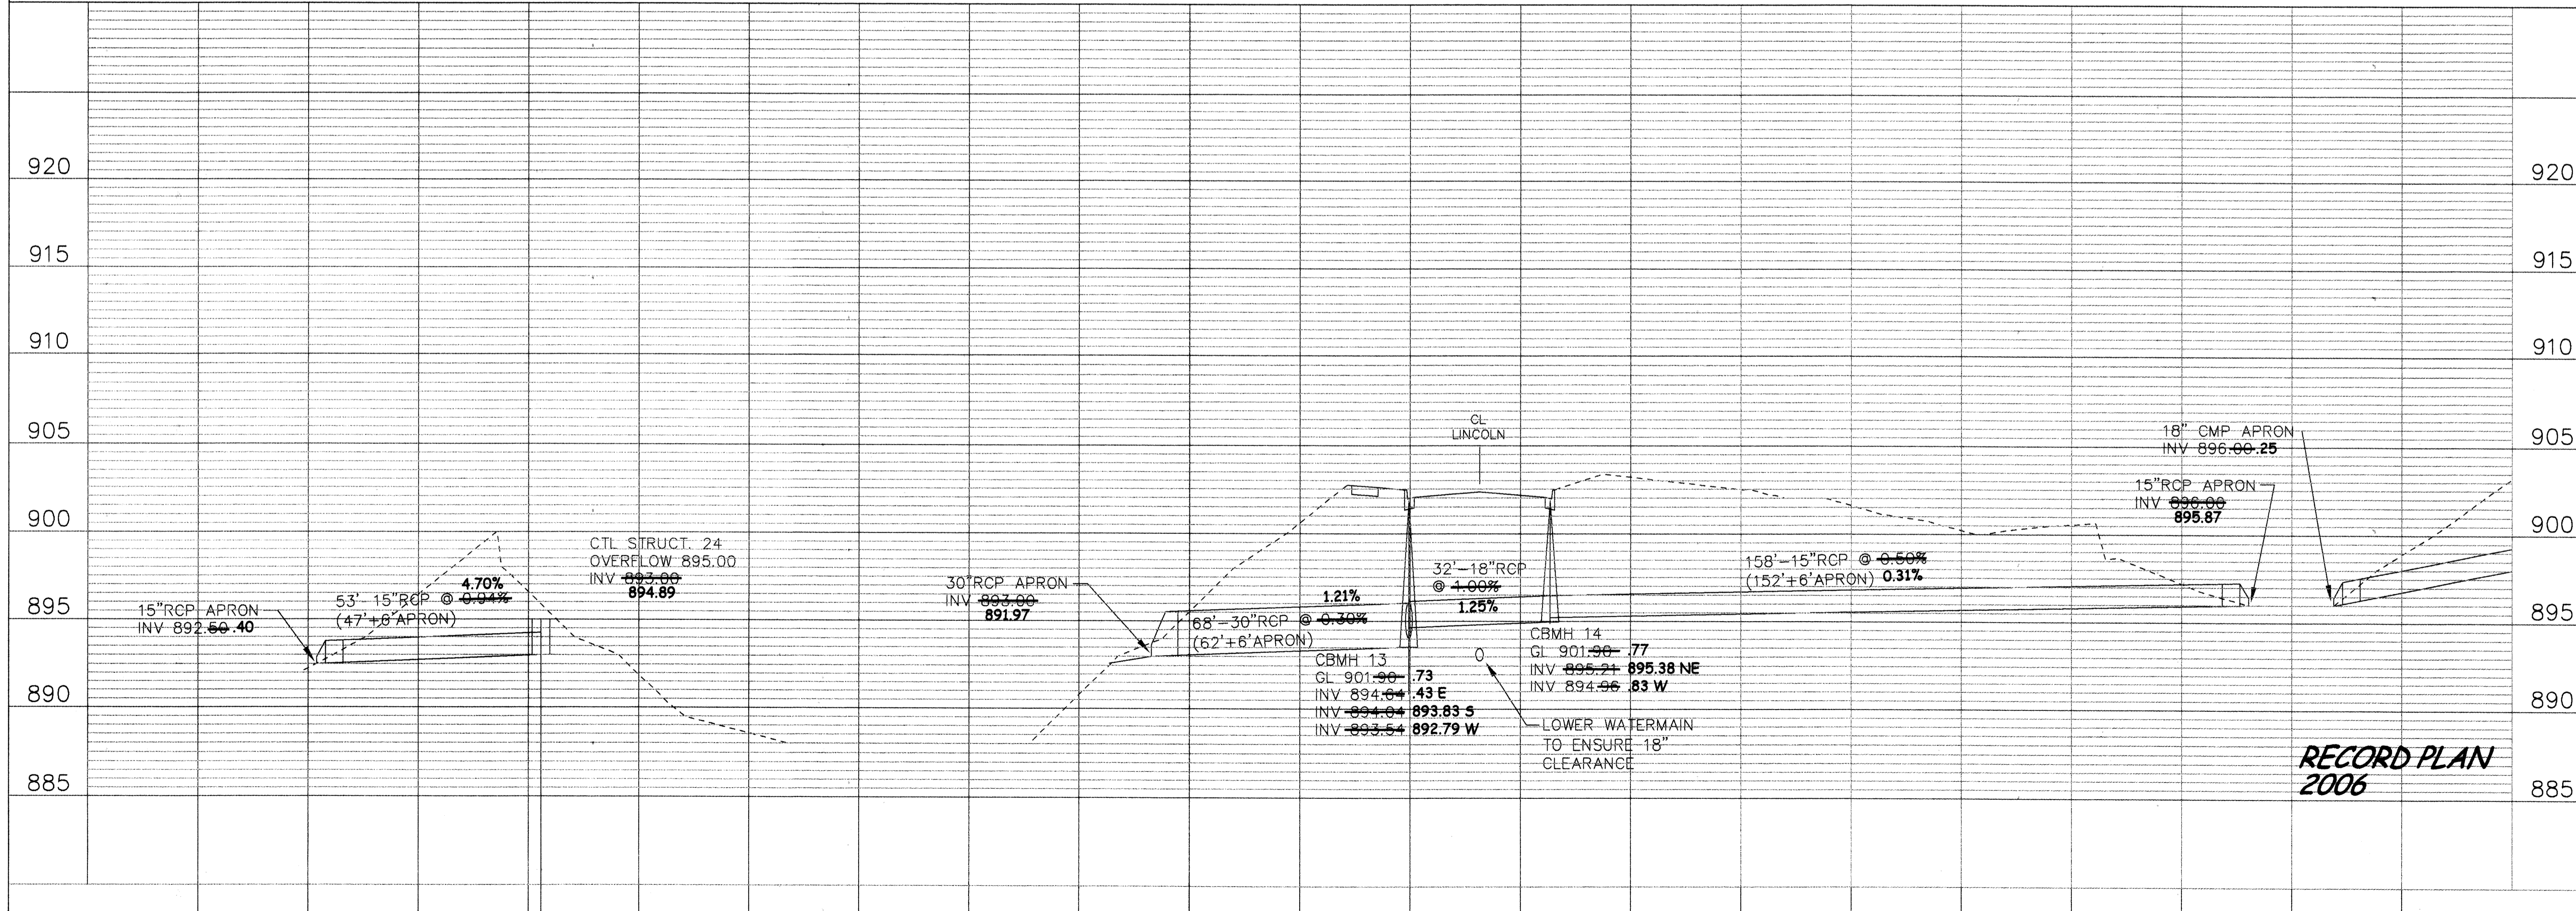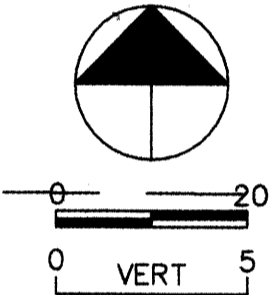

15" RCP APRON  
INV 892.60.40

53' 15" RCP @ 4.70%  
(47' ± 6" APRON)

CTL STRUCT. 24  
OVERFLOW 895.00  
INV 893.00  
894.89

30" RCP APRON  
INV 892.00  
891.97

68' 30" RCP @ 1.21%  
(62' ± 6" APRON)

CBMH 13  
GL 901.30 .73  
INV 894.04 .43 E  
INV 894.04 893.83 S  
INV 893.54 892.79 W

32' 18" RCP  
@ 1.25%

CBMH 14  
GL 901.00 .77  
INV 895.21 895.38 NE  
INV 894.06 .83 W

LOWER WATERMAIN  
TO ENSURE 18"  
CLEARANCE

158' 15" RCP @ 0.50%  
(152' ± 6" APRON) 0.31%

18" CMP APRON  
INV 896.00.25

15" RCP APRON  
INV 896.00  
895.87

**RECORD PLAN  
2006**

**RIVERSIDE COMPANIES  
EAGLES MARSH 2ND ADDITION  
PLAN AND PROFILE  
STORM SEWER AT LINCOLN STREET**

**BDM**  
CONSULTING ENGINEERS, PLC  
Engineers and Surveyors  
4176 Level Road, Suite 112  
Lexington, MN 55014  
Phone: (763) 786-4570  
Fax: (763) 786-4574  
bdmce.com

DRAWN BY: JL  
CHECKED BY: JMA  
DESIGNED BY: JL  
JOB NO. 226088

SHEET **P14** SHEETS **26**

I HEREBY CERTIFY THAT THIS PLAN,  
SPECIFICATION OR REPORT WAS  
PREPARED BY ME OR UNDER MY  
SUPERVISION AND THAT I AM A DULY  
LICENSED PROFESSIONAL ENGINEER UNDER  
THE LAWS OF THE STATE OF MINNESOTA.

JOHN M. ANDERSON  
March 17, 2006 25889  
DATE LIC. NO.

REVISIONS	NO.	DATE	BY	DESCRIPTION
	01/27/08	EY	AS-BUILT PER CITY	