



# C.S.A.H. NO.12

NOTE:  
CONTRACTOR TO REMOVE  
AND REPLACE EXISTING  
BITUMINOUS AS DIRECTED  
BY ENGINEER

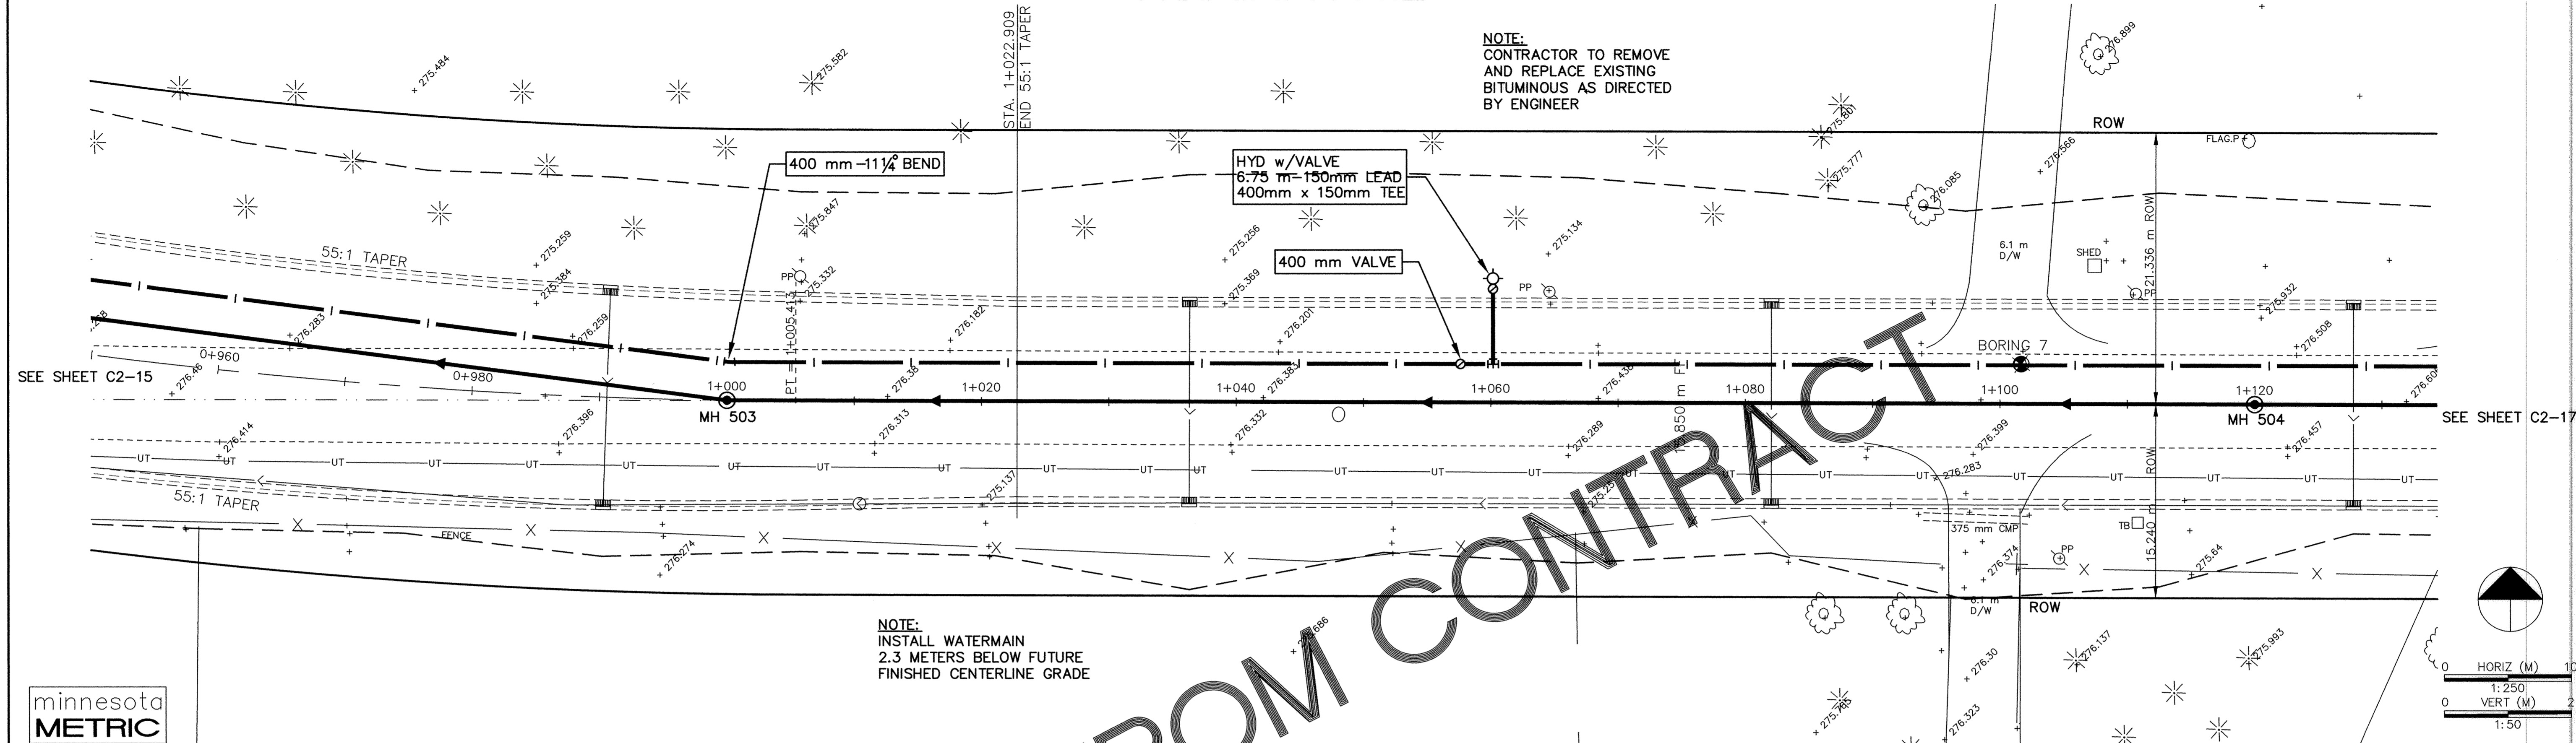

minnesota  
METRIC

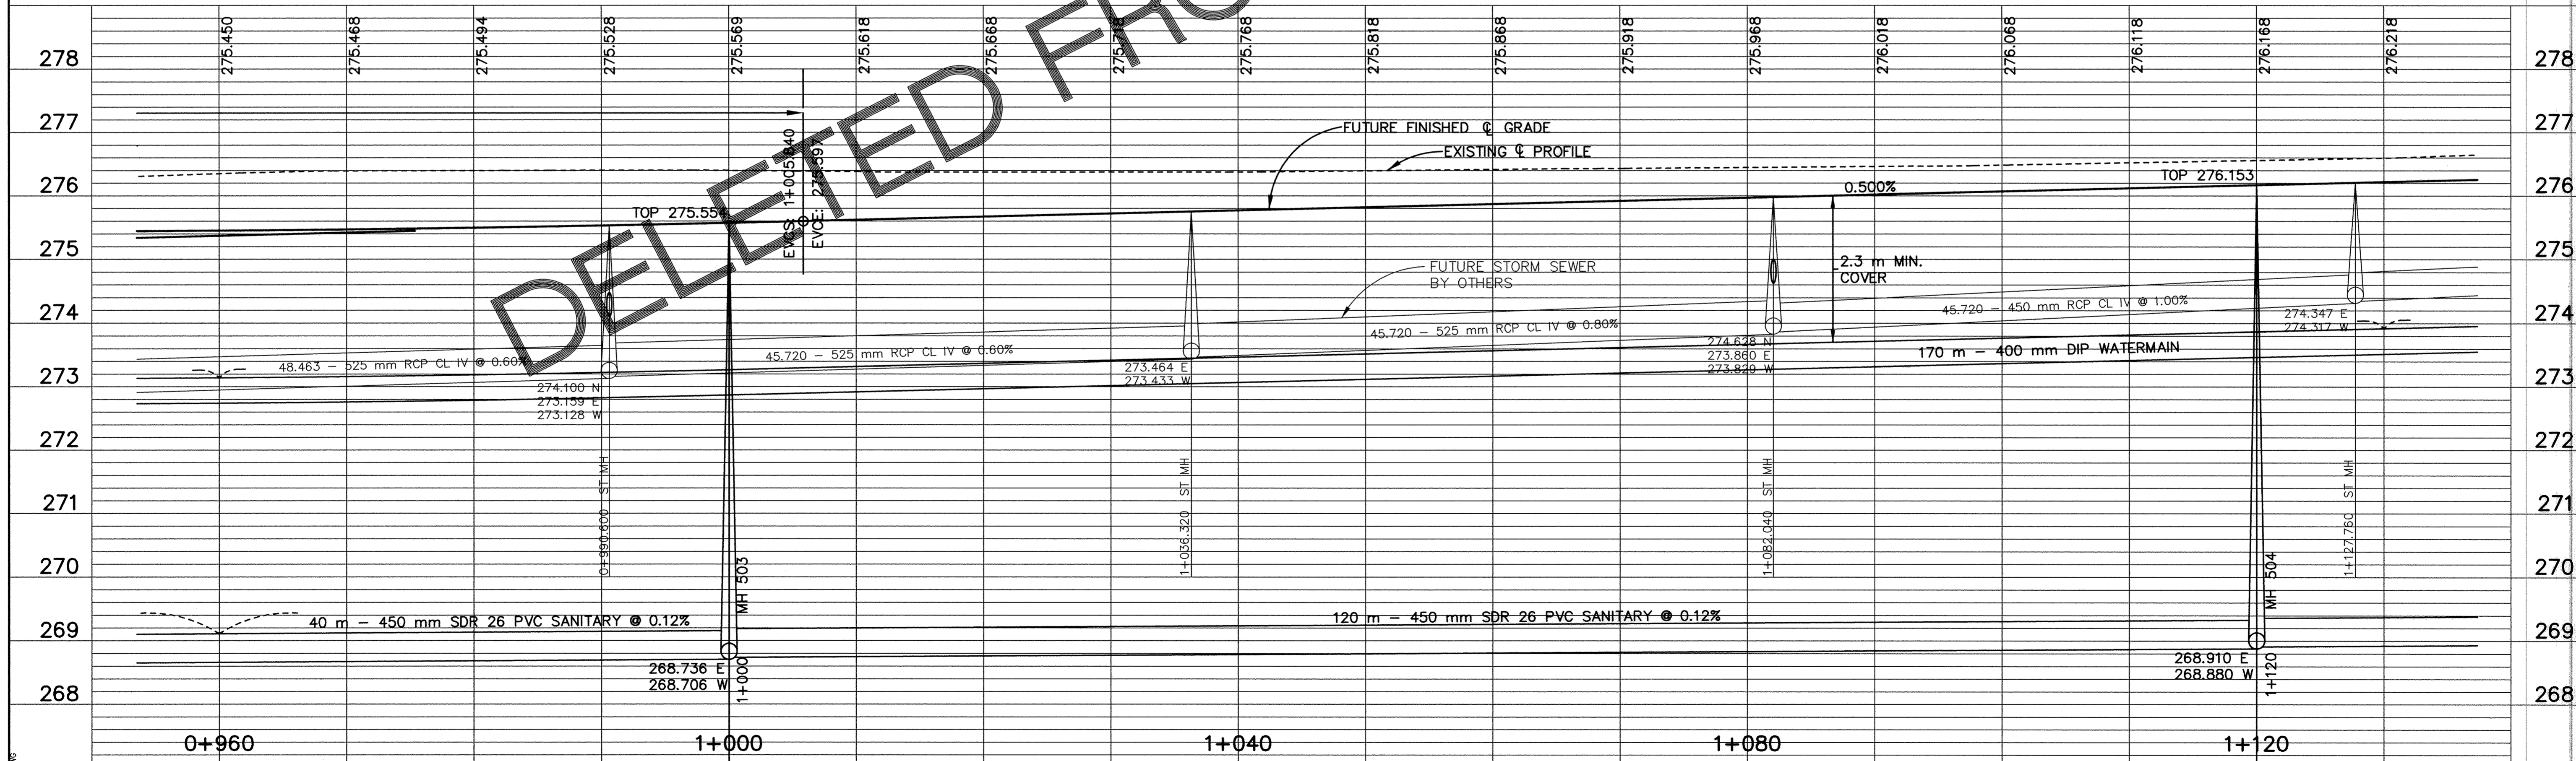

DESIGNED BY: \_\_\_\_\_ JOB DATE: JULY 1998  
 DRAWN BY: *one* JOB NUMBER: 800110J  
 APPROVED: \_\_\_\_\_ CAD DATE: JULY 1998  
 CAD FILE: February 08, 1999 1:56:04 p.m.  
 800110J\DWG\BALDWIN\15.DWG

I HEREBY CERTIFY THAT THIS PLAN, SPECIFICATION,  
 OR REPORT WAS PREPARED BY ME OR UNDER MY DIRECT  
 SUPERVISION AND THAT I AM A DULY REGISTERED  
 PROFESSIONAL ENGINEER UNDER THE LAWS OF THE  
 STATE OF MINNESOTA.  
 DATE: \_\_\_\_\_ REG. NO. 15316

NO.	DATE	BY	REVISION DESCRIPTION
1	1-19-99	PH	C.O. NO. 1

1326 ENERGY PARK DRIVE  
 ST. PAUL, MINNESOTA 55108  
 (612) 644-4389  
  
 Howard R. Green Company  
 CONSULTING ENGINEERS

CITY OF ELK RIVER  
 EASTERN AREA  
 PHASE I IMPROVEMENTS

WATERMAIN IMPROVEMENTS  
 C.S.A.H. NO.12  
 0+960 TO 1+130

SHEET NO.  
**C2-16**

EASTE11.98  
 101  
 SAICO PRODUCTS • NEW HOPK, MINNESOTA  
 REORDER BY PART NUMBER 8558  
 SAICO PRODUCTS • NEW HOPK, MINNESOTA  
 REORDER BY PART NUMBER 8558  
 SAICO PRODUCTS • NEW HOPK, MINNESOTA  
 REORDER BY PART NUMBER 8558  
 SAICO PRODUCTS • NEW HOPK, MINNESOTA  
 REORDER BY PART NUMBER 8558