


UPA FORCEMAIN AND WATERMAIN

NOTE:
ALL WORK WITHIN THE UPA PROPERTY
SHALL BE COORDINATED WITH THE PLANT
MANAGER MR. WAYNE HANSON @ (612)241-2209

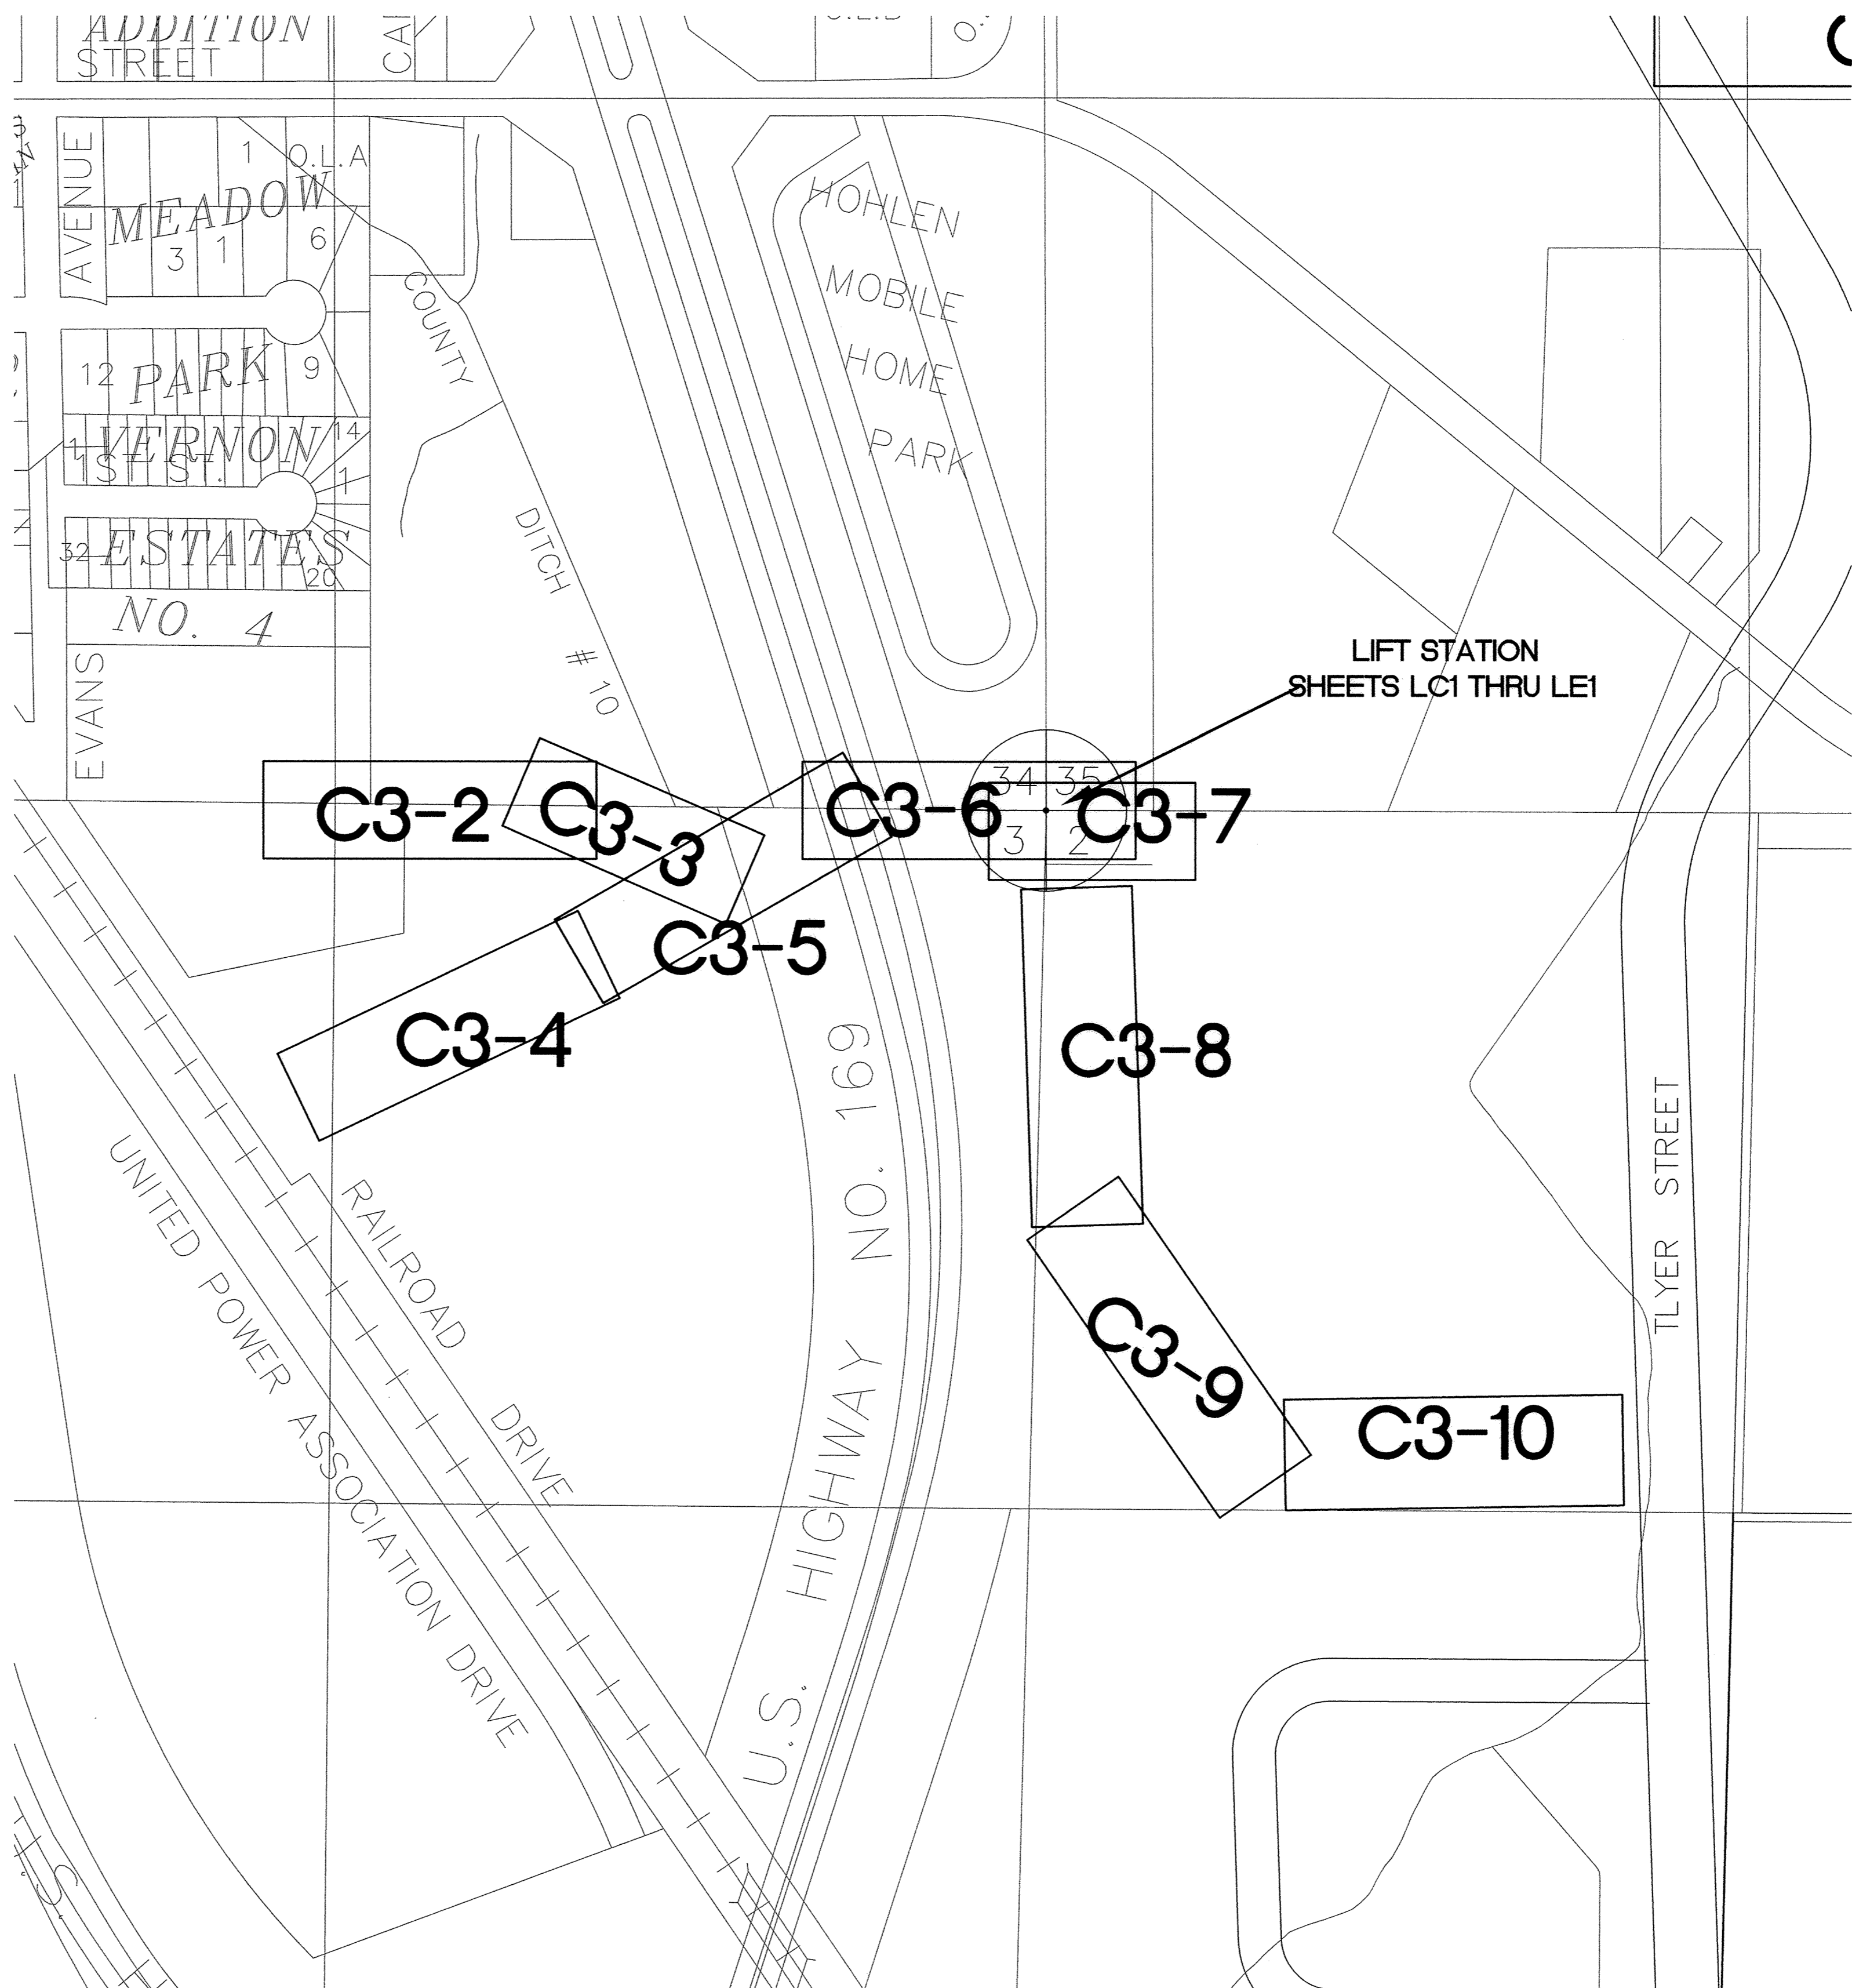

DESIGNED BY: AB JOB DATE: OCT 1998
DRAWN BY: *agj* JOB NUMBER: 800110J
APPROVED: _____ CAD DATE: _____
CAD FILE: March 29, 2001 11:12:28 a.m.
800110J\AS-BUILTS\ASL03.DWG

I HEREBY CERTIFY THAT THIS PLAN, SPECIFICATION,
OR REPORT WAS PREPARED BY ME OR UNDER MY DIRECT
SUPERVISION AND THAT I AM A DULY REGISTERED
PROFESSIONAL ENGINEER UNDER THE LAWS OF THE
STATE OF MINNESOTA.
DATE: 10/15/98 REG. NO. 15316

NO.	DATE	BY	REVISION DESCRIPTION

 1326 ENERGY PARK DRIVE
ST. PAUL, MINNESOTA 55108
(612) 644-4389
Howard R. Green Company
CONSULTING ENGINEERS

CITY OF ELK RIVER
EASTERN AREA
PHASE I IMPROVEMENTS

STREET AND UTILITY IMPROVEMENTS
LOCATION MAP
UPA PROPERTY

SHEET NO.
C3-1

SACCO PRODUCTS • NEW HOPE, MINNESOTA
 REVISIONS BY PART NUMBER 8552
 SACCO PRODUCTS • NEW HOPE, MINNESOTA
 REVISIONS BY PART NUMBER 8552
 SACCO PRODUCTS • NEW HOPE, MINNESOTA
 REVISIONS BY PART NUMBER 8552
 SACCO PRODUCTS • NEW HOPE, MINNESOTA
 REVISIONS BY PART NUMBER 8552