



# 173RD AVENUE, ULYSSES STREET, 171ST AVENUE, AND RAIL 10 ADDITION

## RAIL 10 AREA

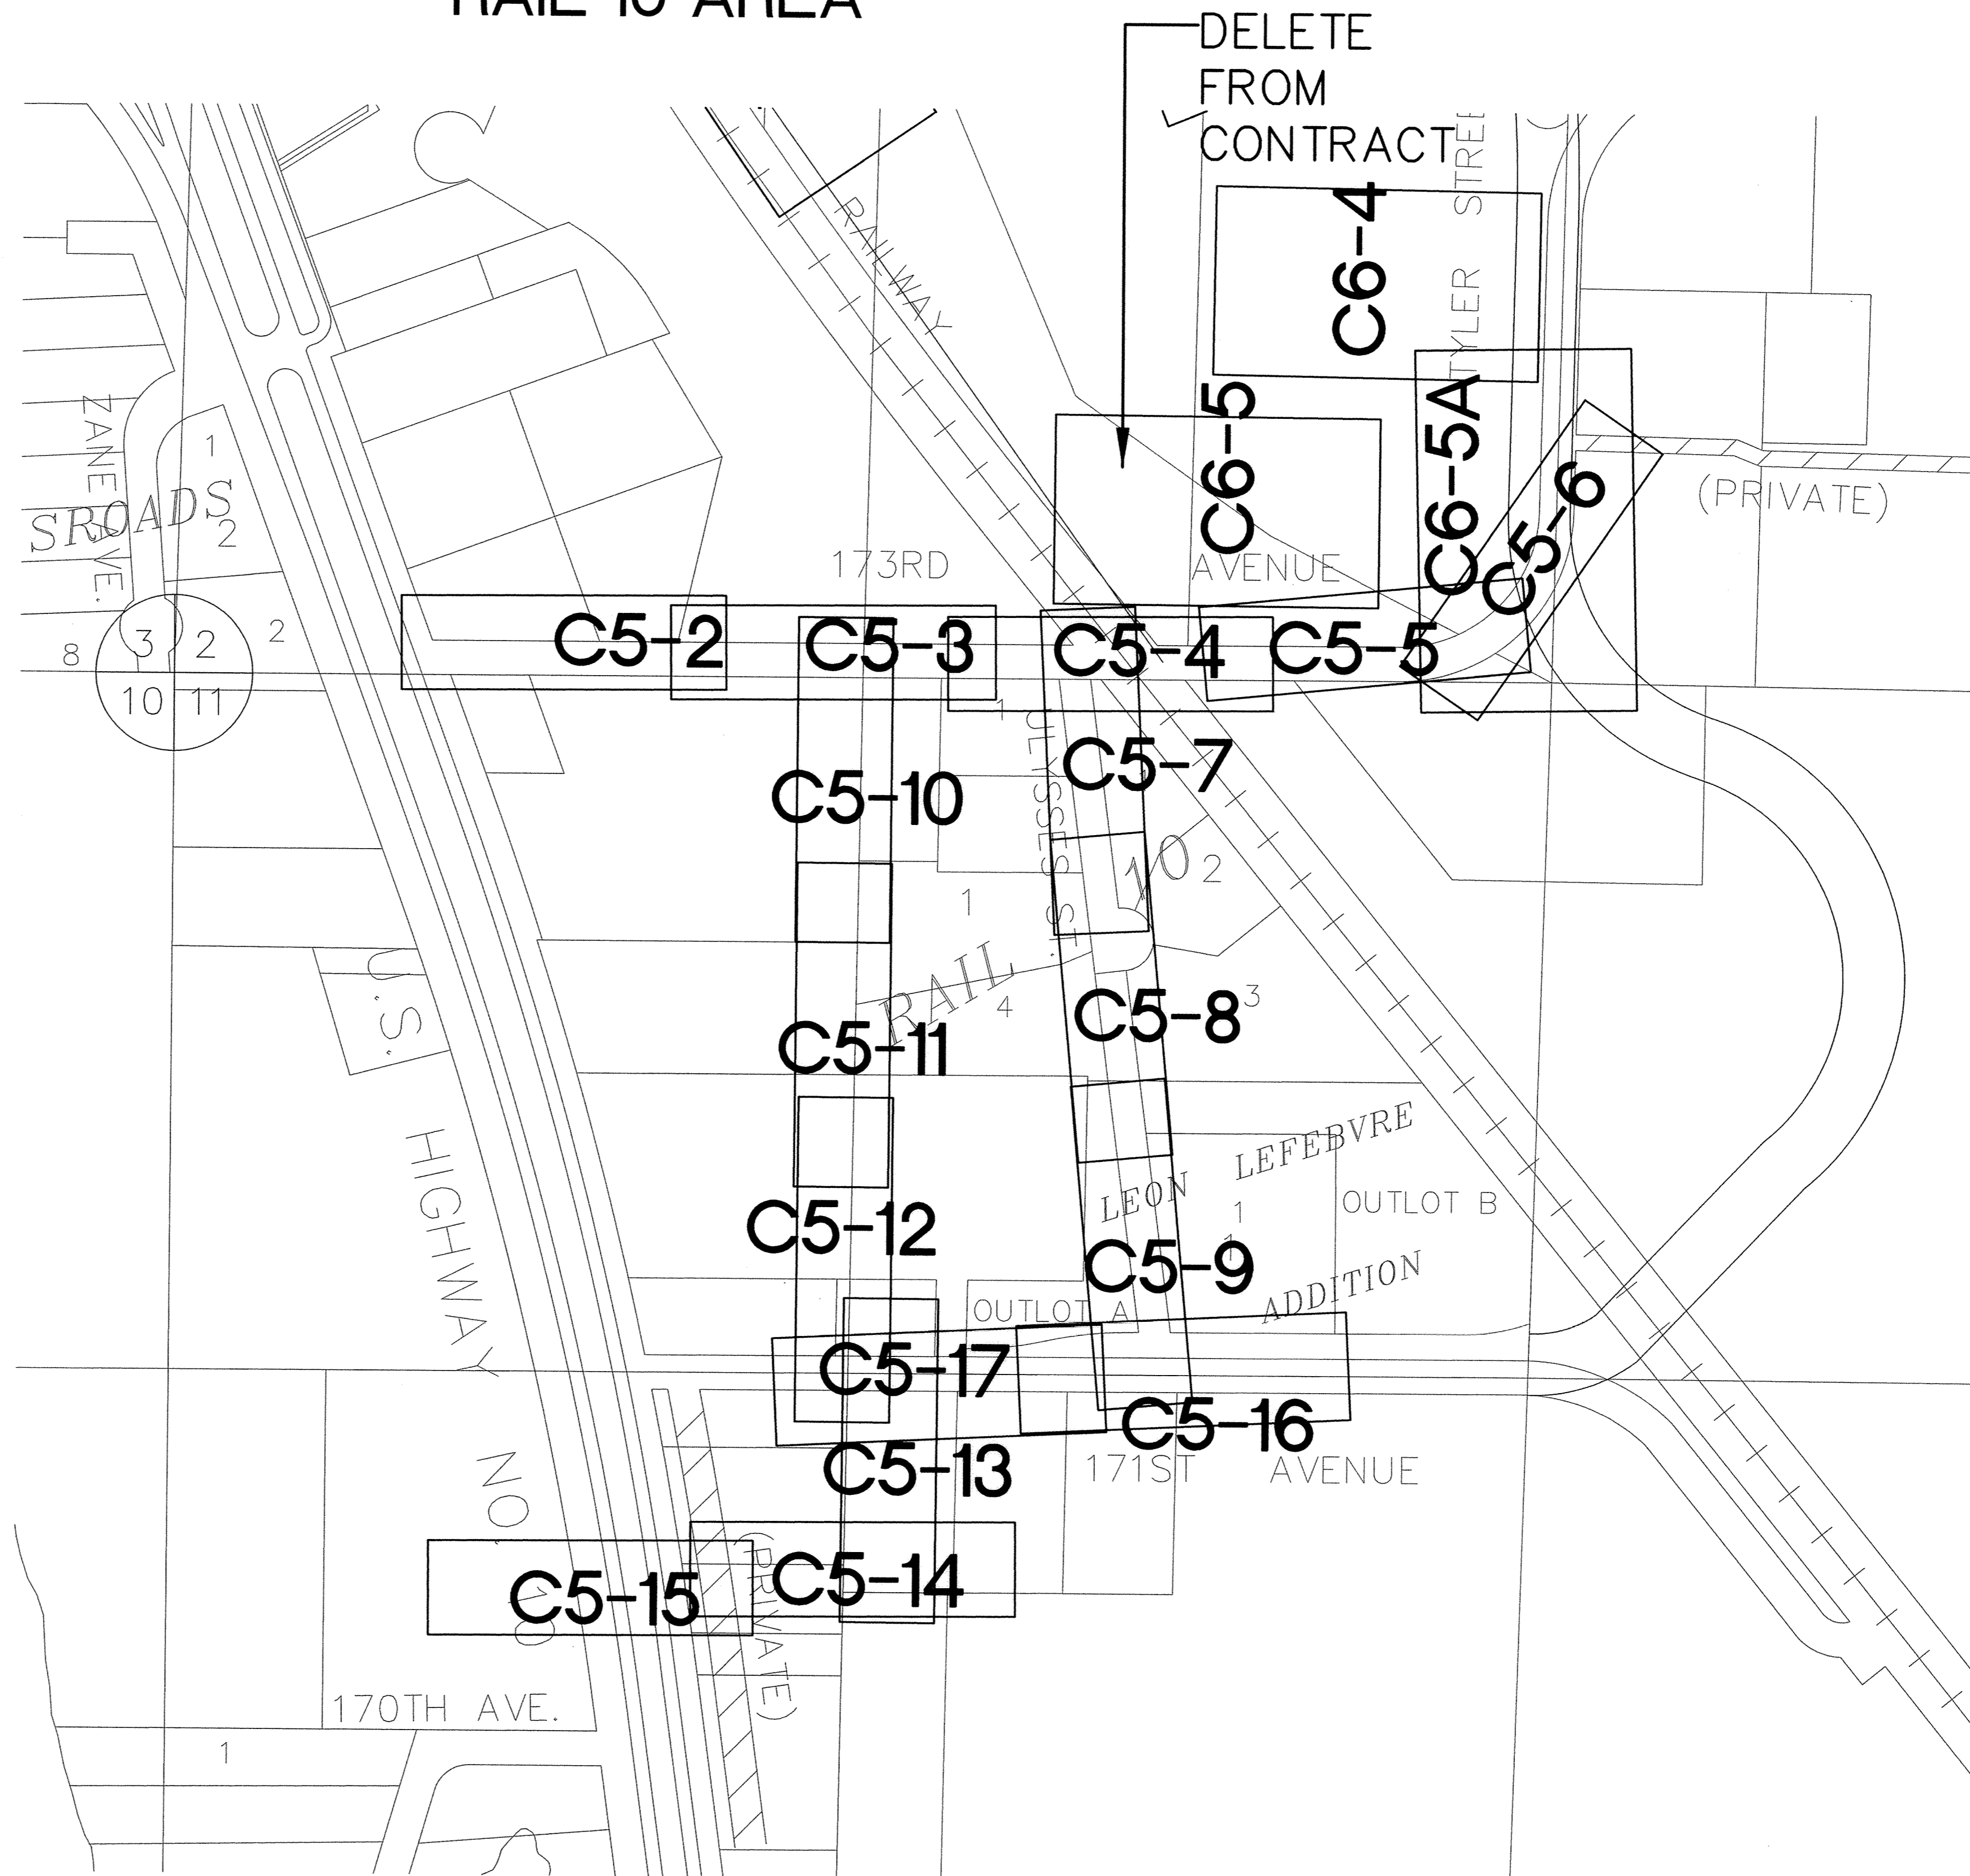

**NOTES:**

1. 173RD AVENUE SHALL BE REMOVED AND REPLACED TO EXISTING GRADE AND ALIGNMENT.
2. SANITARY SEWER AND WATER SERVICE SIZES AND LOCATIONS SHALL BE FIELD VERIFIED.

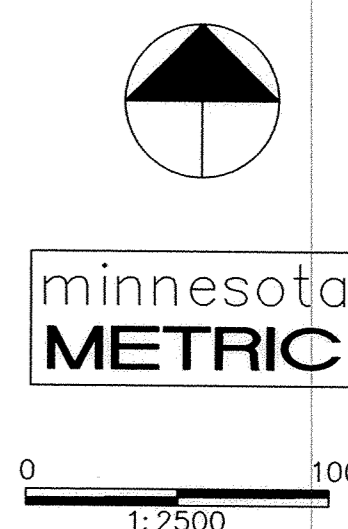

DESIGNED BY: AB JOB DATE: MARCH 1998  
 DRAWN BY: [Signature] JOB NUMBER: 800110J  
 APPROVED: \_\_\_\_\_ CAD DATE: \_\_\_\_\_  
 CAD FILE: 800110\AS-BUILTS\Misc\ASL02.DWG

I HEREBY CERTIFY THAT THIS PLAN, SPECIFICATION, OR REPORT WAS PREPARED BY ME OR UNDER MY DIRECT SUPERVISION AND THAT I AM A DULY REGISTERED PROFESSIONAL ENGINEER UNDER THE LAWS OF THE STATE OF MINNESOTA.  
 DATE: 10/15/98 REG. NO.: 15316

NO.	DATE	BY	REVISION DESCRIPTION
1	4/21/99	LK	DELET FROM CONTRACT



1326 ENERGY PARK DRIVE  
 ST. PAUL, MINNESOTA 55108  
 (612) 644-4389  
**Howard R. Green Company**  
 CONSULTING ENGINEERS

CITY OF ELK RIVER  
 EASTERN AREA  
 PHASE I IMPROVEMENTS

STREET AND UTILITY IMPROVEMENTS  
 LOCATION MAP

SHEET NO.  
**C5-1**

SACCO PRODUCTS • NEW HOPE, MINNESOTA  
 REVISIONS BY PART NUMBER 8582  
 PREPARED BY: [Name]  
 DATE: [Date]  
 SCALE: [Scale]