

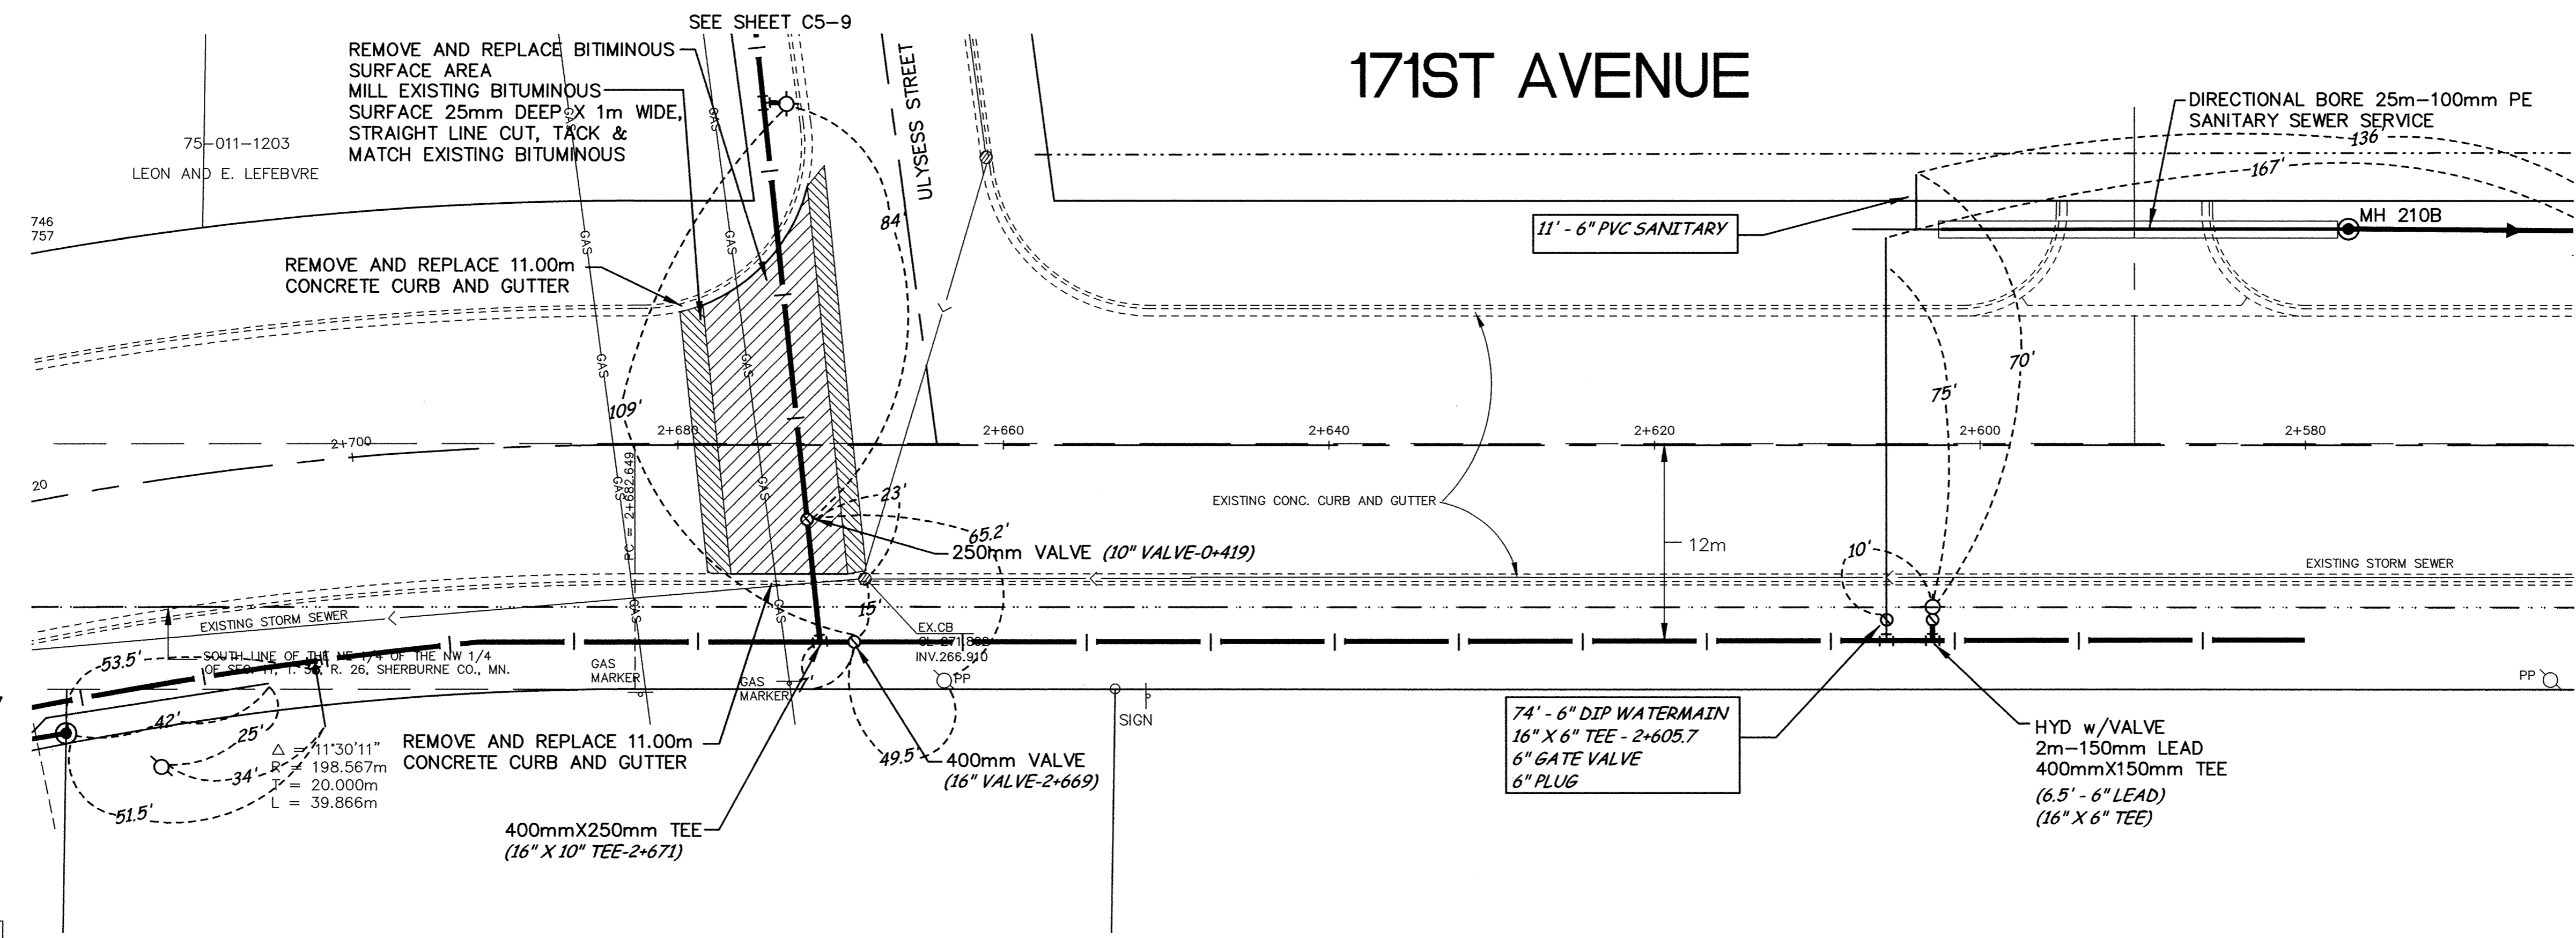


SD&C PRODUCTS - NEW HOPKINS, MINNESOTA
 REVISION BY PART NUMBER 0032
 SD&C PRODUCTS - NEW HOPKINS, MINNESOTA
 REVISION BY PART NUMBER 0032
 SD&C PRODUCTS - NEW HOPKINS, MINNESOTA
 REVISION BY PART NUMBER 0032
 SD&C PRODUCTS - NEW HOPKINS, MINNESOTA
 REVISION BY PART NUMBER 0032

171ST AVENUE

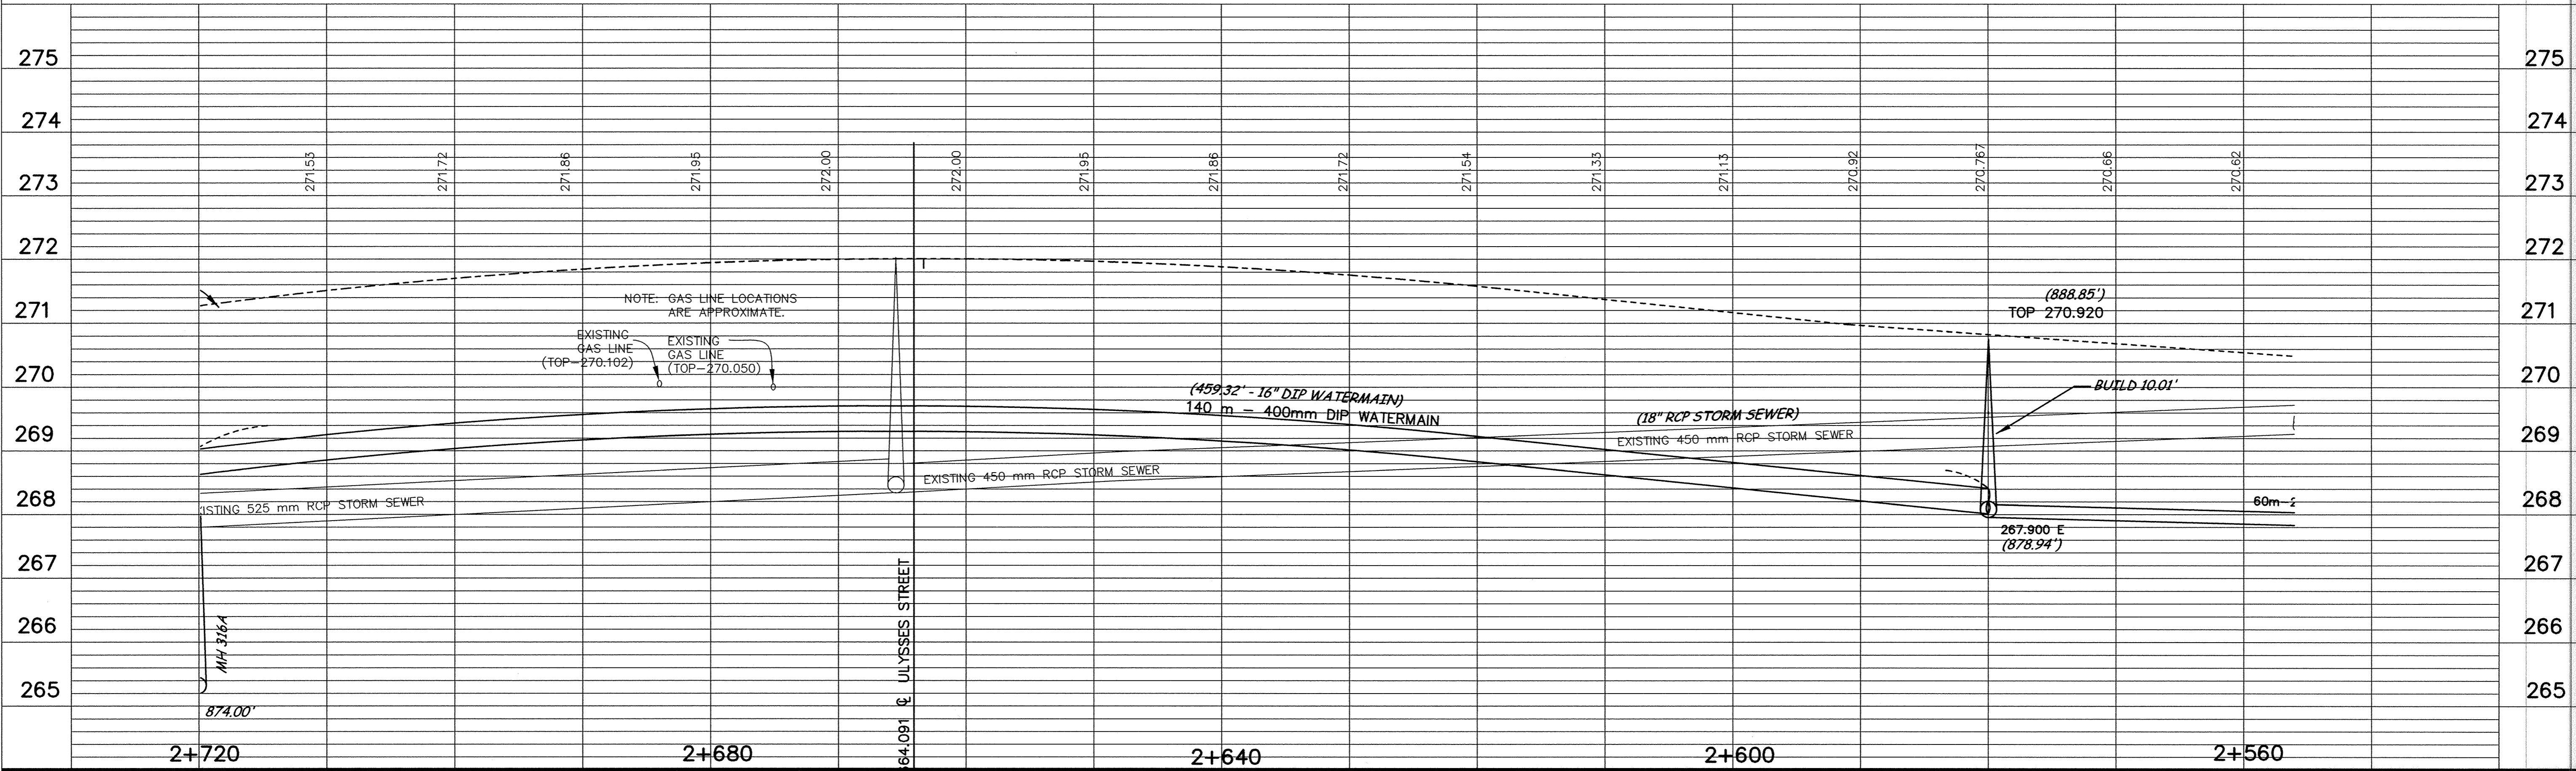

minnesota
METRIC

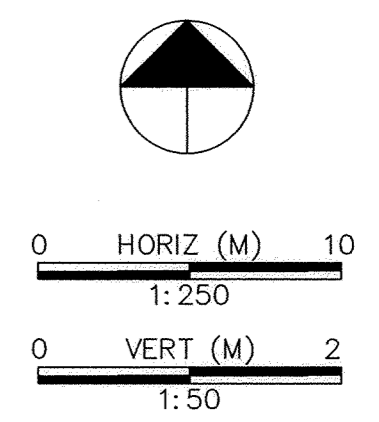

DESIGNED BY: AB JOB DATE: AUG 1998
 DRAWN BY: *[Signature]* JOB NUMBER: 800110J
 APPROVED: _____ CAD DATE: _____
 CAD FILE: October 14, 1998 2:42:06 p.m.
 800110J\Dwgs\171ST_WATERMAIN\C1-17.DWG

I HEREBY CERTIFY THAT THIS PLAN, SPECIFICATION,
 OR REPORT WAS PREPARED BY ME OR UNDER MY DIRECT
 SUPERVISION AND THAT I AM A DULY REGISTERED
 PROFESSIONAL ENGINEER UNDER THE LAWS OF THE
 STATE OF MINNESOTA.
 DATE 10/15/98 REG. NO. 15316

NO.	DATE	BY	REVISION DESCRIPTION


Howard R. Green Company
 CONSULTING ENGINEERS
 1326 ENERGY PARK DRIVE
 ST. PAUL, MINNESOTA 55108
 (612) 644-4389

CITY OF ELK RIVER
EASTERN AREA
PHASE I IMPROVEMENTS

STREET AND UTILITY IMPROVEMENTS
171ST AVENUE
 2+580 TO 2+720

SHEET NO.
C5-16