
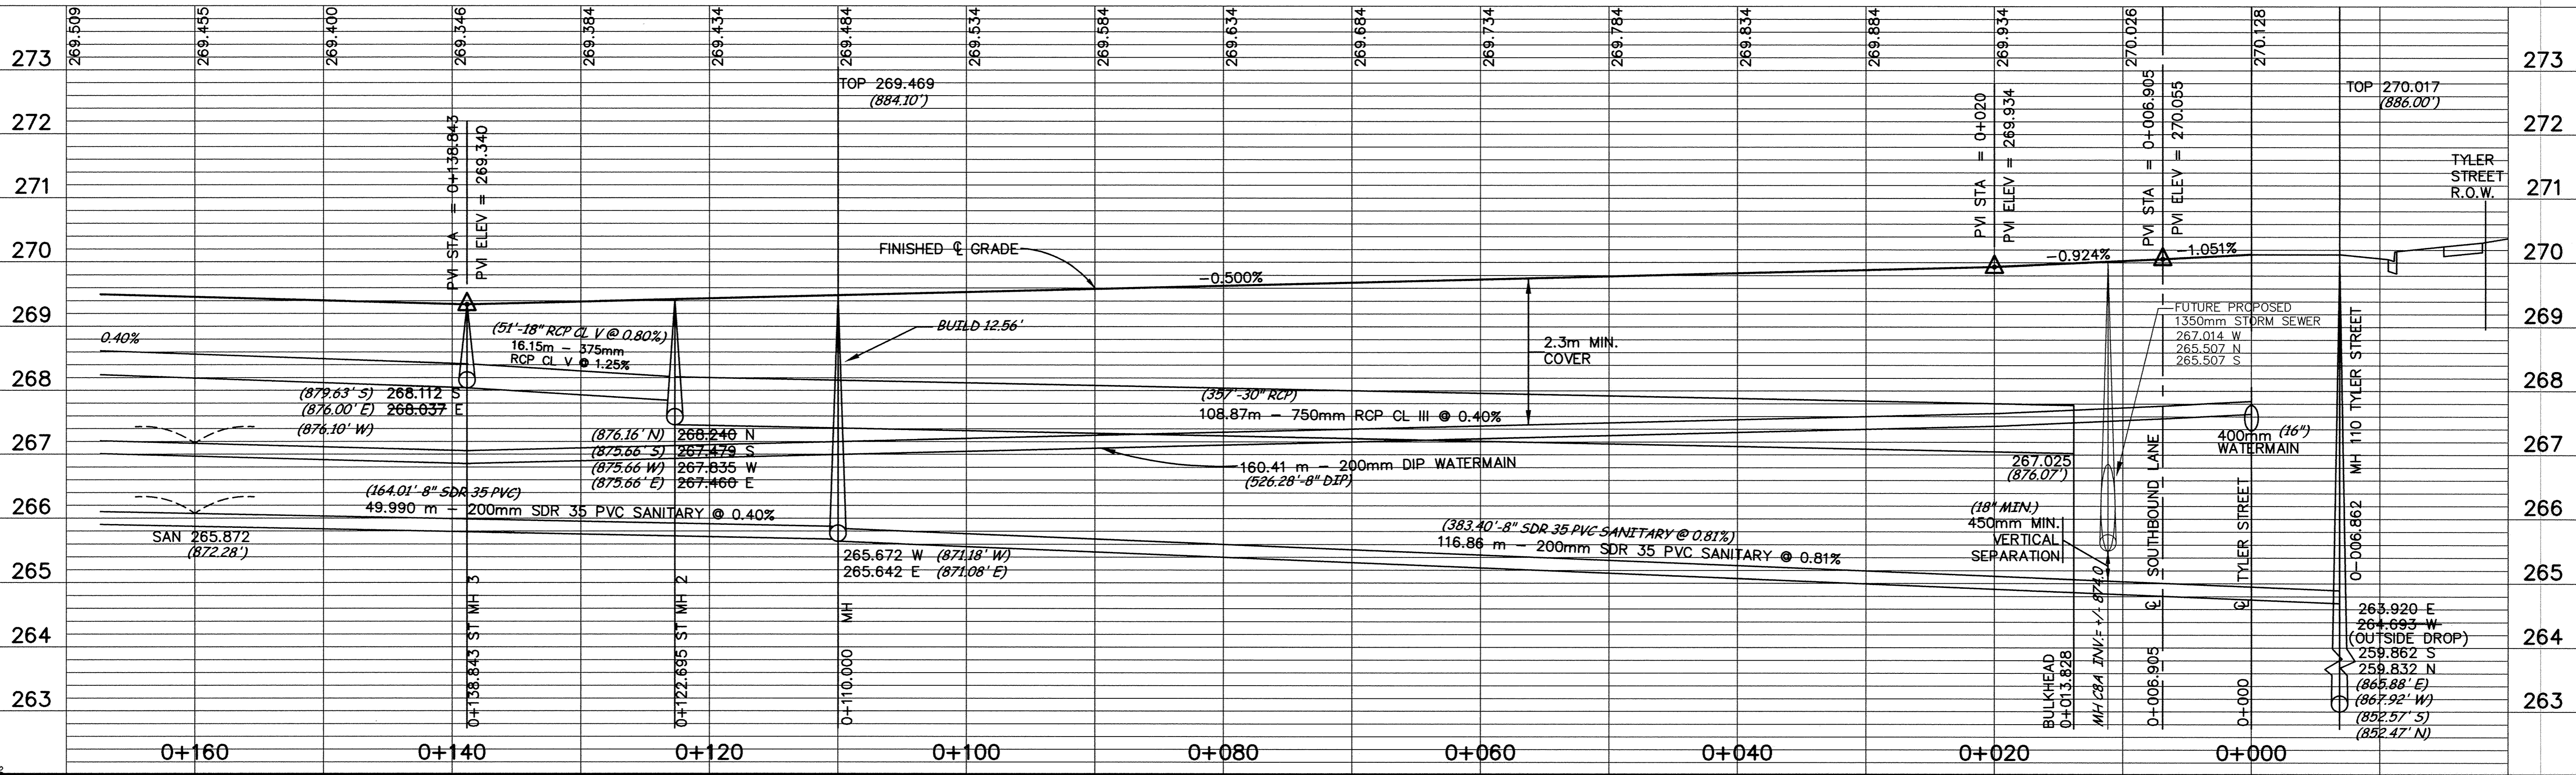
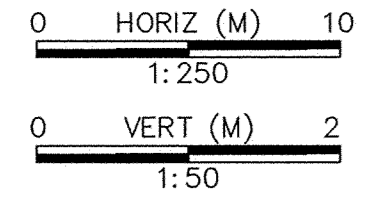


ELK RIVER BUSINESS PARK

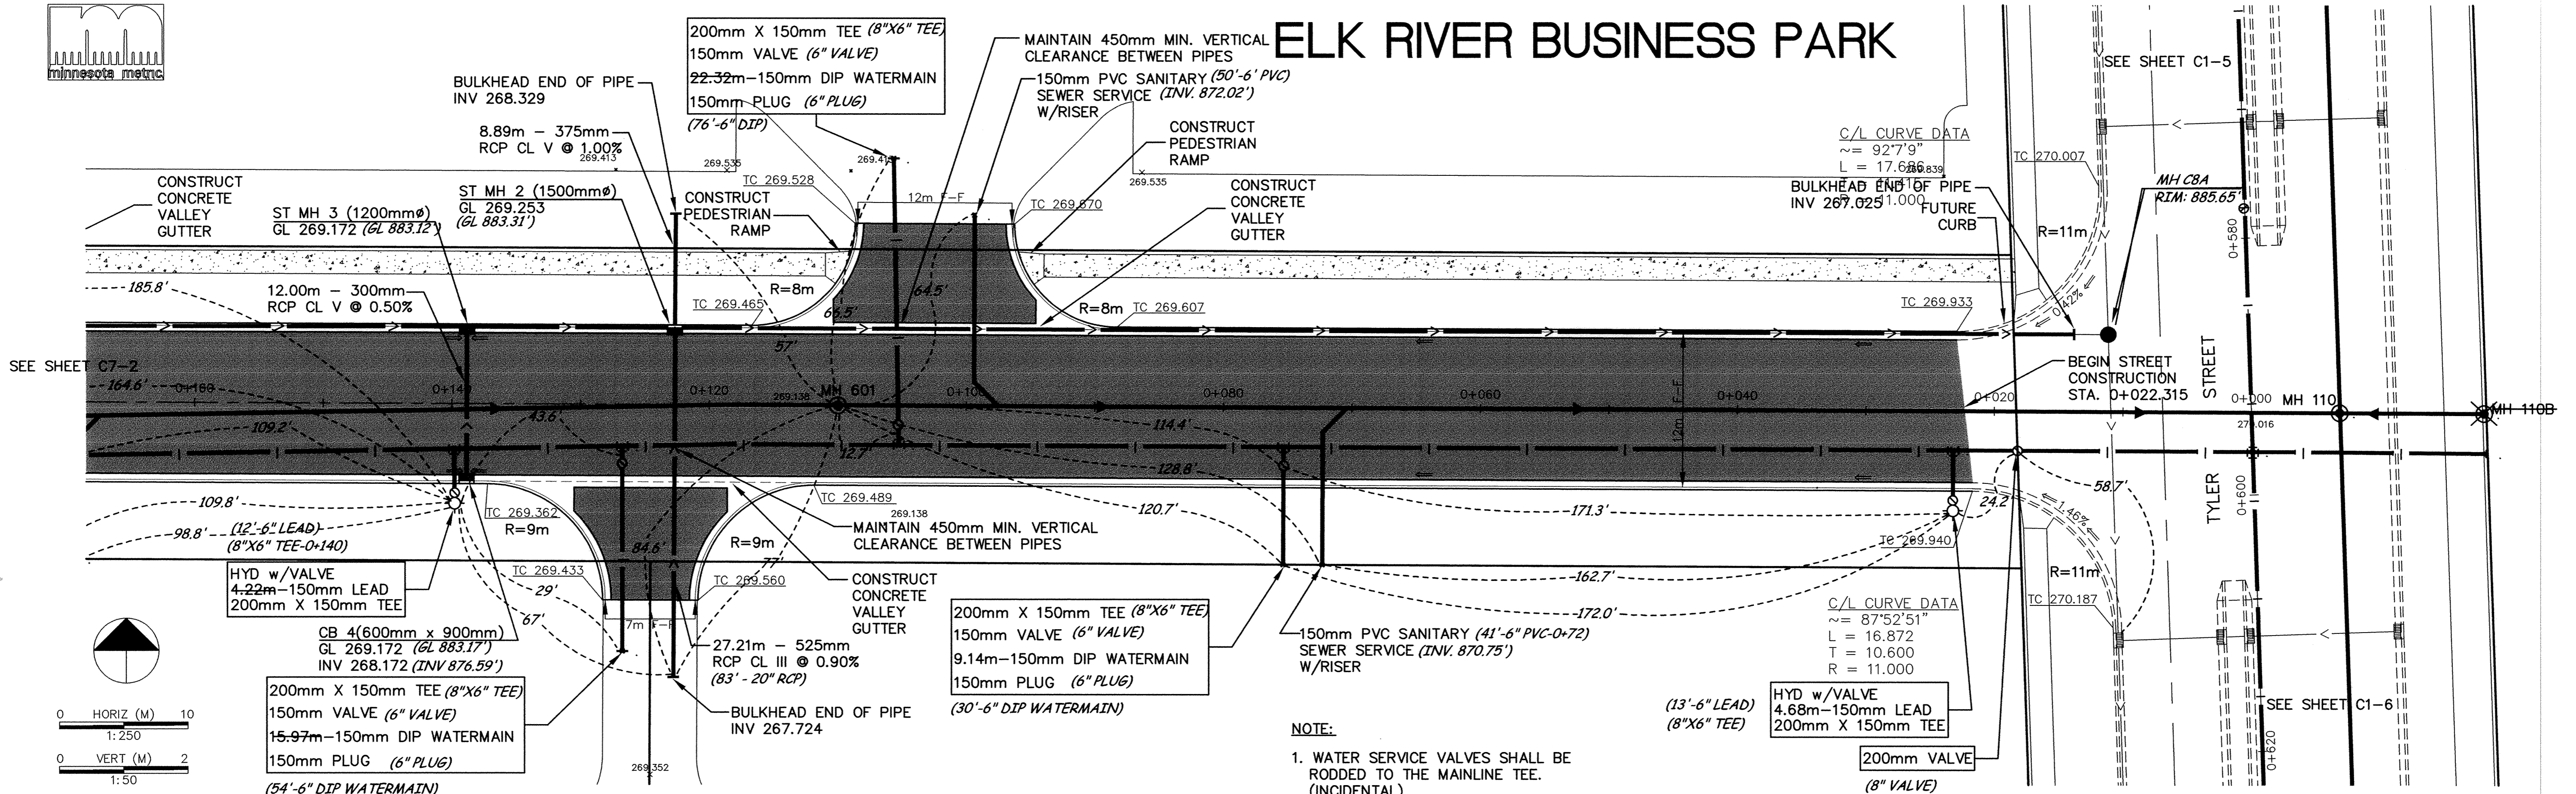

DESIGNED BY: JA JOB DATE: FEB 1999
 DRAWN BY: LK JOB NUMBER: 800114J
 APPROVED: CAD DATE:
 CAD FILE: March 02, 1999 2:06:48 p.m.
 800114J\800114_P1.DWG

I HEREBY CERTIFY THAT THIS PLAN, SPECIFICATION, OR REPORT WAS PREPARED BY ME OR UNDER MY DIRECT SUPERVISION AND THAT I AM A DULY REGISTERED PROFESSIONAL ENGINEER UNDER THE LAWS OF THE STATE OF MINNESOTA.
 DATE: _____ REG. NO. _____

NO.	DATE	BY	REVISION DESCRIPTION
1	1/19/99	LK	CHANGE ORDER NO. 1

Howard R. Green Company
 CONSULTING ENGINEERS
 1326 ENERGY PARK DRIVE
 ST. PAUL, MINNESOTA 55108
 (612) 644-4389

CITY OF ELK RIVER
 EASTERN AREA
 PHASE I IMPROVEMENTS

STREET AND UTILITY IMPROVEMENTS
 ELK RIVER BUSINESS PARK
 0+000 TO 0+160

SHEET NO.
C7-1