
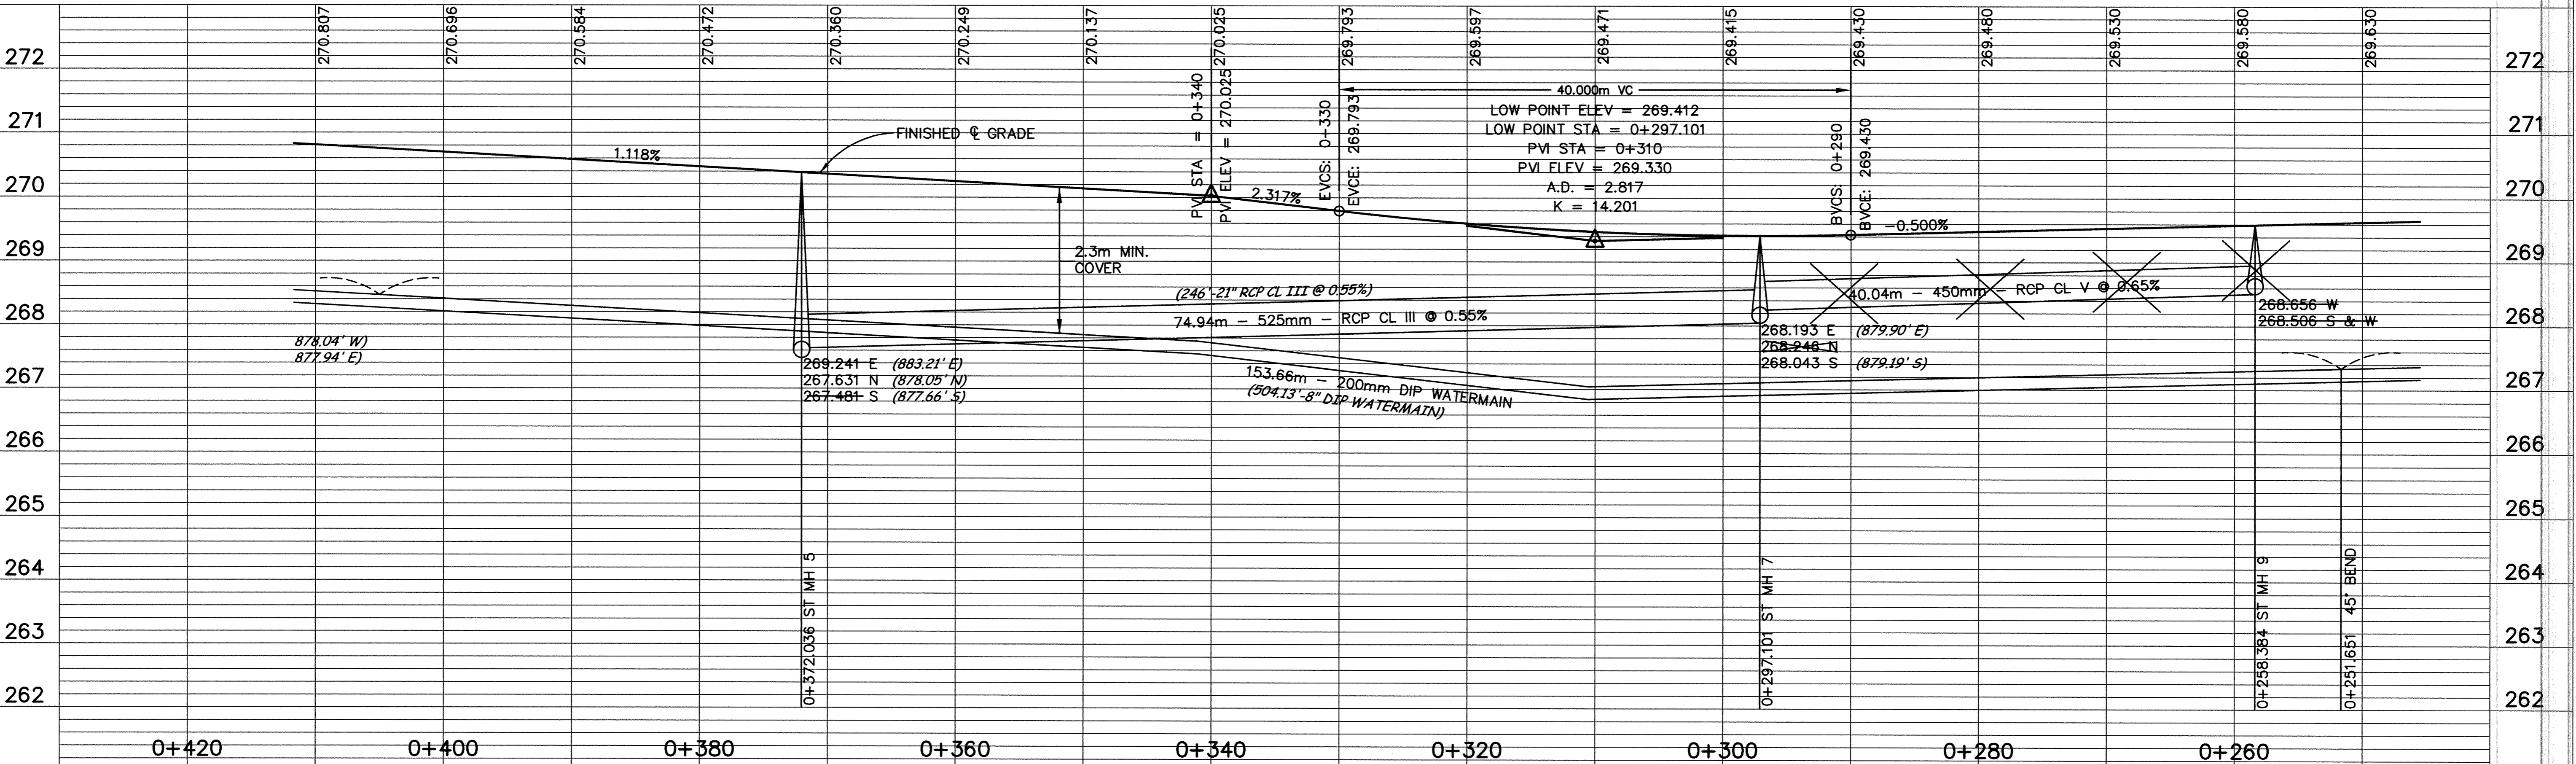


ELK RIVER BUSINESS PARK

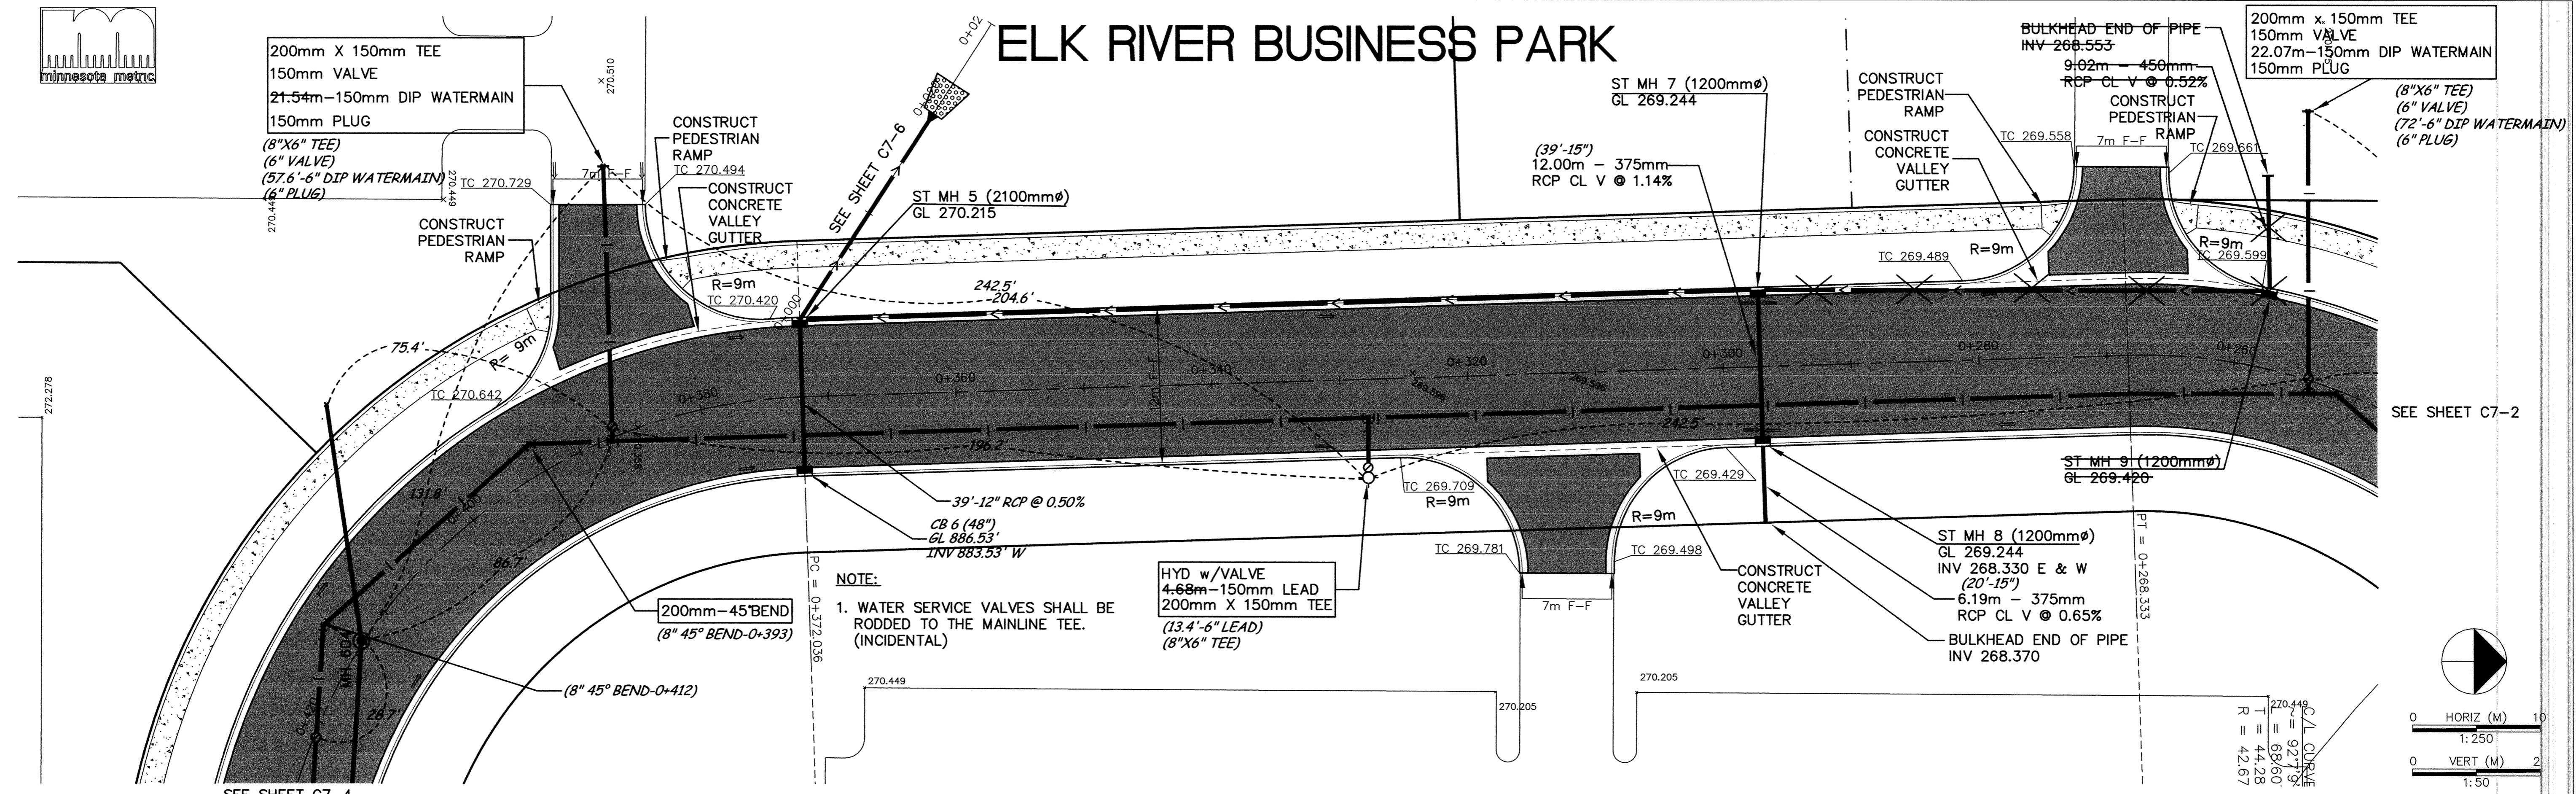

DESIGNED BY: JA JOB DATE: FEB 1999
 DRAWN BY: LK JOB NUMBER: 800114J
 APPROVED: _____ CAD DATE: _____
 CAD FILE: March 02, 1999 2:00:31 p.m.
 800114J\800114_P3.DWG

I HEREBY CERTIFY THAT THIS PLAN, SPECIFICATION,
 OR REPORT WAS PREPARED BY ME OR UNDER MY DIRECT
 SUPERVISION AND THAT I AM A DULY REGISTERED
 PROFESSIONAL ENGINEER UNDER THE LAWS OF THE
 STATE OF MINNESOTA.
 DATE: _____ REG.NO. _____

NO.	DATE	BY	REVISION DESCRIPTION
1	1/1/99	LK	CHANGE ORDER NO. 1

Howard R. Green Company
 CONSULTING ENGINEERS

1326 ENERGY PARK DRIVE
 ST. PAUL, MINNESOTA 55108
 (612) 644-4389

CITY OF ELK RIVER
EASTERN AREA
PHASE I IMPROVEMENTS

STREET AND UTILITY IMPROVEMENTS
ELK RIVER BUSINESS PARK
0+258.384 TO 0+405.00

SHEET NO.
C7-3