
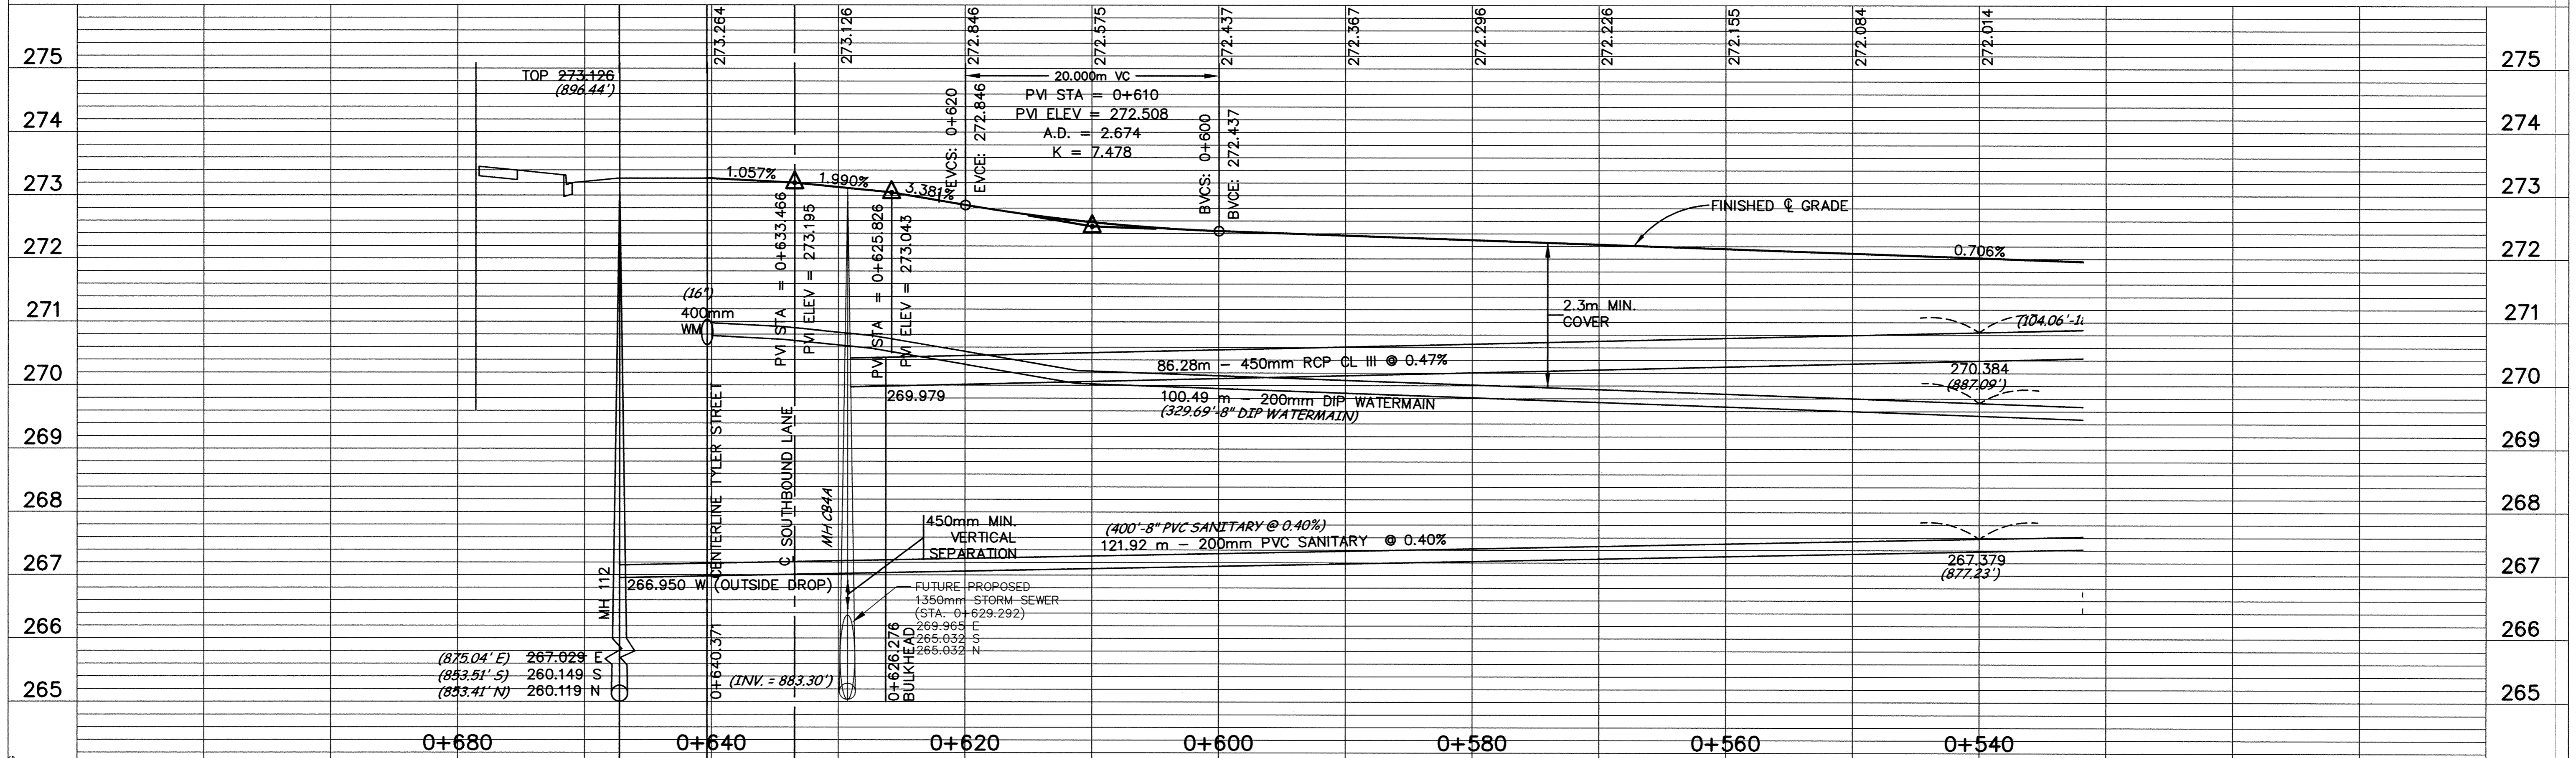
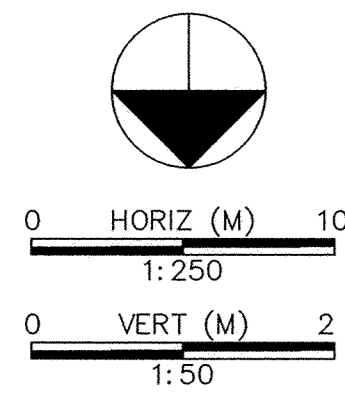


# ELK RIVER BUSINESS PARK

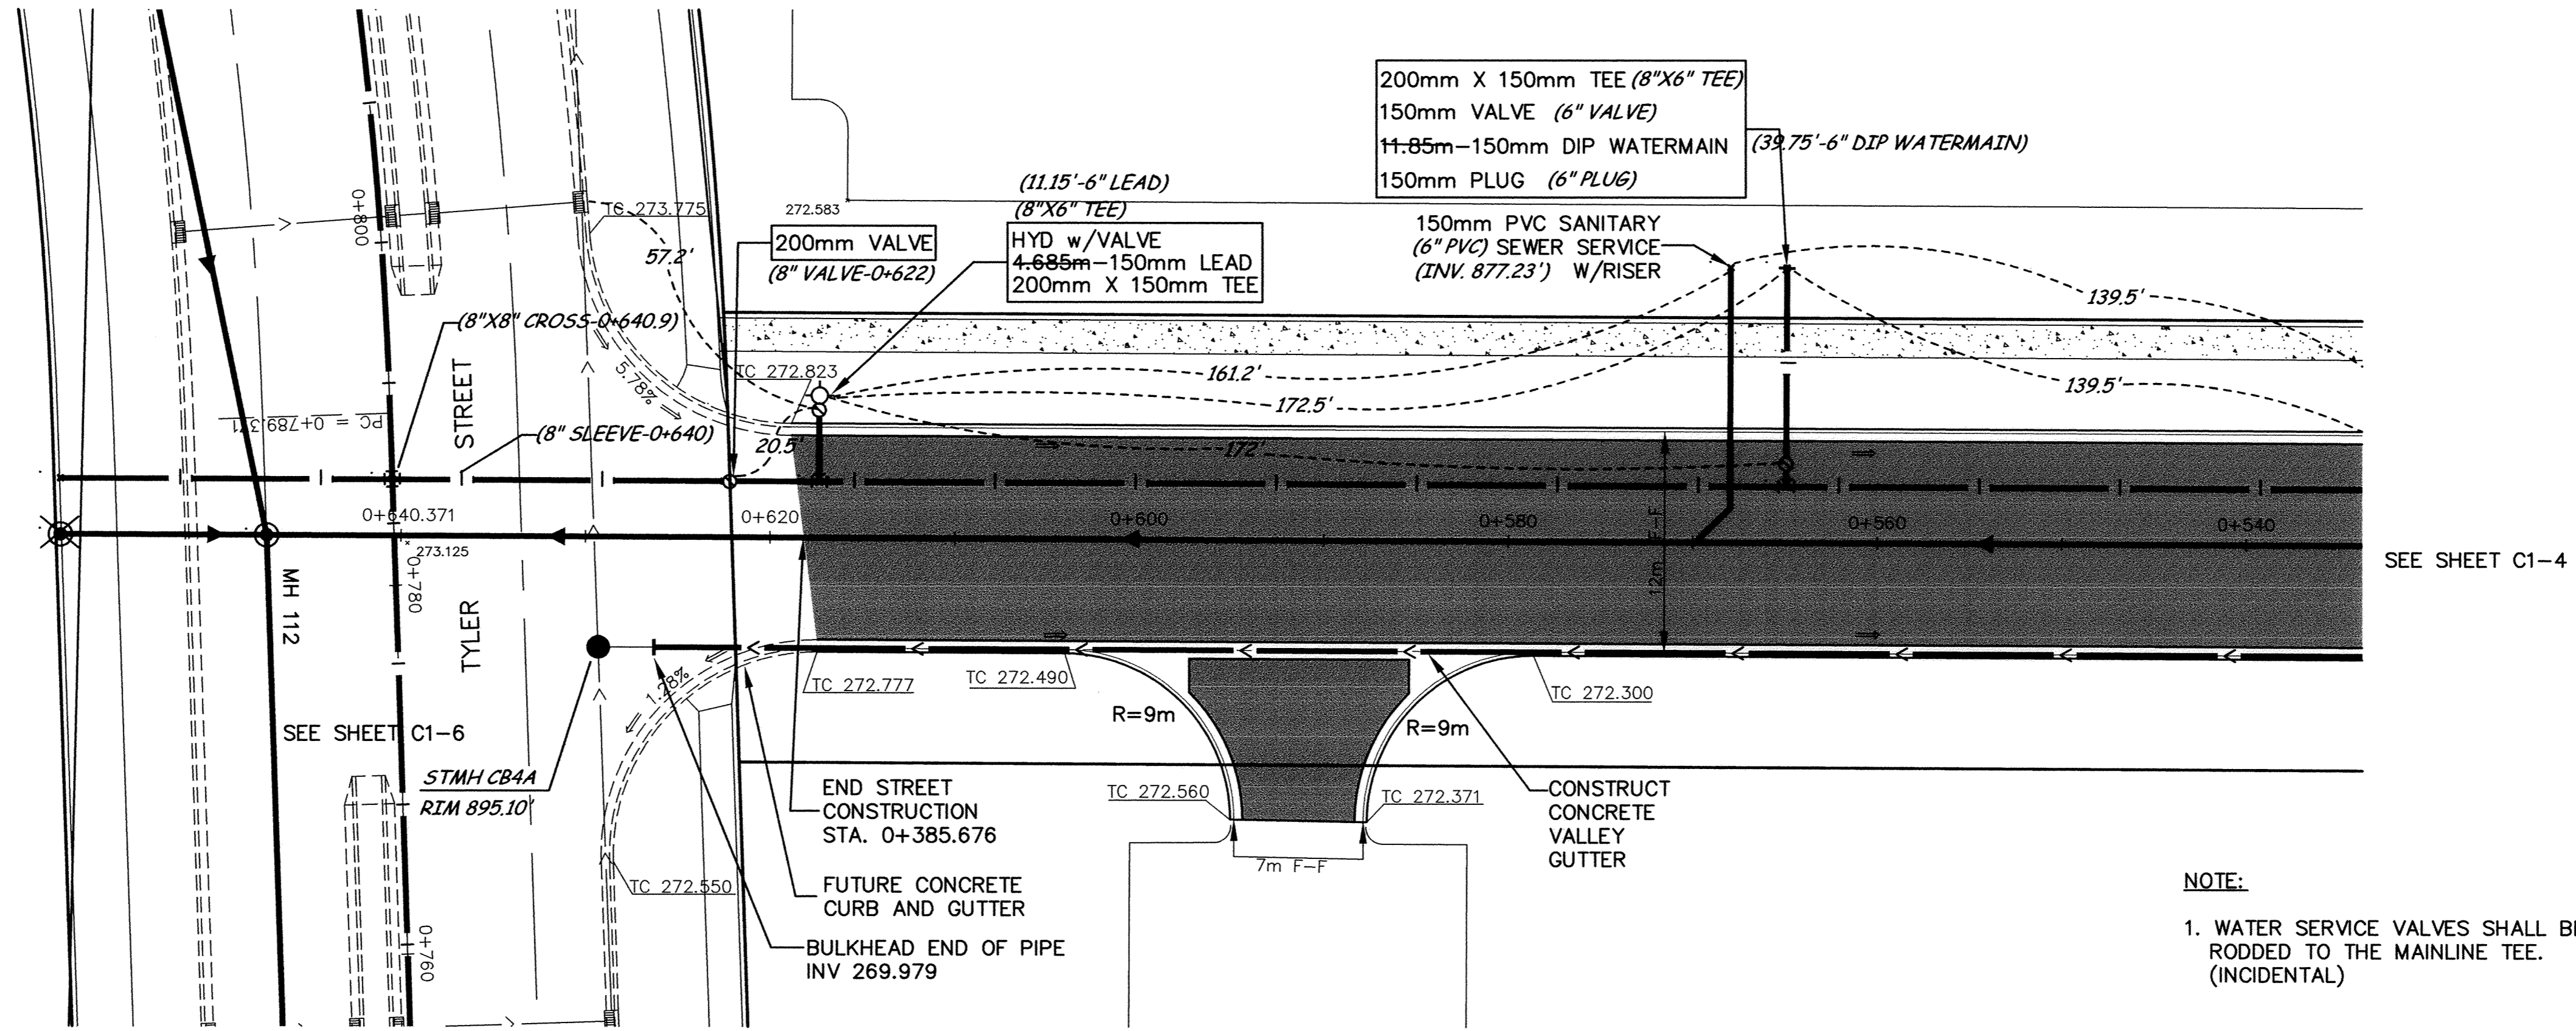

DESIGNED BY: JA JOB DATE: FEB 1999  
 DRAWN BY: LK JOB NUMBER: 800114J  
 APPROVED: CAD DATE:  
 CAD FILE: March 02, 1999 2:08:33 p.m.  
 800114J\800114\_P5.DWG

I HEREBY CERTIFY THAT THIS PLAN, SPECIFICATION, OR REPORT WAS PREPARED BY ME OR UNDER MY DIRECT SUPERVISION AND THAT I AM A DULY REGISTERED PROFESSIONAL ENGINEER UNDER THE LAWS OF THE STATE OF MINNESOTA.  
 DATE: REG. NO.:

NO.	DATE	BY	REVISION DESCRIPTION
1	1/19/99	LK	CHANGE ORDER NO. 1

1326 ENERGY PARK DRIVE  
 ST. PAUL, MINNESOTA 55108  
 (612) 644-4389  
**Howard R. Green Company**  
 CONSULTING ENGINEERS

**CITY OF ELK RIVER**  
**EASTERN AREA**  
**PHASE I IMPROVEMENTS**

**STREET AND UTILITY IMPROVEMENTS**  
**ELK RIVER BUSINESS PARK**  
 0+540 TO 0+640.371

SHEET NO.  
**C7-5**

DRAWING NUMBER EAST 1.98 161