
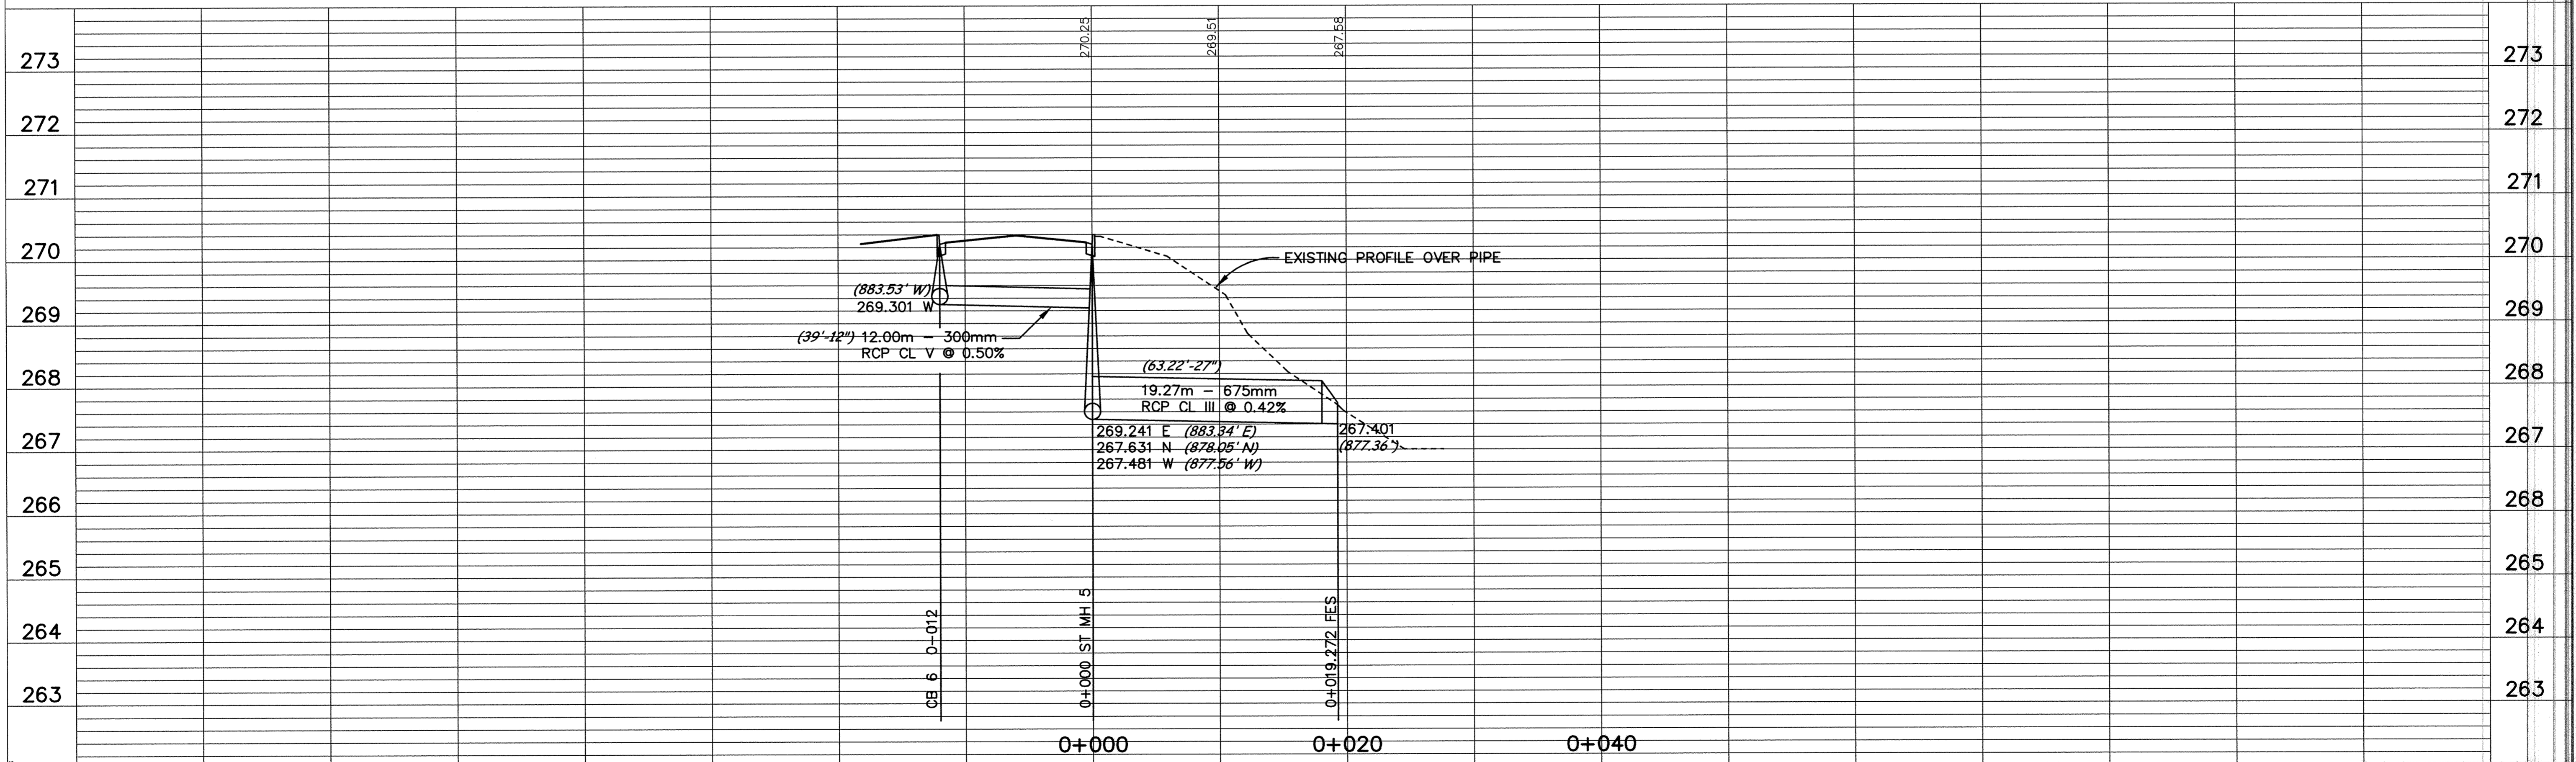
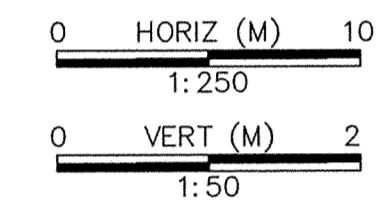


ELK RIVER BUSINESS PARK

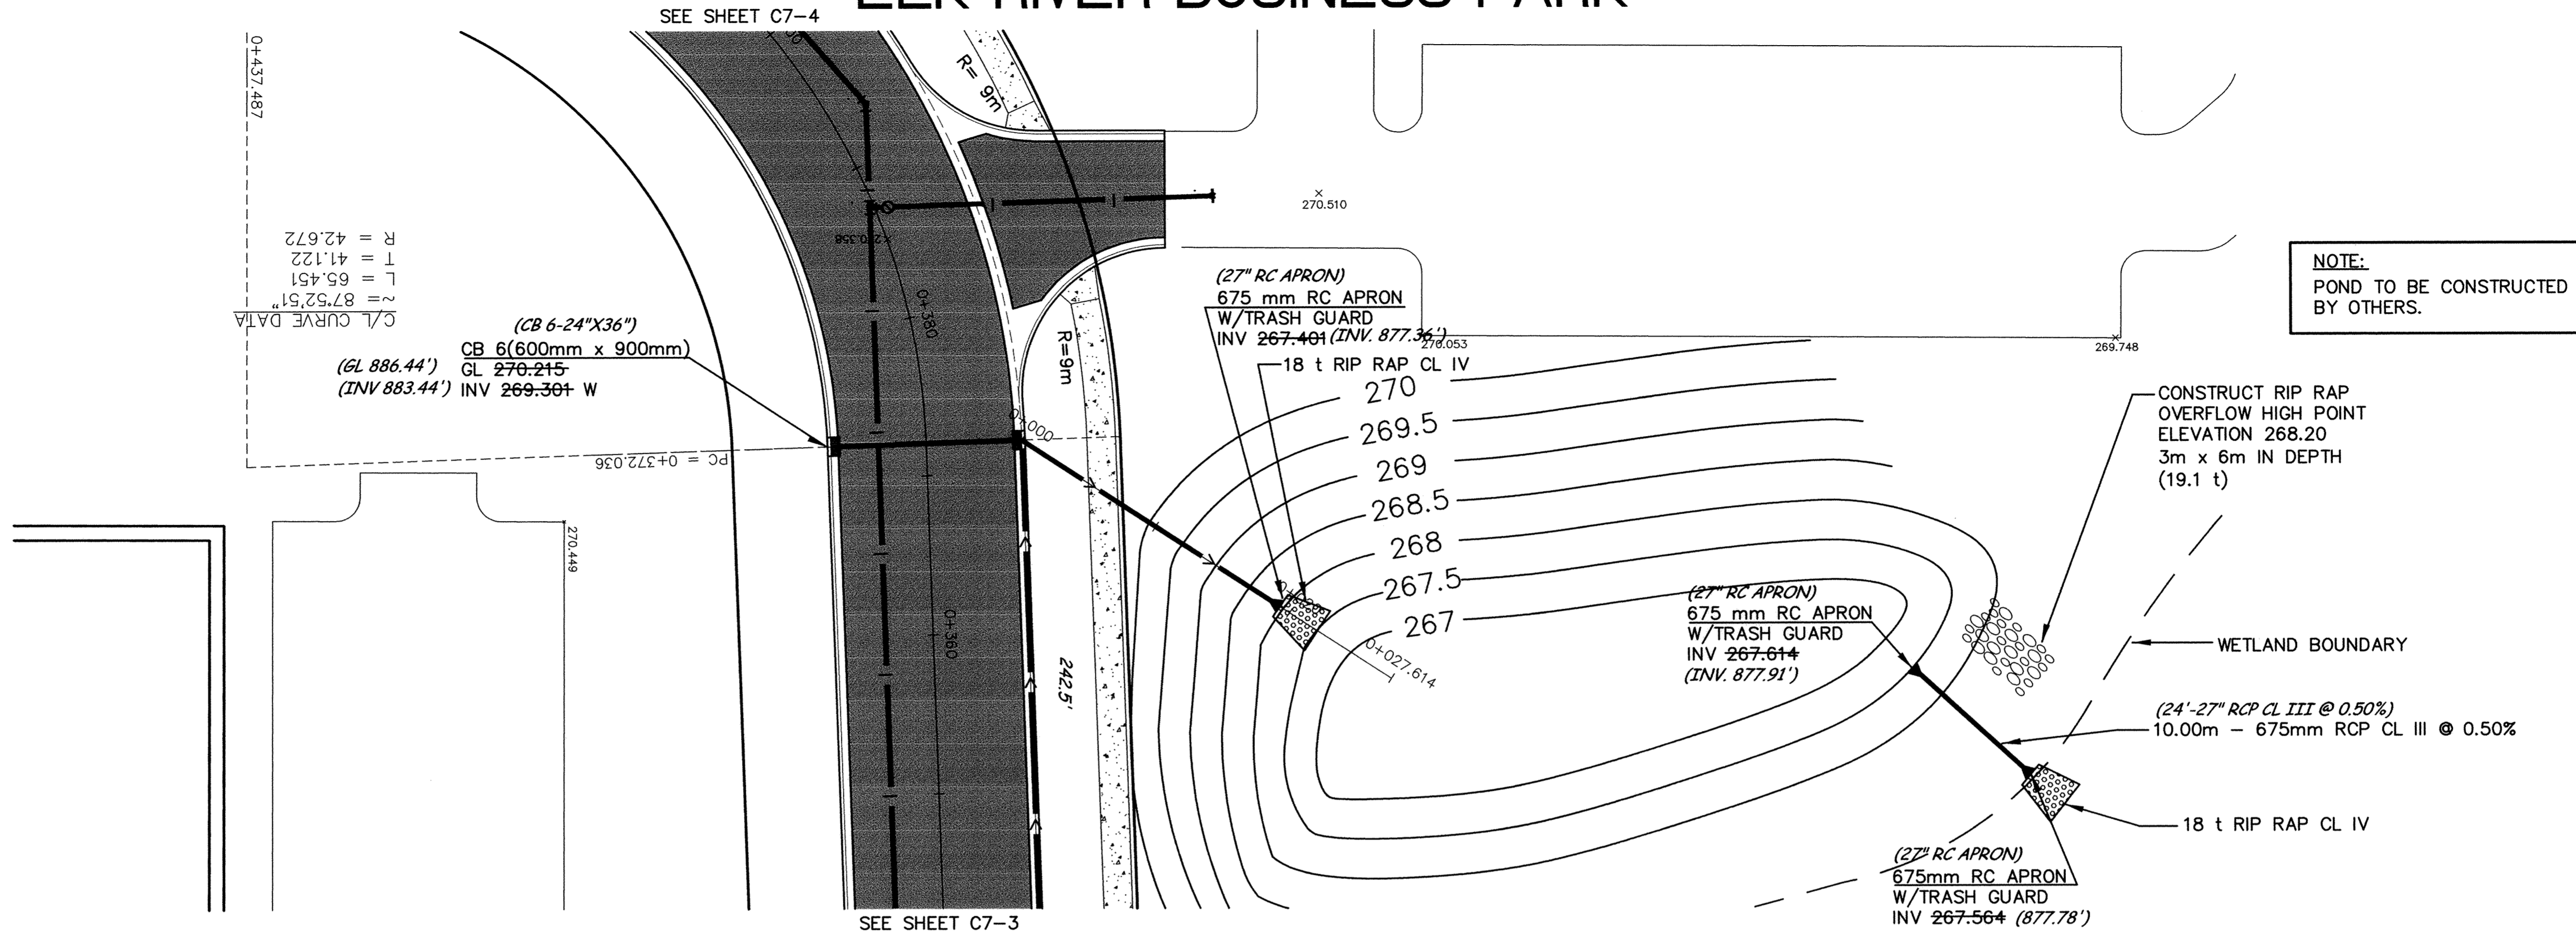

DESIGNED BY: JA JOB DATE: FEB 1999
DRAWN BY: LK JOB NUMBER: 800114J
APPROVED: _____ CAD DATE: _____
CAD FILE: March 02, 1999 2:03:28 p.m.
800114j_800114_P9.DWG

I HEREBY CERTIFY THAT THIS PLAN, SPECIFICATION, OR REPORT WAS PREPARED BY ME OR UNDER MY DIRECT SUPERVISION AND THAT I AM A DULY REGISTERED PROFESSIONAL ENGINEER UNDER THE LAWS OF THE STATE OF MINNESOTA.

DATE: _____ REG. NO. _____

NO.	DATE	BY	REVISION DESCRIPTION
1	1/19/99	LK	CHANGE ORDER NO. 1

1326 ENERGY PARK DRIVE
ST. PAUL, MINNESOTA 55108
(612) 644-4389

Howard R. Green Company
CONSULTING ENGINEERS

CITY OF ELK RIVER
EASTERN AREA
PHASE I IMPROVEMENTS

STREET AND UTILITY IMPROVEMENTS
ELK RIVER BUSINESS PARK
0+000 TO 0+019.272

SHEET NO.
C7-6