
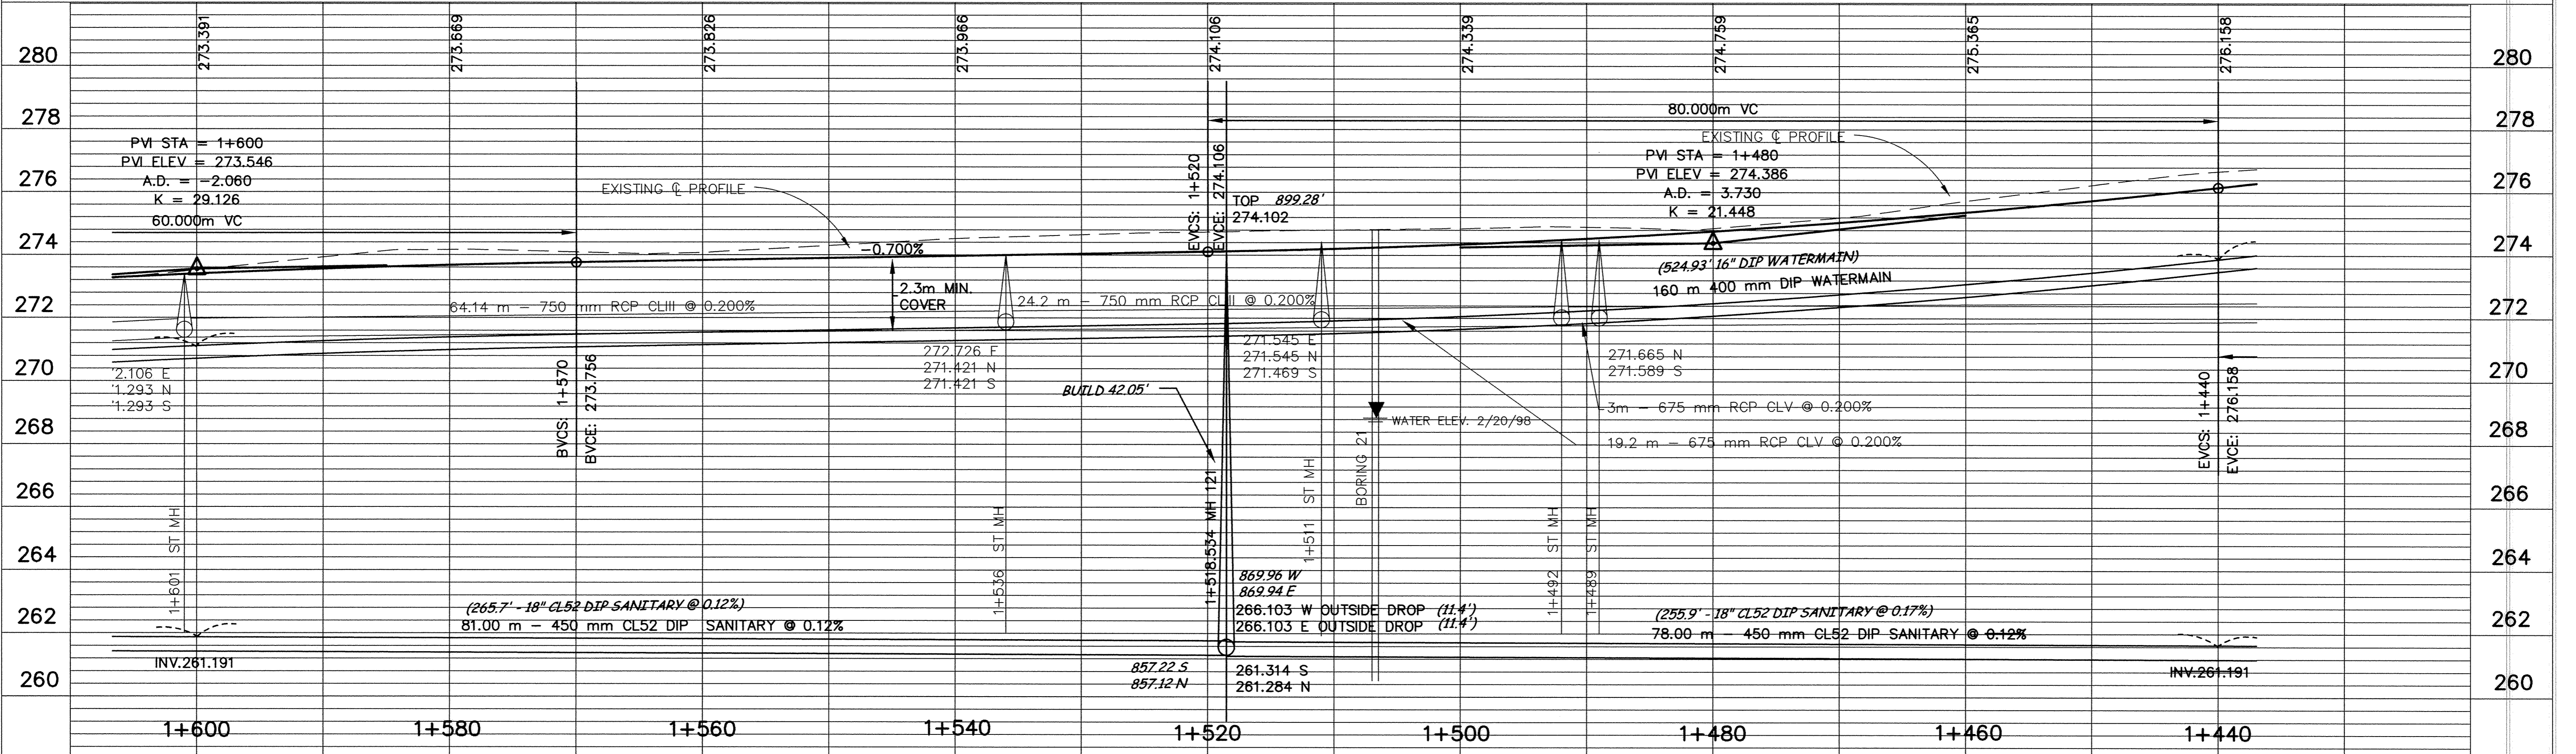


TYLER STREET

NOTE:
CONTRACTOR SHALL REMOVE AND
REPLACE EXISTING BITUMINOUS
AS DIRECTED BY ENGINEER

STREET CONSTRUCTION
LIMITS (TYP.)

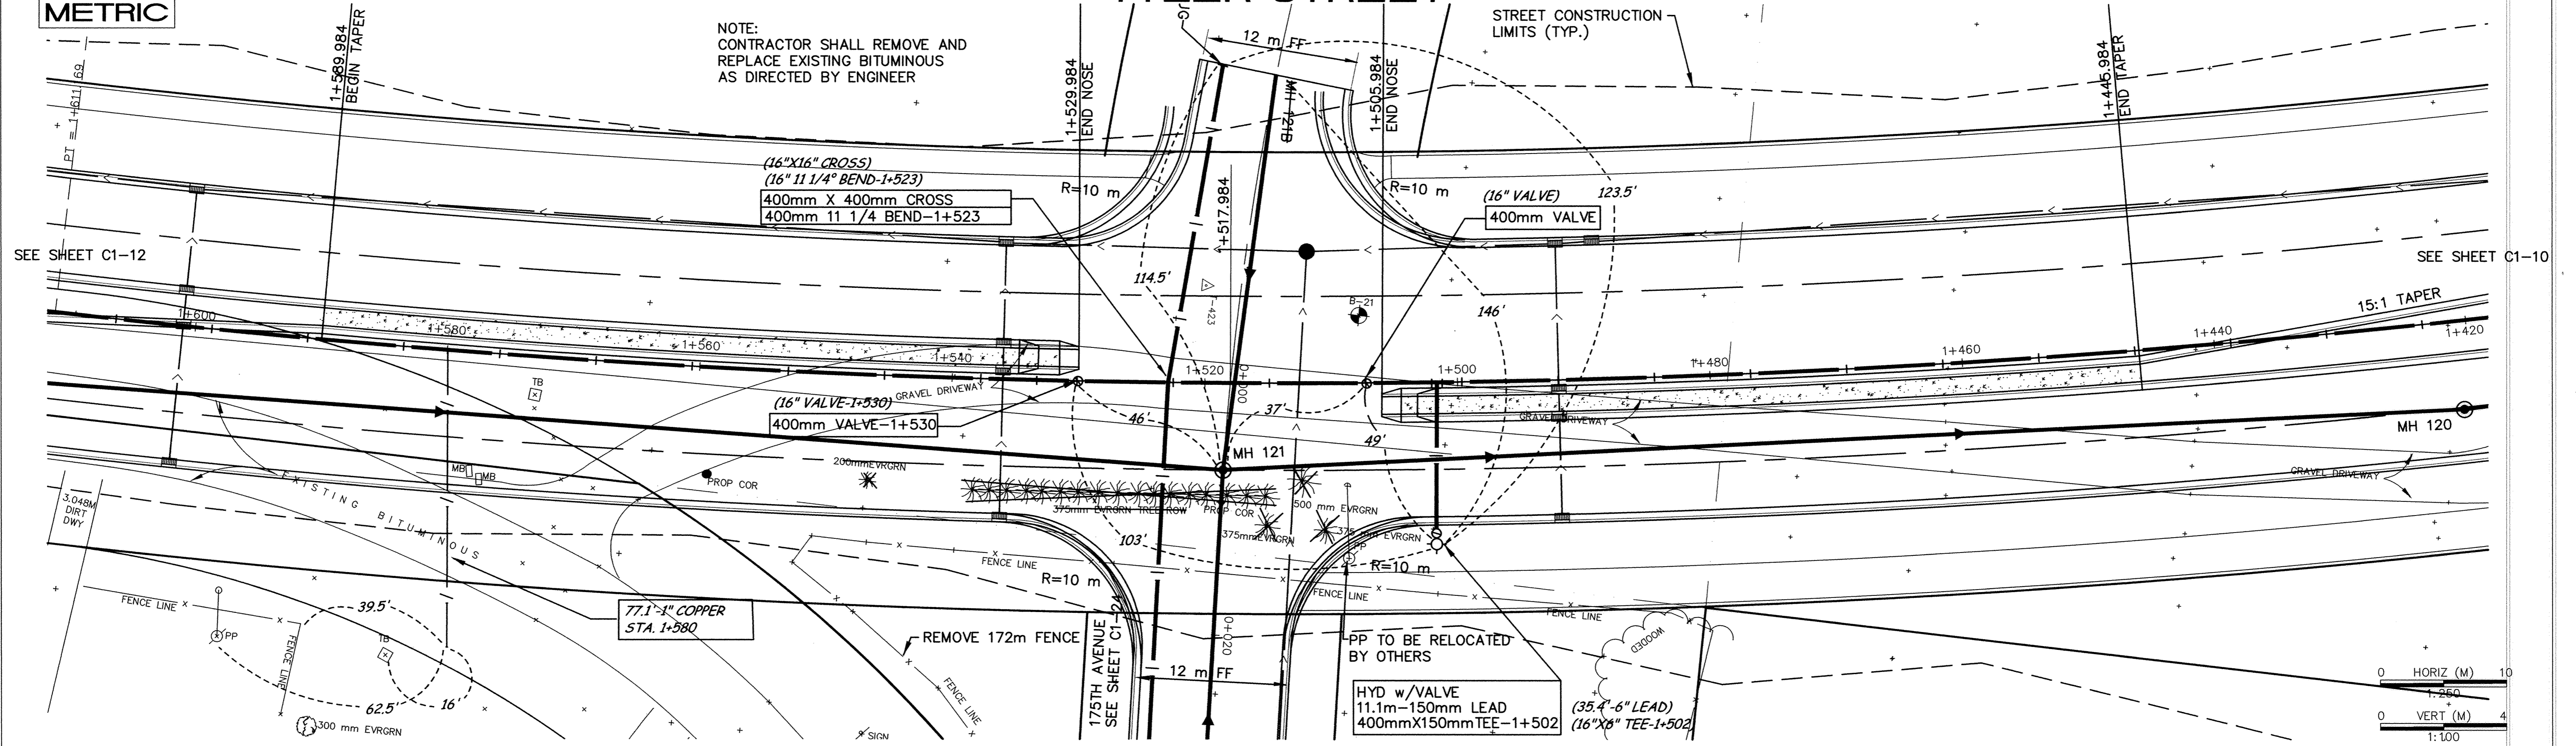

DESIGNED BY: AB JOB DATE: MARCH 1998
 DRAWN BY: ajg JOB NUMBER: 800110J
 APPROVED: _____ CAD DATE: _____
 CAD FILE: October 09, 1998 7:38:29 a.m.
800110J\Draws\Tyler_BASE\10.DWG

I HEREBY CERTIFY THAT THIS PLAN, SPECIFICATION,
OR REPORT WAS PREPARED BY ME OR UNDER MY DIRECT
SUPERVISION AND THAT I AM A DULY REGISTERED
PROFESSIONAL ENGINEER UNDER THE LAWS OF THE
STATE OF MINNESOTA.
DATE: 10/15/98 REG. NO. 15316

NO.	DATE	BY	REVISION DESCRIPTION

Howard R. Green Company
CONSULTING ENGINEERS
1326 ENERGY PARK DRIVE
ST. PAUL, MINNESOTA 55108
(612) 644-4389

CITY OF ELK RIVER
EASTERN AREA
PHASE I IMPROVEMENTS

STREET AND UTILITY IMPROVEMENTS
TYLER STREET
1+440 TO 1+600

SHEET NO.
C1-11