
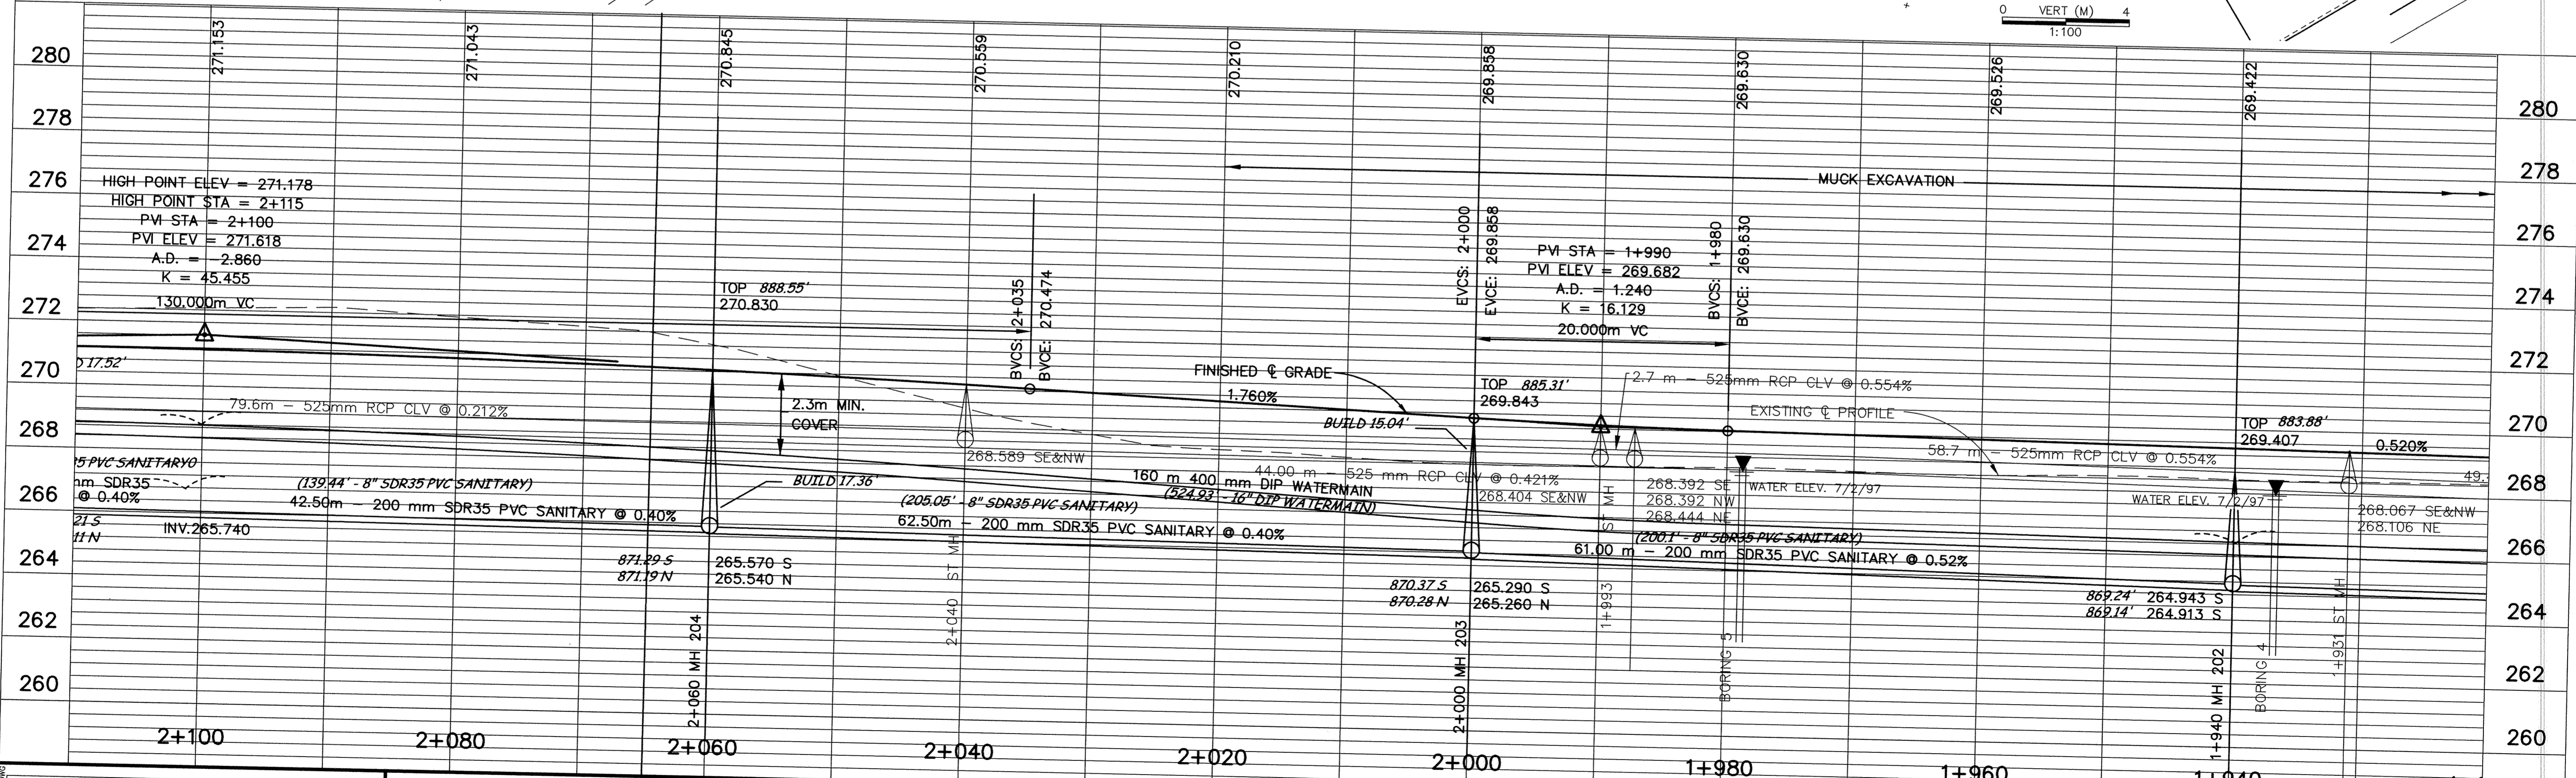
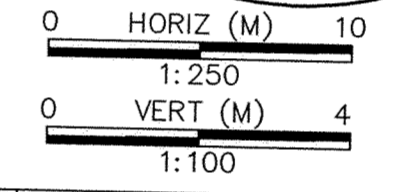


# TYLER STREET

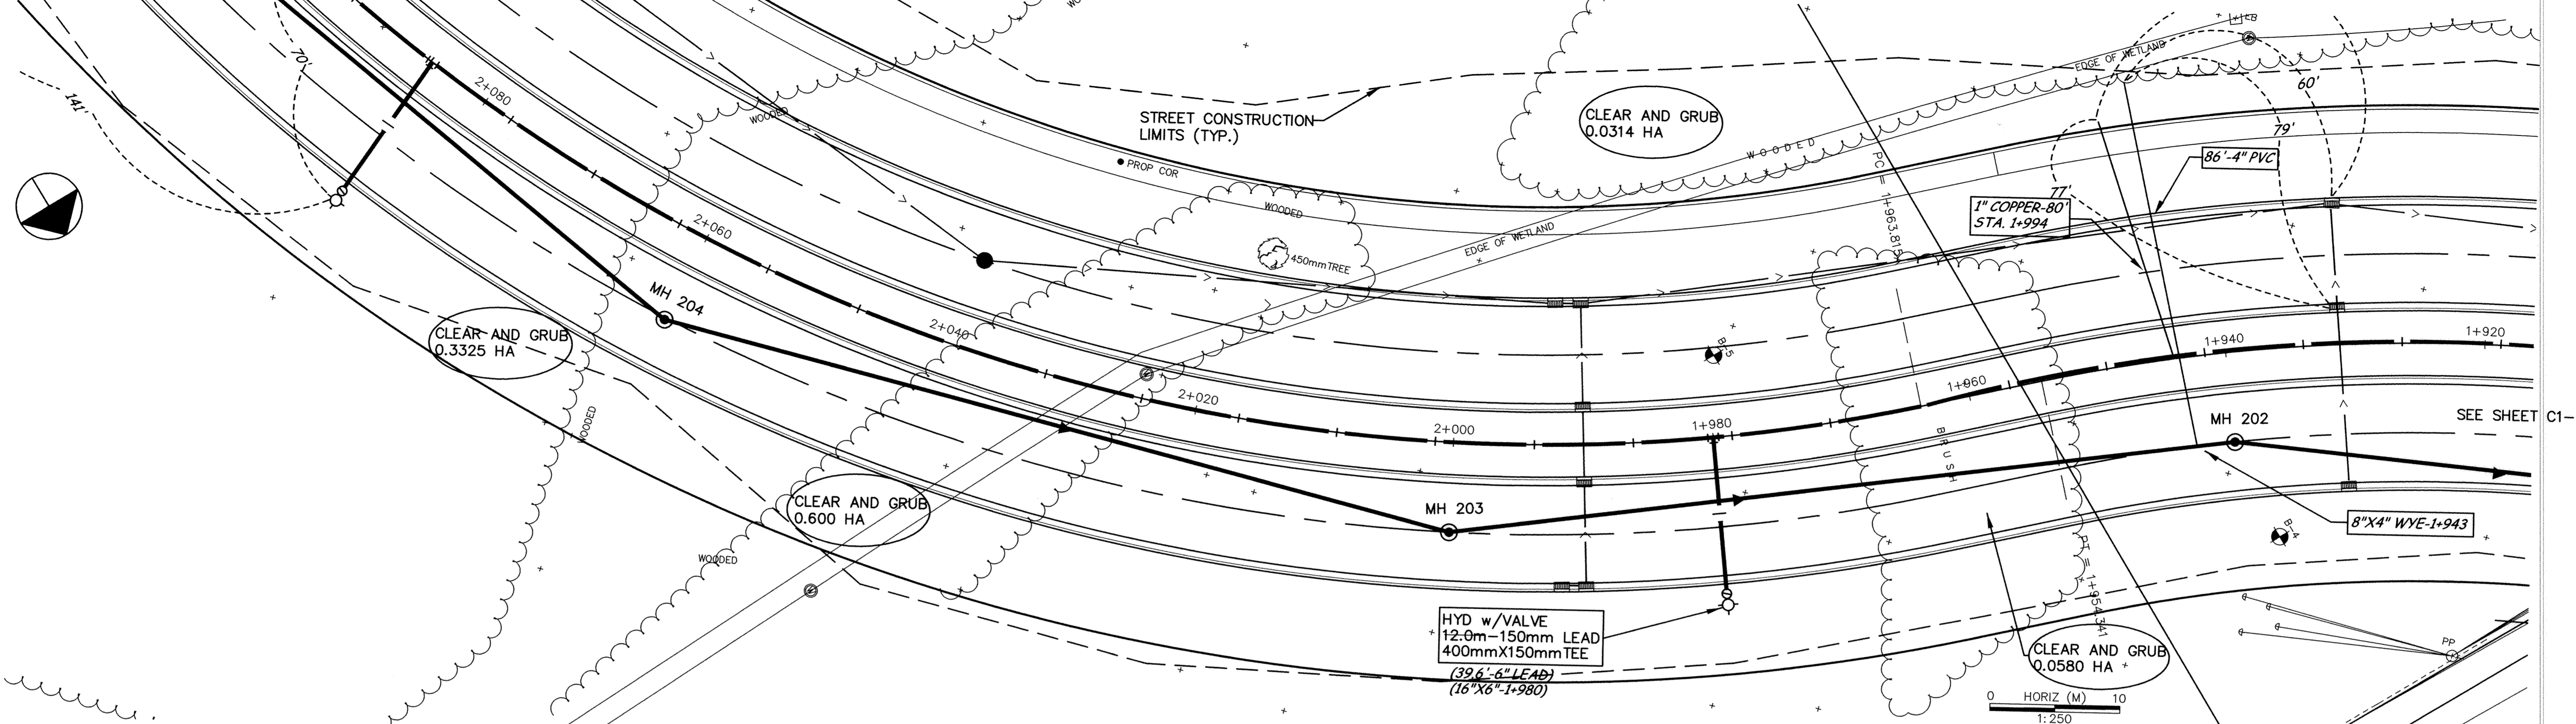

DESIGNED BY: AB JOB DATE: MARCH 1998  
 DRAWN BY: [Signature] JOB NUMBER: 800110J  
 APPROVED: [Signature] CAD DATE:  
 CAD FILE: October 08, 1998 2:21:44 p.m.  
 800110\Drawgs\Tyler\_BASE\13.DWG

I HEREBY CERTIFY THAT THIS PLAN, SPECIFICATION, OR REPORT WAS PREPARED BY ME OR UNDER MY DIRECT SUPERVISION AND THAT I AM A DULY REGISTERED PROFESSIONAL ENGINEER UNDER THE LAWS OF THE STATE OF MINNESOTA.  
 DATE 10/15/98 REG. NO. 15316

NO.	DATE	BY	REVISION DESCRIPTION



Howard R. Green Company  
CONSULTING ENGINEERS

1326 ENERGY PARK DRIVE  
ST. PAUL, MINNESOTA 55108  
(612) 644-4389

CITY OF ELK RIVER  
EASTERN AREA  
PHASE I IMPROVEMENTS

STREET AND UTILITY IMPROVEMENTS  
TYLER STREET  
1+940 TO 2+080

SHEET NO.  
**C1-14**

SAFICO PRODUCTS • NEW HOPE, MINNESOTA  
 REFORMER BY PART NUMBER 8552  
 DRAWING NUMBER  
 EAST 1 98  
 20  
 DRAWING NUMBER