


TYLER STREET

minnesota
METRIC


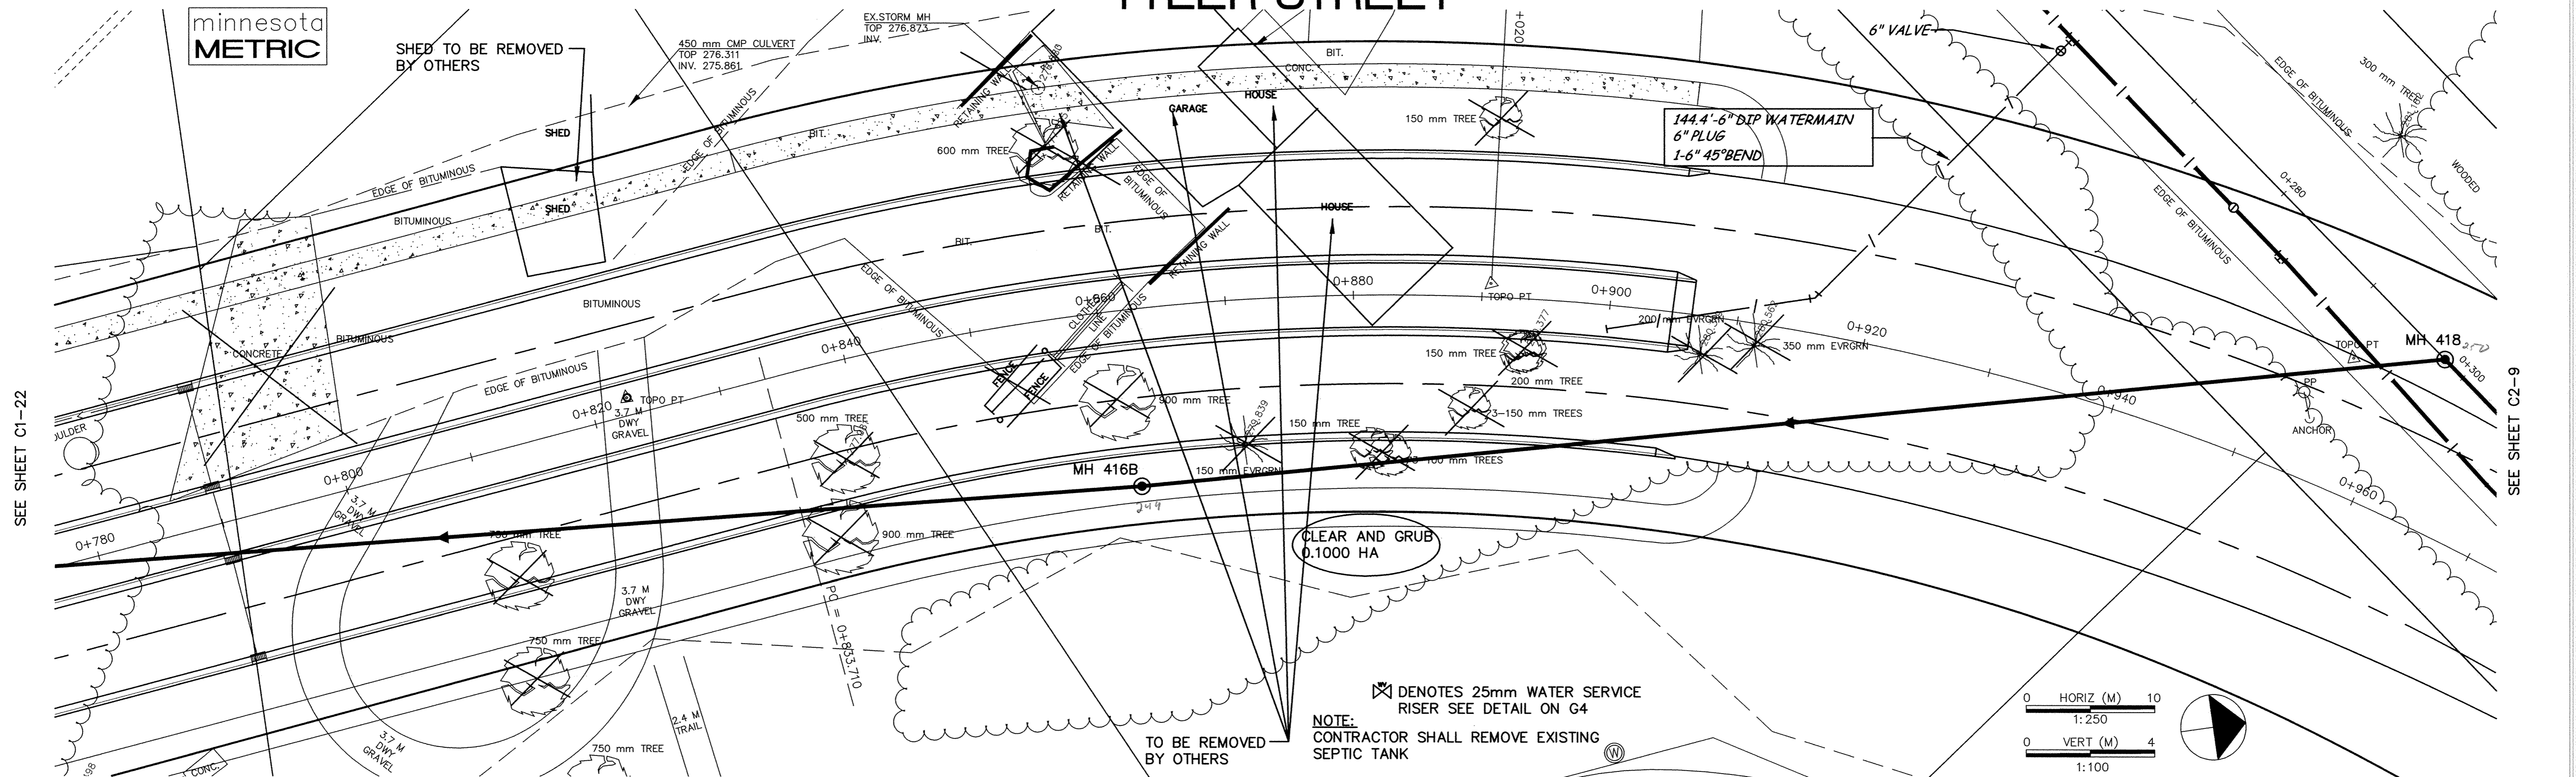


SEE SHEET C1-22

SEE SHEET C2-9

CLEAR AND GRUB
0.1000 HA

NOTE:
CONTRACTOR SHALL REMOVE EXISTING
SEPTIC TANK

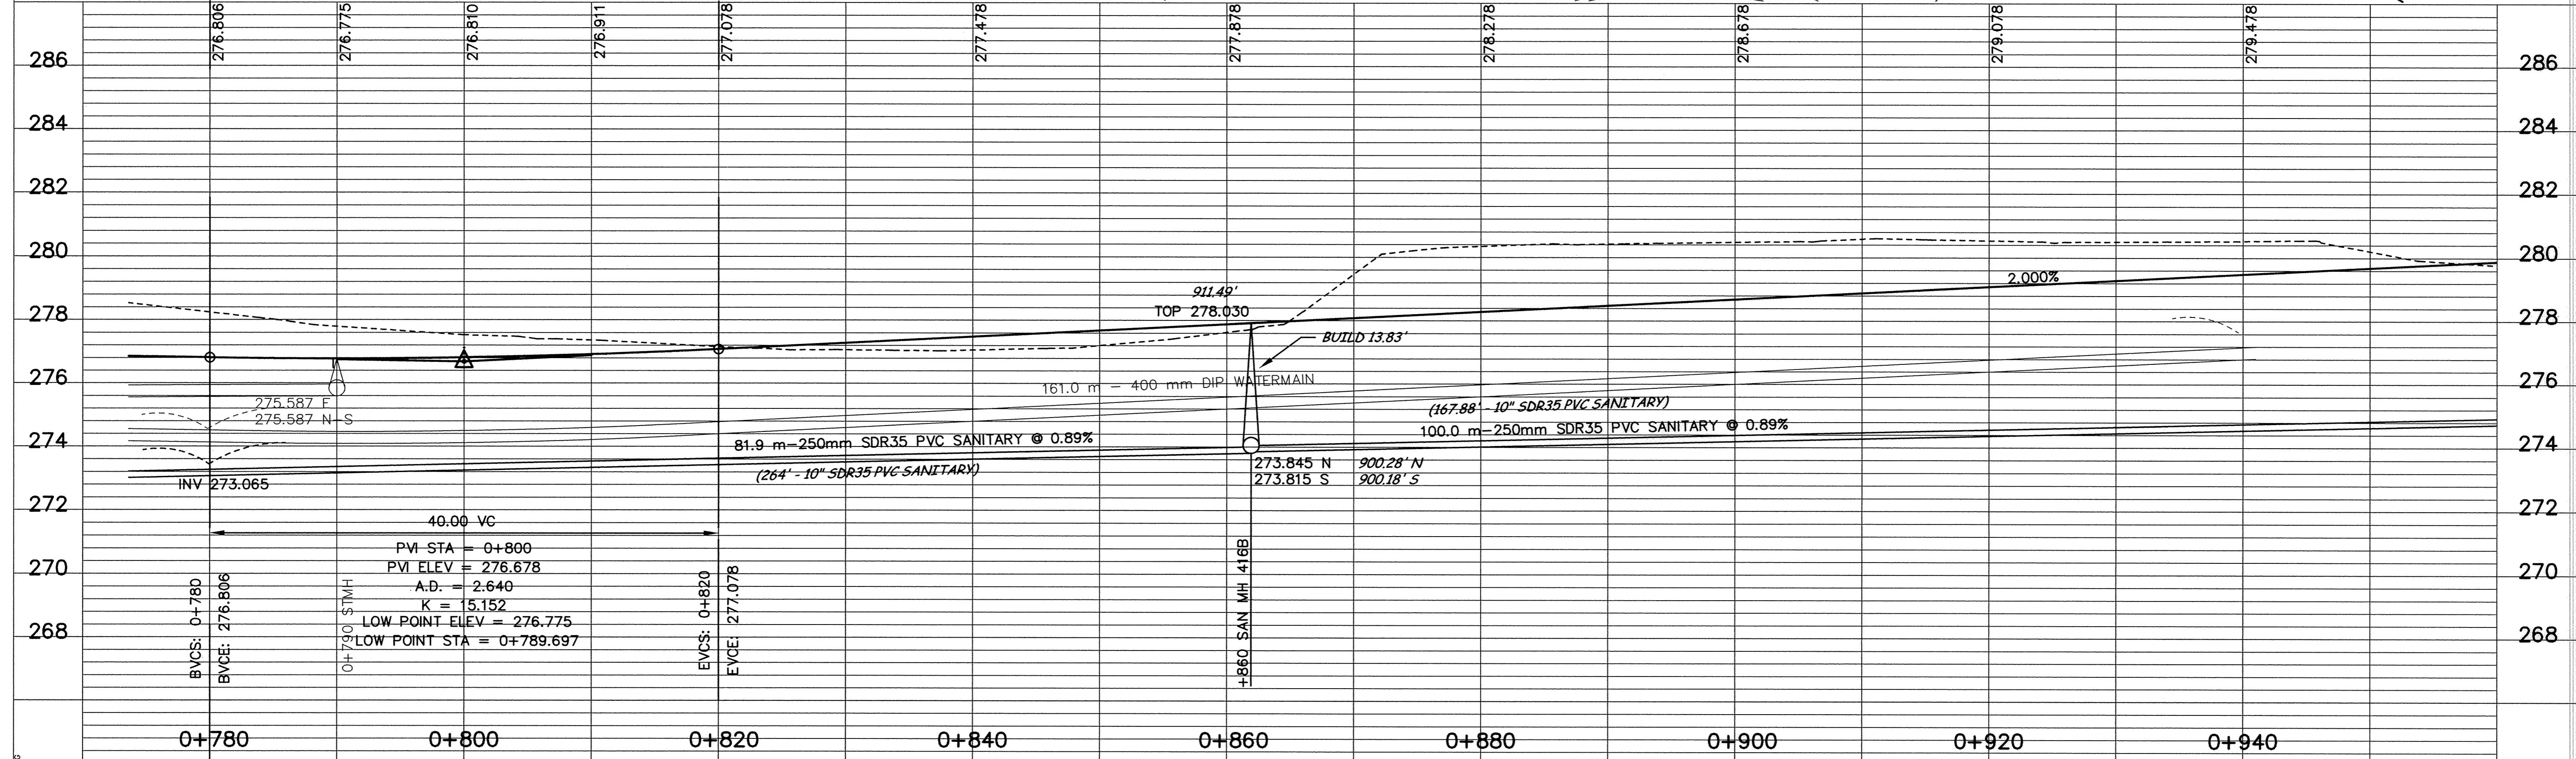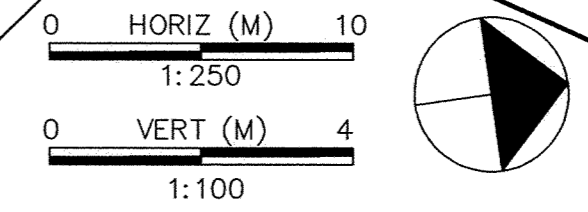

DESIGNED BY: AB JOB DATE: MARCH 1998
 DRAWN BY: [Signature] JOB NUMBER: 800110J
 APPROVED: [Signature] CAD DATE:
 CAD FILE: September 16, 1999 11:35:42 a.m.
 800110J\Drawgs\NORTH_TYLER\06.DWG

I HEREBY CERTIFY THAT THIS PLAN, SPECIFICATION,
 OR REPORT WAS PREPARED BY ME OR UNDER MY DIRECT
 SUPERVISION AND THAT I AM A DULY REGISTERED
 PROFESSIONAL ENGINEER UNDER THE LAWS OF THE
 STATE OF MINNESOTA.
 DATE: _____ REG. NO.: 15316

NO.	DATE	BY	REVISION DESCRIPTION
1	1-22-99	PH	DELETED WM C.O. NO.1
2	9-16-99	RM	REVISE SANITARY SEWER REVISE SANITARY ALIGNMENT

Howard R. Green Company
 CONSULTING ENGINEERS
 1326 ENERGY PARK DRIVE
 ST. PAUL, MINNESOTA 55108
 (612) 644-4389

CITY OF ELK RIVER
EASTERN AREA
PHASE I IMPROVEMENTS

STREET AND UTILITY IMPROVEMENTS
TYLER STREET
0+780 TO 0+940

SHEET NO.
C1-23

DRAWING NUMBER: EASTERN 98
 29
 SAFCO PRODUCTS • NEW AUSTIN, MINNESOTA
 PRODUCED BY PART NUMBER 8832
 PREPARED BY PART NUMBER 8832
 SAFCO PRODUCTS • NEW AUSTIN, MINNESOTA
 PRODUCED BY PART NUMBER 8832
 PREPARED BY PART NUMBER 8832
 SAFCO PRODUCTS • NEW AUSTIN, MINNESOTA
 PRODUCED BY PART NUMBER 8832
 PREPARED BY PART NUMBER 8832