
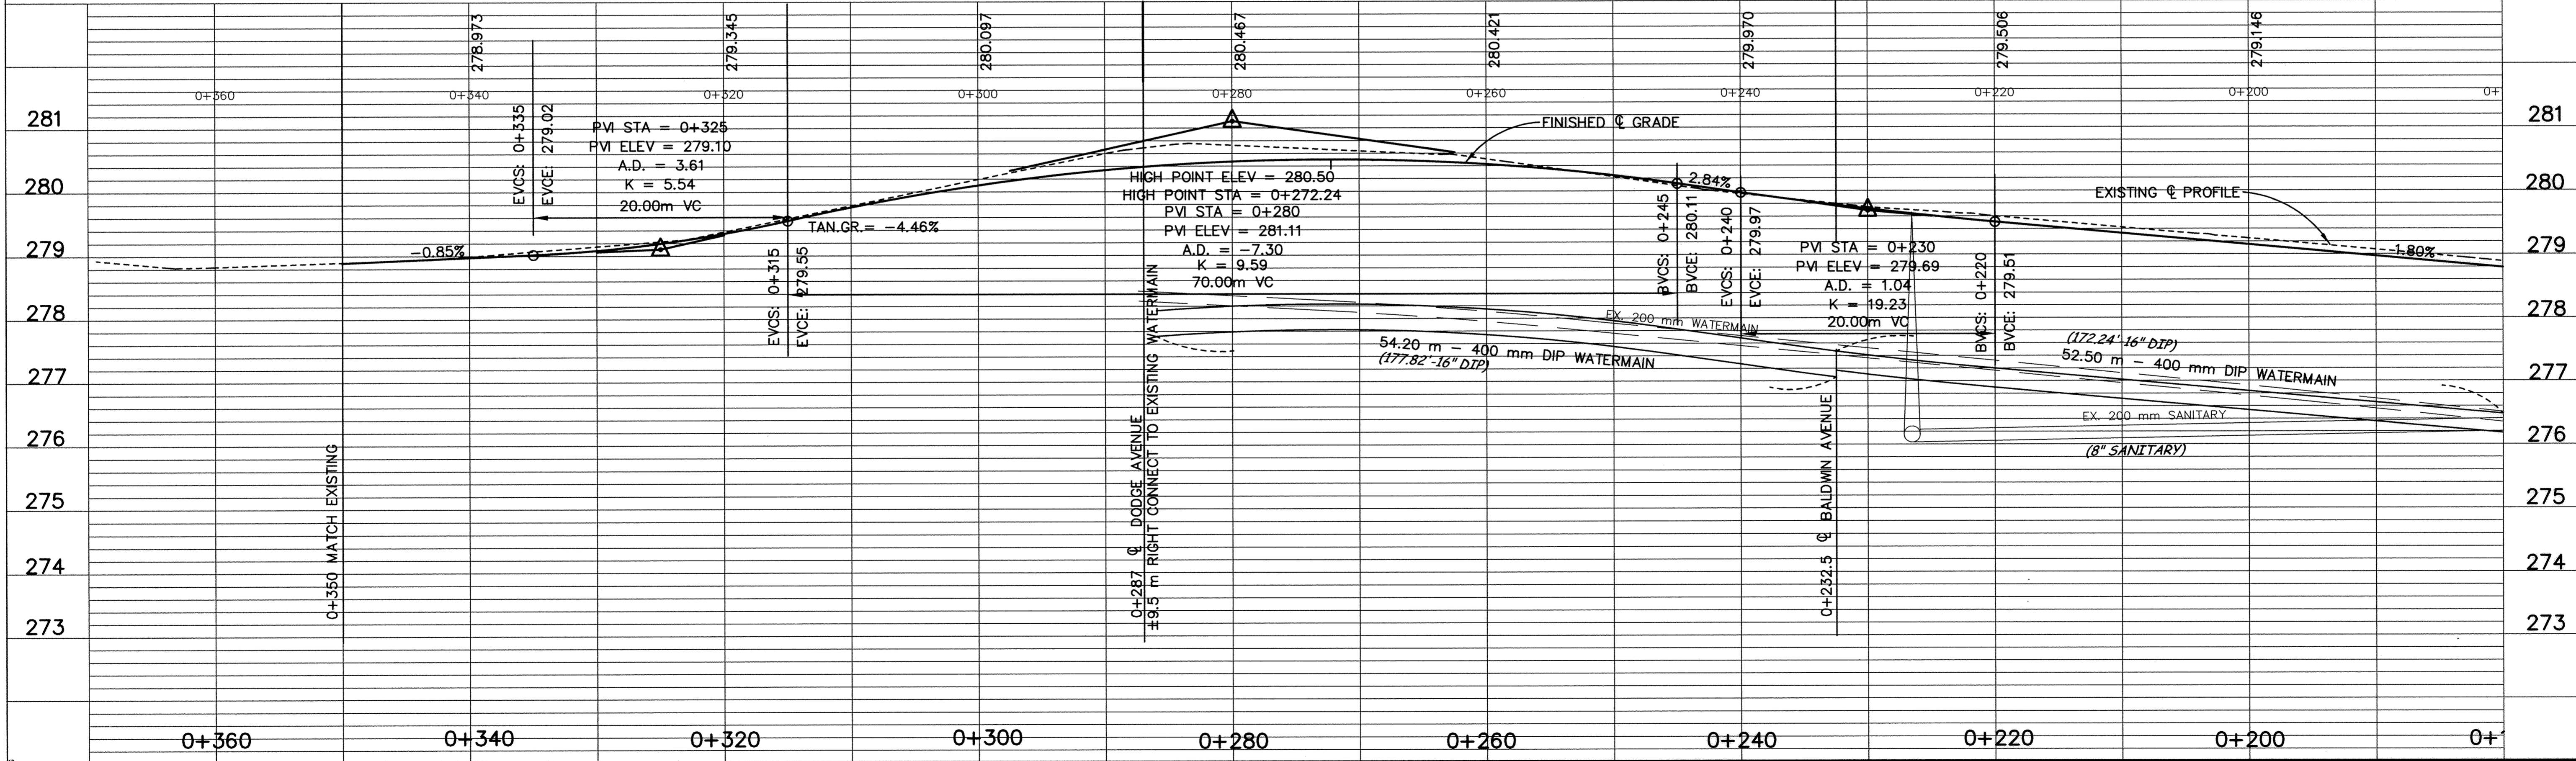
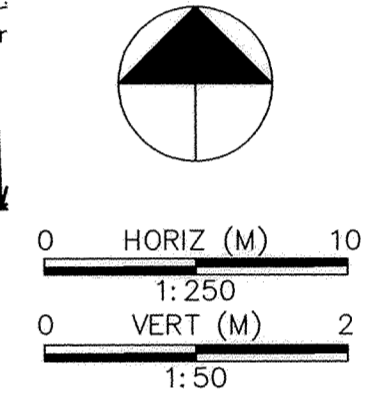


FIFTH STREET

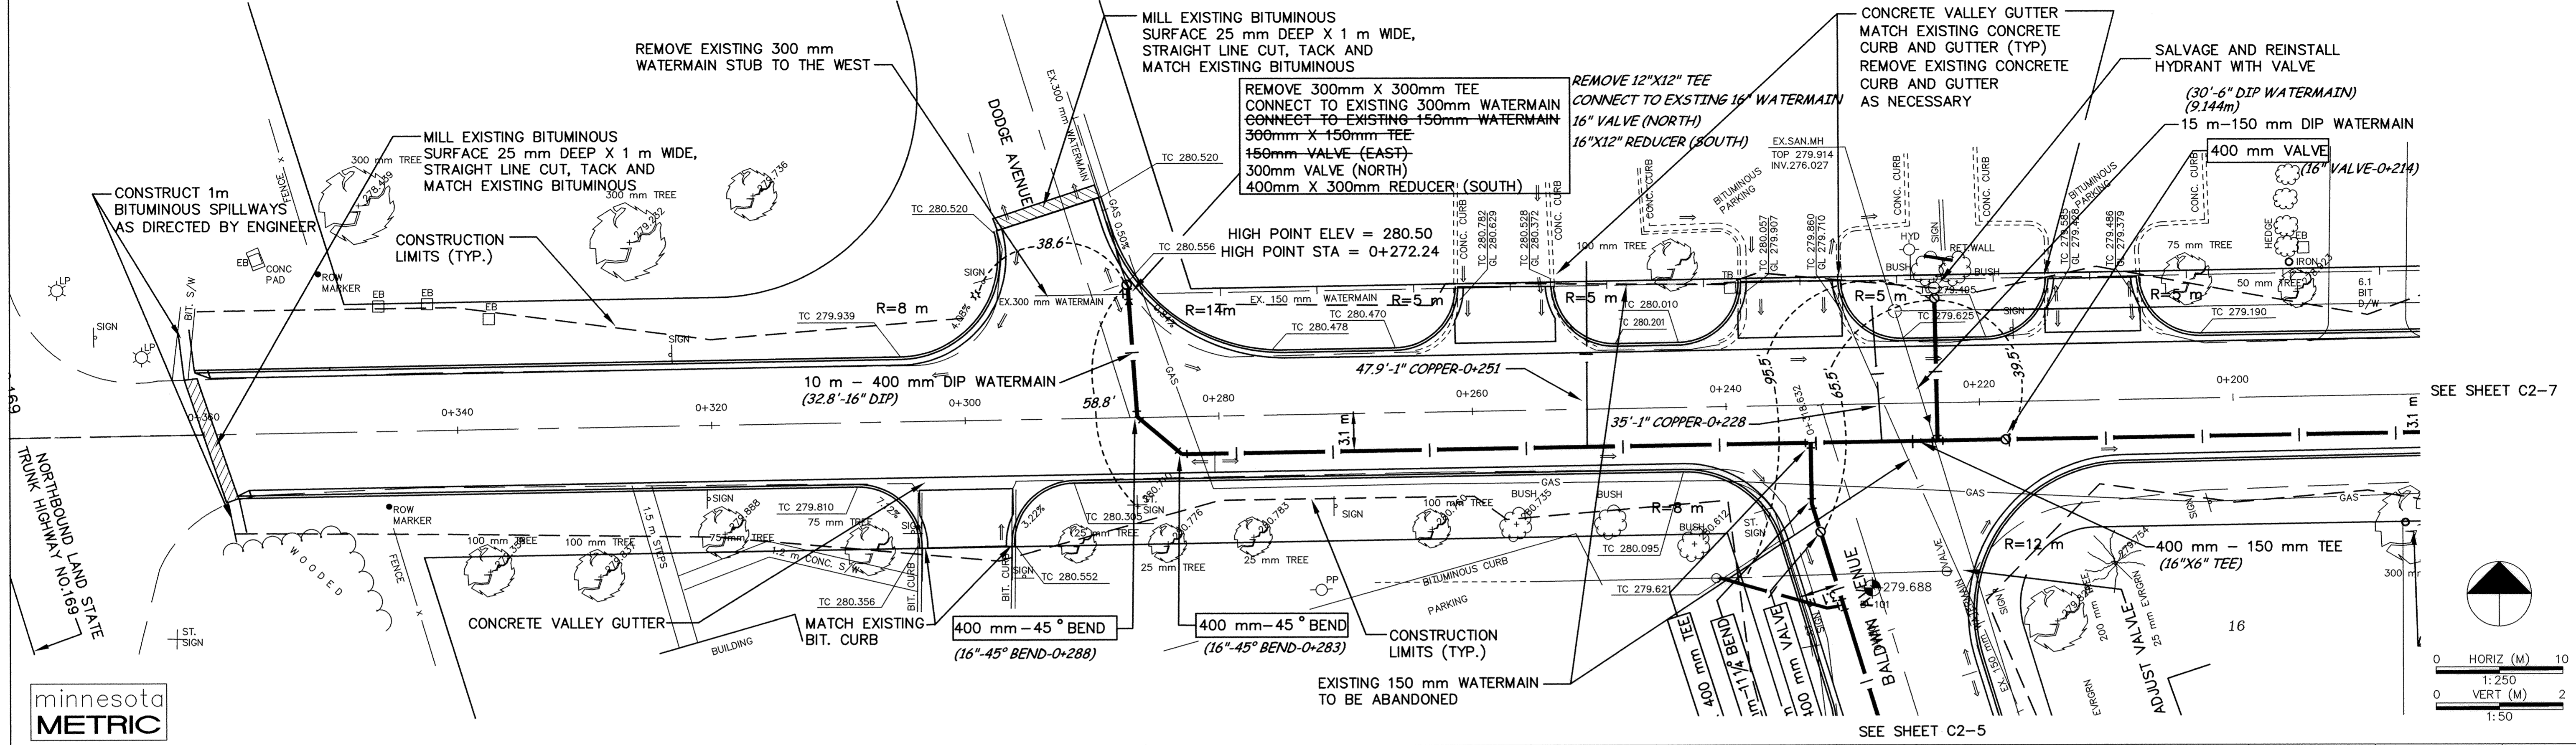

DESIGNED BY: _____ JOB DATE: MARCH 1998
 DRAWN BY: _____ JOB NUMBER 800110J
 APPROVED: _____ CAD DATE: MARCH 1998
 CAD FILE: February 08, 1999 1:09:27 p.m. 800110J\Draws\BALDWIN\04.DWG

I HEREBY CERTIFY THAT THIS PLAN, SPECIFICATION, OR REPORT WAS PREPARED BY ME OR UNDER MY DIRECT SUPERVISION AND THAT I AM A DULY REGISTERED PROFESSIONAL ENGINEER UNDER THE LAWS OF THE STATE OF MINNESOTA.
 DATE _____ REG. NO. 15316

NO.	DATE	BY	REVISION DESCRIPTION
1	1-20-99	PH	REVISED WM SIZE C.O. NO. 1

1326 ENERGY PARK DRIVE
 ST. PAUL, MINNESOTA 55108
 (612) 644-4389
Howard R. Green Company
 CONSULTING ENGINEERS

CITY OF ELK RIVER
 EASTERN AREA
 PHASE I IMPROVEMENTS

STREET AND WATERMAIN IMPROVEMENTS
 FIFTH STREET
 0+180 TO 0+350

SHEET NO.
C2-6

DRAWING NUMBER EASTE1.98 89
 DRAWING NUMBER C2-6
 DRAWING NUMBER C2-7
 DRAWING NUMBER C2-5
 DRAWING NUMBER C2-6
 DRAWING NUMBER EASTE1.98 89
 S:\CADD\PRODUCTS - NEW HOPE, MINNESOTA
 REVISION BY PART NUMBER 5532
 PROJECT NUMBER 800110J
 SHEET NUMBER 04 OF 04