
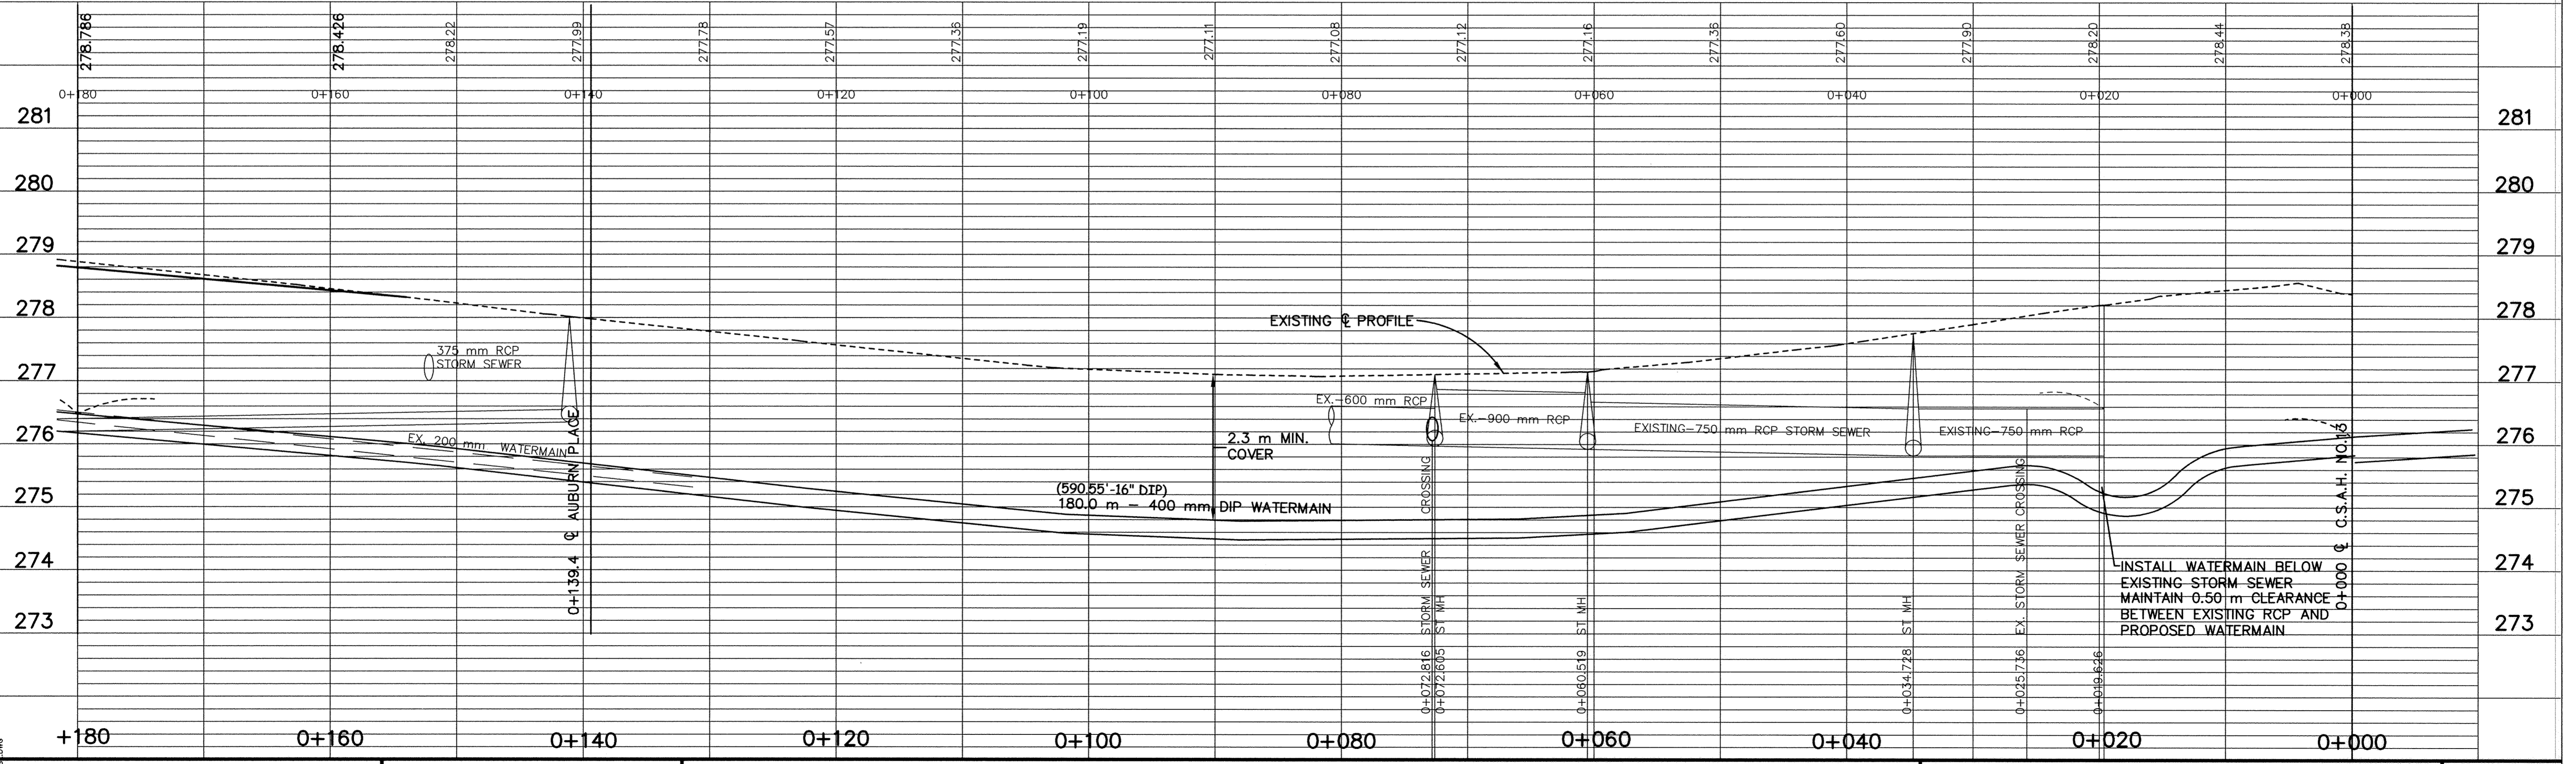


FIFTH STREET

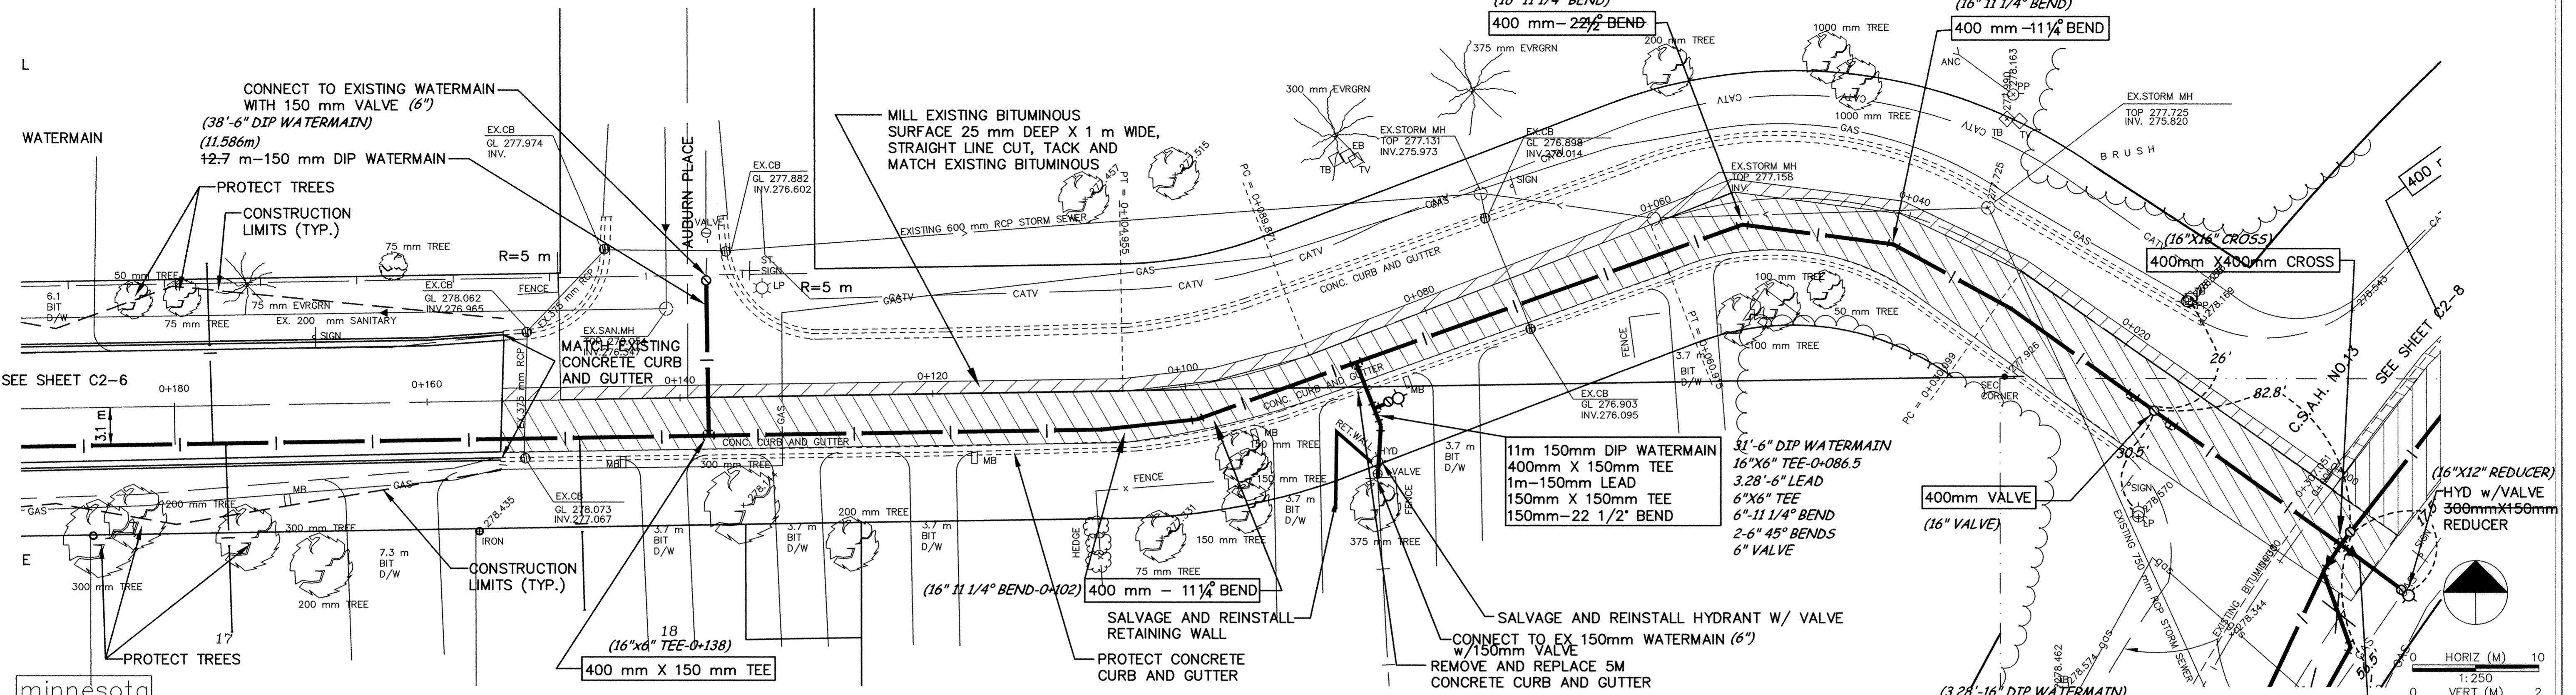

DESIGNED BY: _____ JOB DATE: MARCH 1998
 DRAWN BY: *mgj* JOB NUMBER: 800110J
 APPROVED: _____ CAD DATE: MARCH 1998
 CAD FILE: March 28, 2001 3:29:06 p.m.
 800110\AS-BUILTS\AS_BALDWIN-5TH\AS05.DWG

I HEREBY CERTIFY THAT THIS PLAN, SPECIFICATION, OR REPORT WAS PREPARED BY ME OR UNDER MY DIRECT SUPERVISION AND THAT I AM A DULY REGISTERED PROFESSIONAL ENGINEER UNDER THE LAWS OF THE STATE OF MINNESOTA.
 DATE: _____ REG. NO.: 15316

NO.	DATE	BY	REVISION DESCRIPTION
1	1-20-99	PH	REVISED WM SIZE C.O. NO. 1

1326 ENERGY PARK DRIVE
 ST. PAUL, MINNESOTA 55108
 (612) 644-4389


Howard R. Green Company
 CONSULTING ENGINEERS

CITY OF ELK RIVER
 EASTERN AREA
 PHASE I IMPROVEMENTS

STREET AND WATERMAIN IMPROVEMENTS
 FIFTH STREET
 0+000 TO 0+180

SHEET NO.
C2-7

MINNESOTA
METRIC

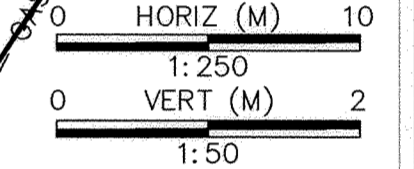

DRAWING NUMBER
 EAST E 198

DRAWING NUMBER
 EAST E 198

