
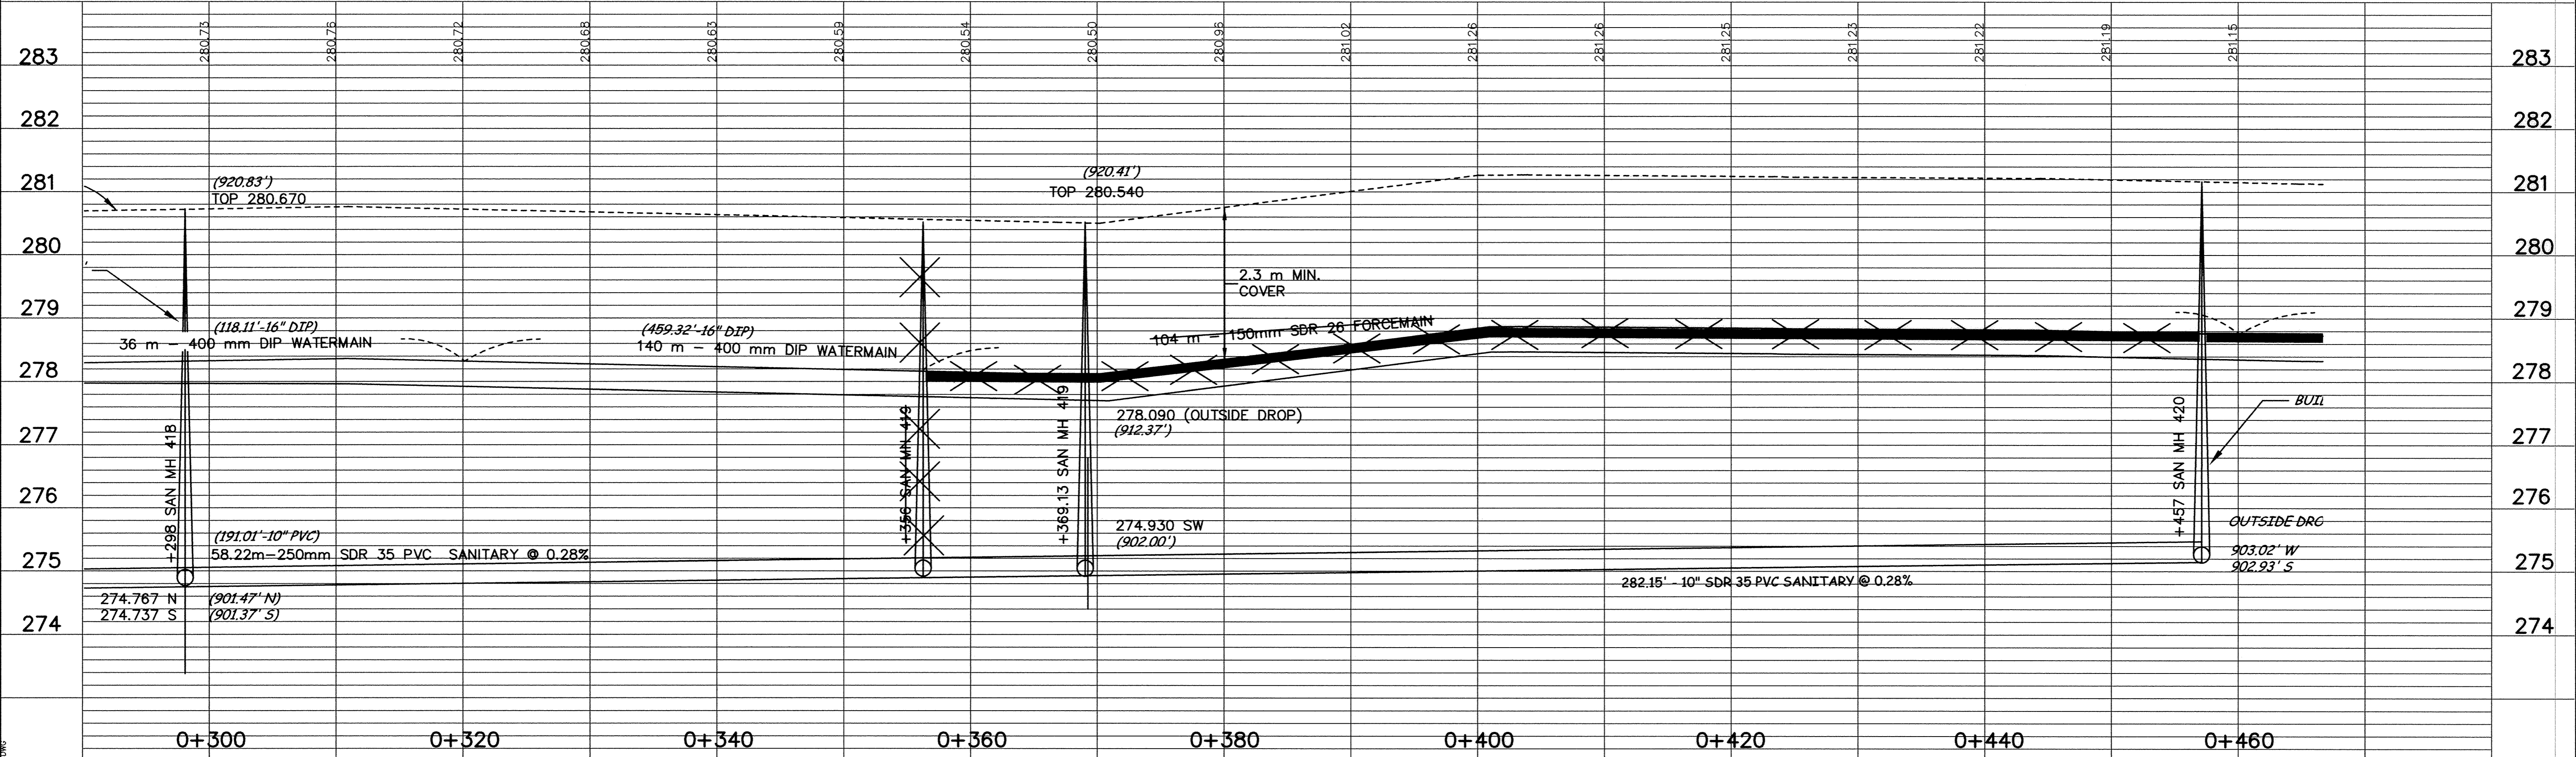


C.S.A.H. NO.13

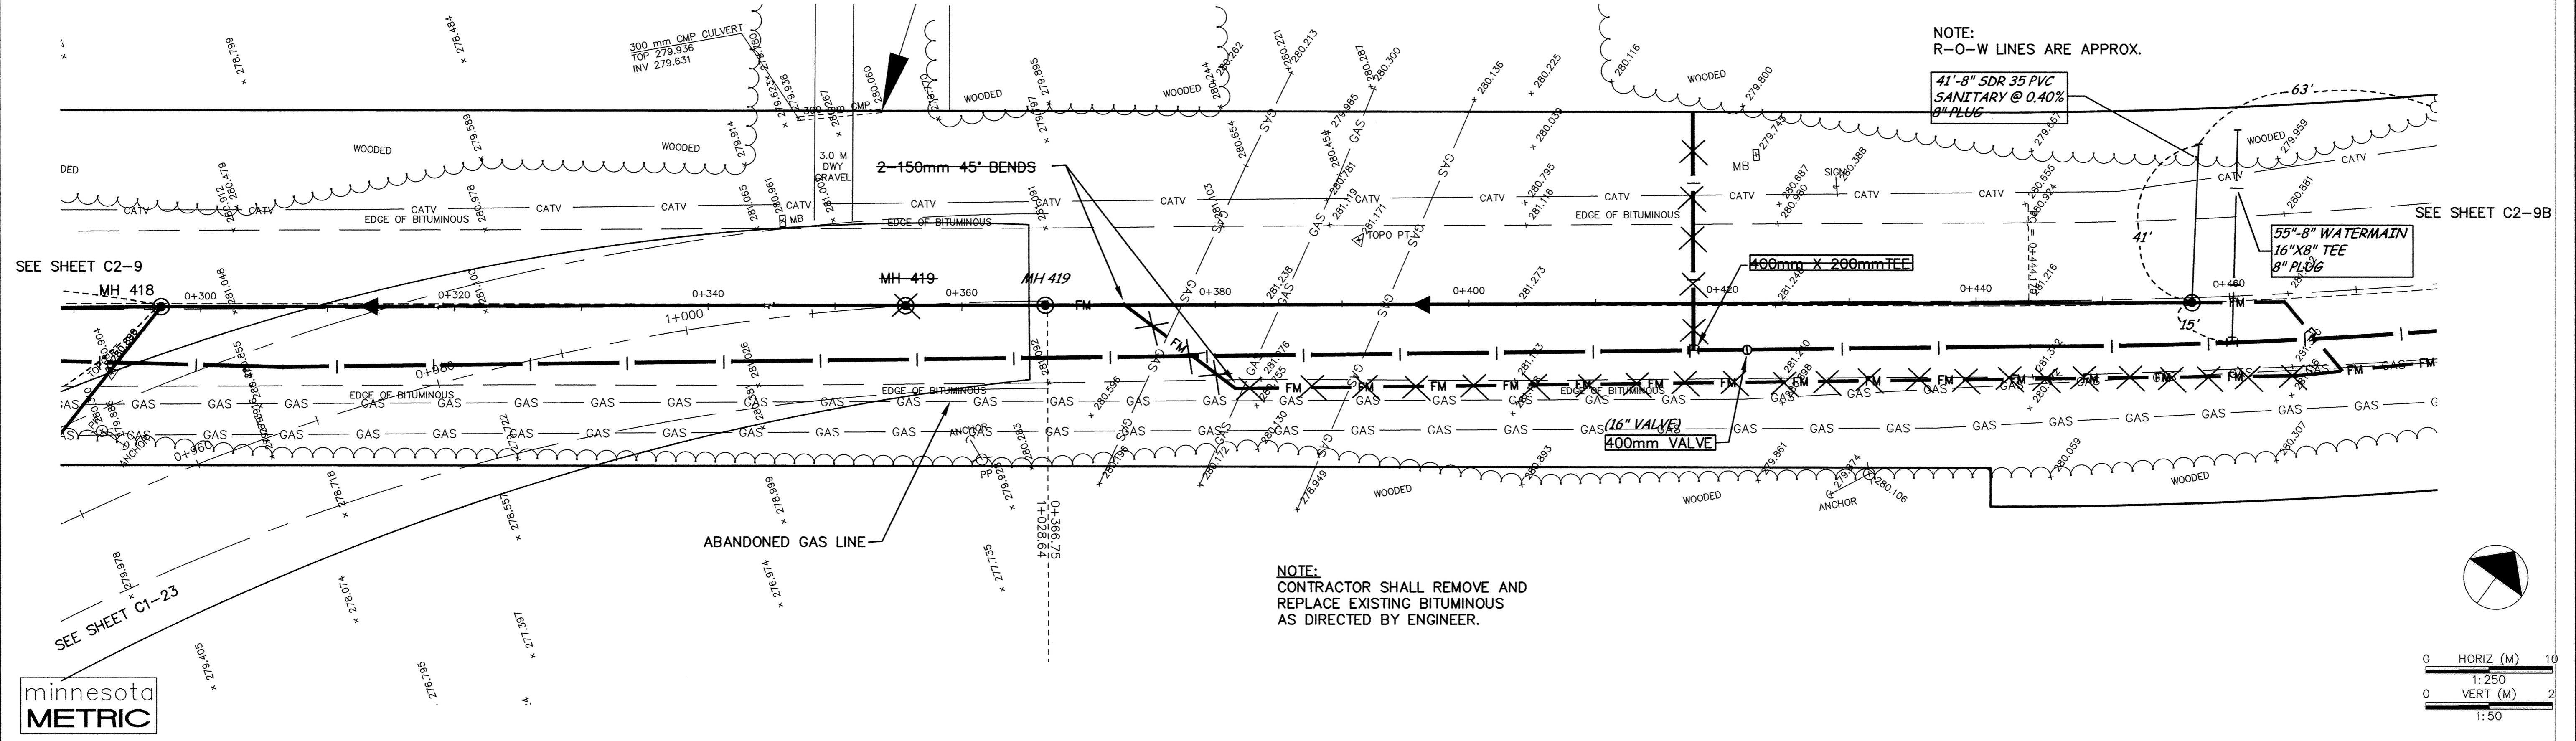

DESIGNED BY: _____ JOB DATE: MARCH 1998	I HEREBY CERTIFY THAT THIS PLAN, SPECIFICATION, OR REPORT WAS PREPARED BY ME OR UNDER MY DIRECT SUPERVISION AND THAT I AM A DULY REGISTERED PROFESSIONAL ENGINEER UNDER THE LAWS OF THE STATE OF MINNESOTA.	NO. DATE BY REVISION DESCRIPTION	1326 ENERGY PARK DRIVE ST. PAUL, MINNESOTA 55108 (612) 644-4389	CITY OF ELK RIVER EASTERN AREA PHASE I IMPROVEMENTS	WATERMAIN IMPROVEMENTS CSAH 13 BETWEEN 5TH AND TYLER	SHEET NO. C2-9A
DRAWN BY: _____ JOB NUMBER: 800110J		1 1-25-99 PH REVISED SANITARY SEWER C.O. NO.1				
APPROVED: _____ CAD DATE: AUGUST 1998						
CAD FILE: March 28, 2001 4:30:50 p.m. 800110J\AS-BUILTS\AS_BALDWIN-5TH\AS13A.DWG						

DATE: _____ REG. NO.: 15316

Howard R. Green Company
CONSULTING ENGINEERS

1326 ENERGY PARK DRIVE
ST. PAUL, MINNESOTA 55108
(612) 644-4389

CITY OF ELK RIVER
EASTERN AREA
PHASE I IMPROVEMENTS

WATERMAIN IMPROVEMENTS
CSAH 13 BETWEEN 5TH AND TYLER

SHEET NO.
C2-9A

0+300 TO 0+460

DRAWING NUMBER EAST E. 1.98

DRAWING NUMBER 93

DRAWING NUMBER 98

DRAWING NUMBER EAST E. 1.98

DRAWING NUMBER 93

DRAWING NUMBER 98

