
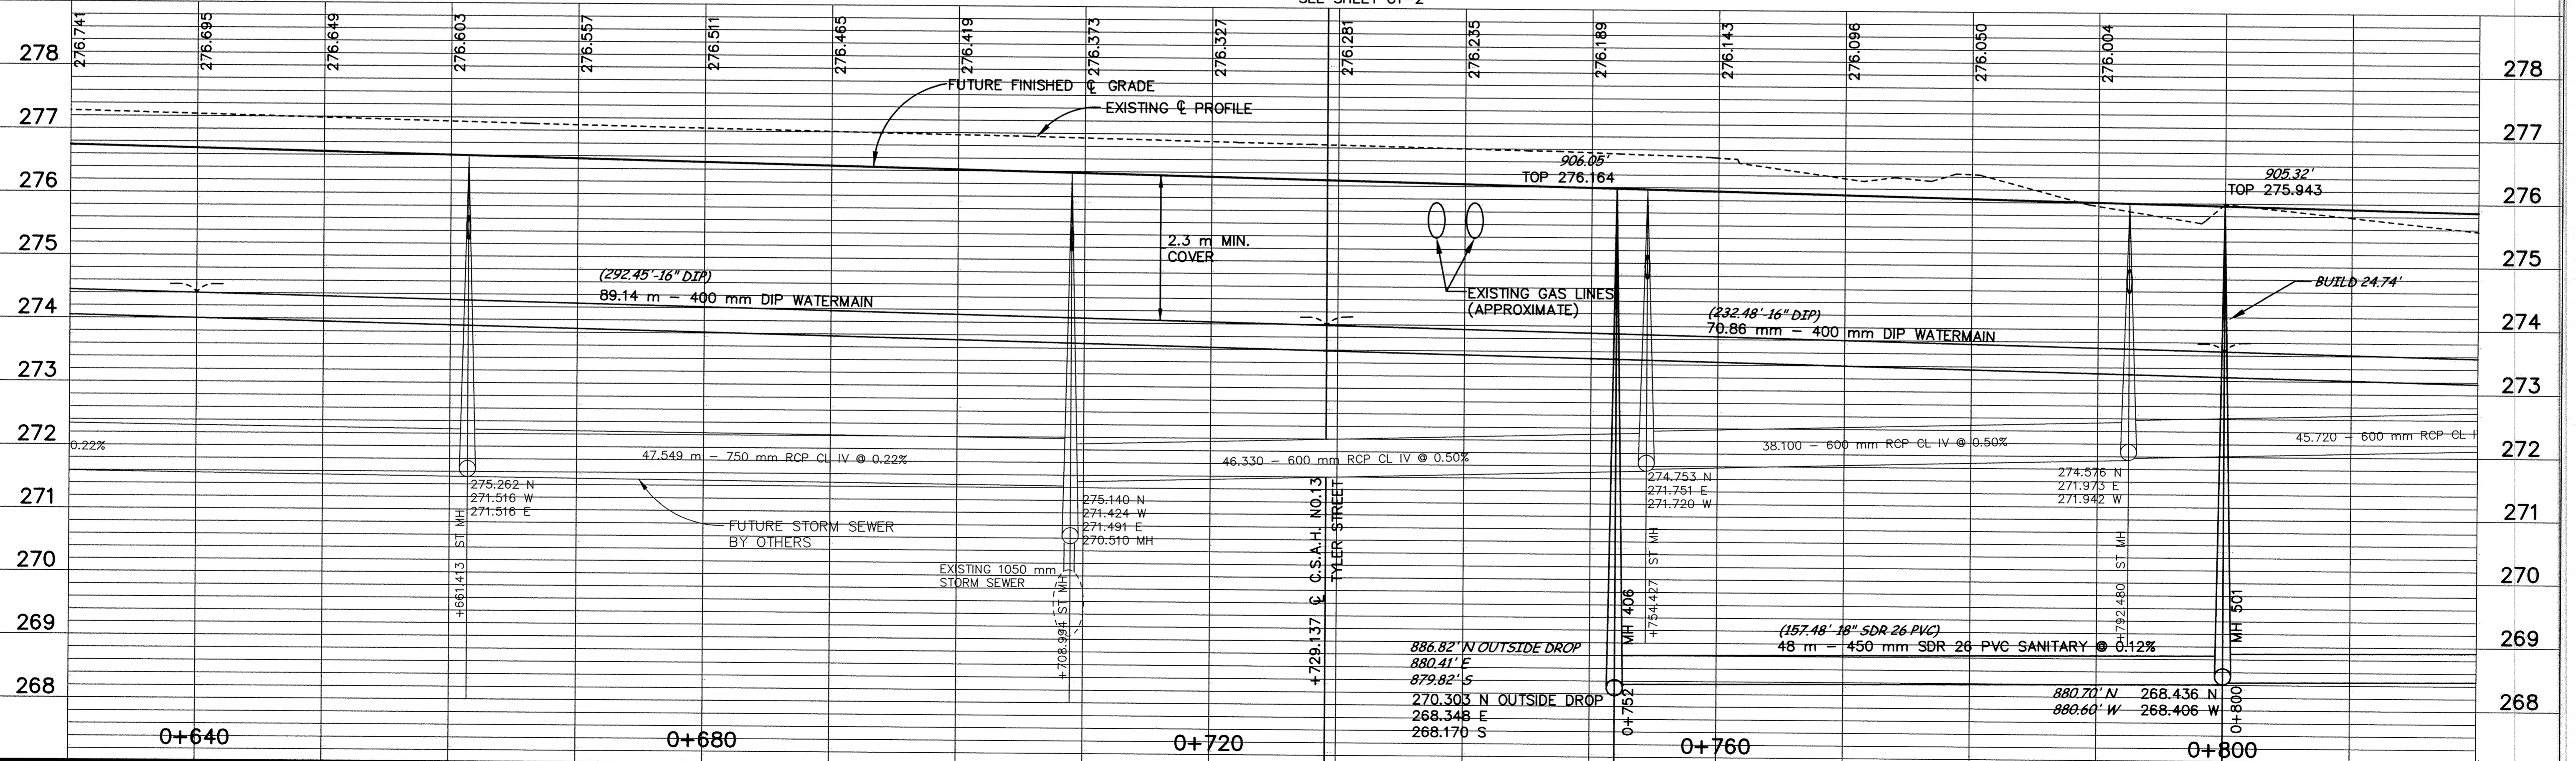


# C.S.A.H. NO.12

NOTE:  
CONTRACTOR TO REMOVE  
AND REPLACE EXISTING  
BITUMINOUS AS DIRECTED  
BY ENGINEER

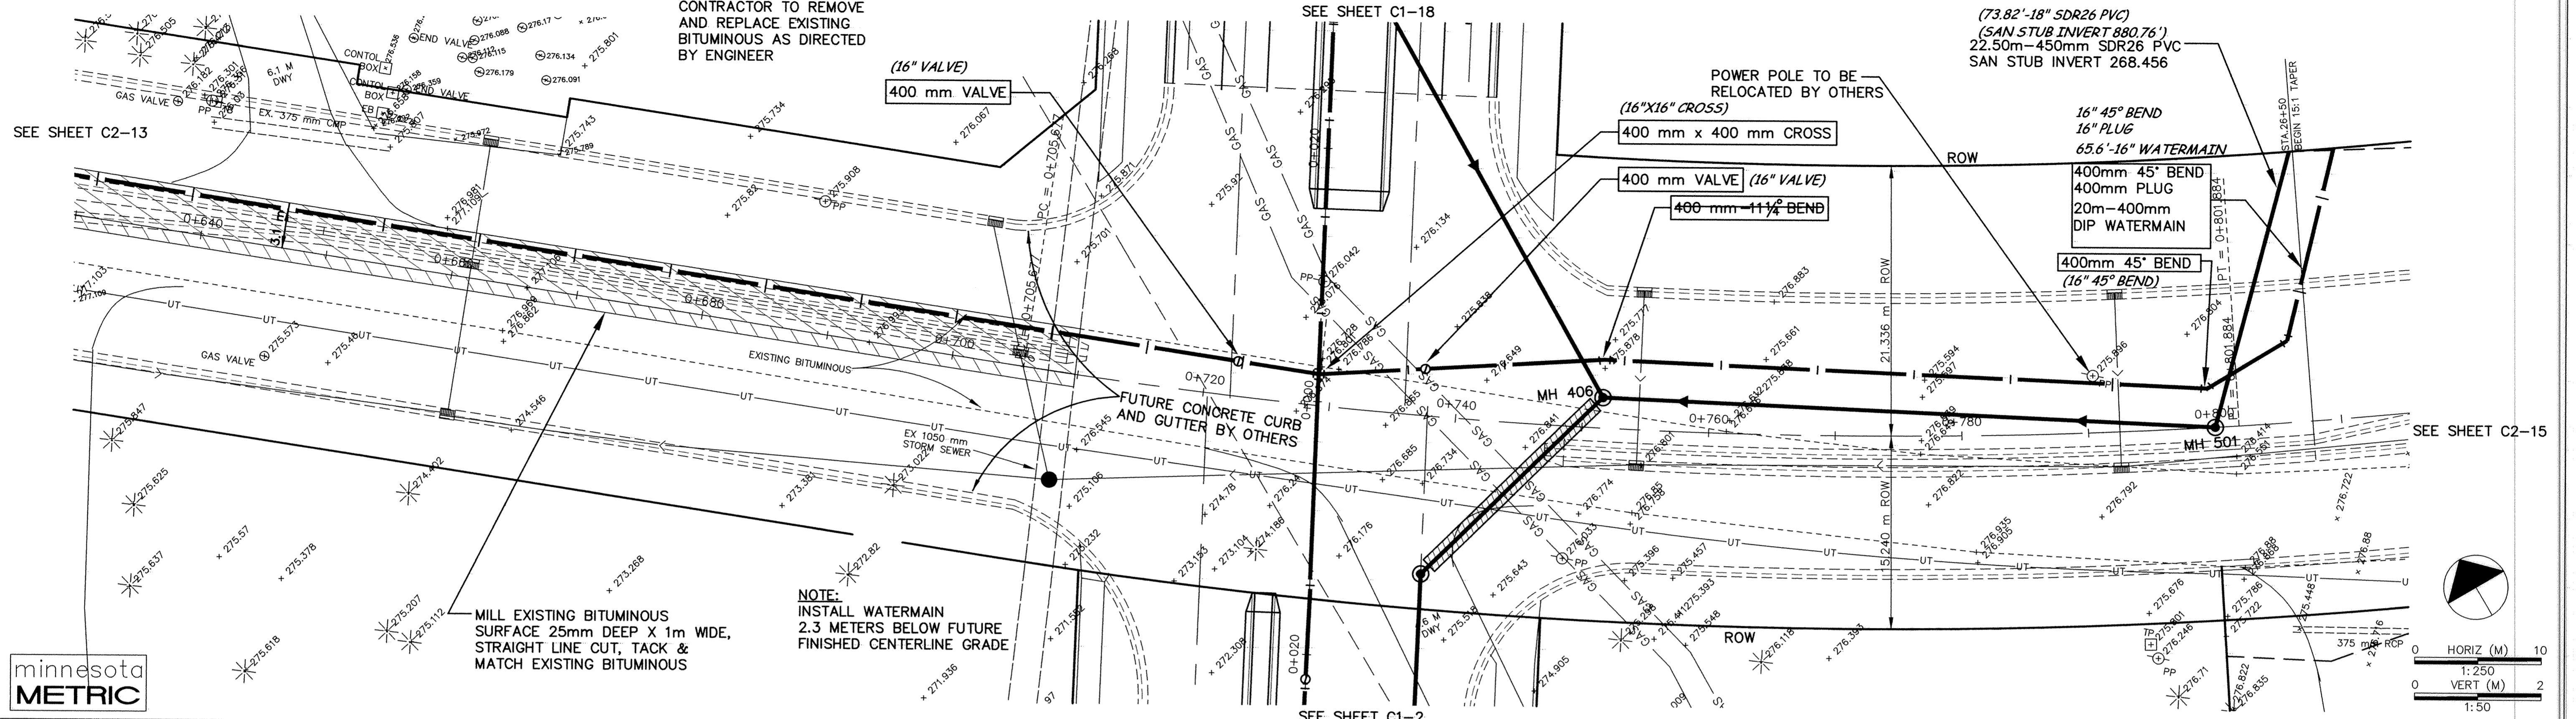

DESIGNED BY: \_\_\_\_\_ JOB DATE: JULY 1998  
DRAWN BY: \_\_\_\_\_ JOB NUMBER: 800110J  
APPROVED: March 29, 2001 9:53 AM DATE: JULY 1998  
CAD FILE: 800110J-AS-BUILTS-AS\_BALDWIN-5TH-AS10.DWG

I HEREBY CERTIFY THAT THIS PLAN, SPECIFICATION, OR REPORT WAS PREPARED BY ME OR UNDER MY DIRECT SUPERVISION AND THAT I AM A DULY REGISTERED PROFESSIONAL ENGINEER UNDER THE LAWS OF THE STATE OF MINNESOTA.  
DATE \_\_\_\_\_ REG. NO. \_\_\_\_\_

NO.	DATE	BY	REVISION DESCRIPTION
1	1-22-99	PH	REVISED WM STUB AND SAN STUB AS PER DEVELOPER C.O. NO. 1

1326 ENERGY PARK DRIVE  
ST. PAUL, MINNESOTA 55108  
(612) 644-4389

**Howard R. Green Company**  
CONSULTING ENGINEERS

CITY OF ELK RIVER  
EASTERN AREA  
PHASE I IMPROVEMENTS

WATERMAIN IMPROVEMENTS  
C.S.A.H. NO.12  
0+640 TO 0+800

SHEET NO.  
**C2-14**