
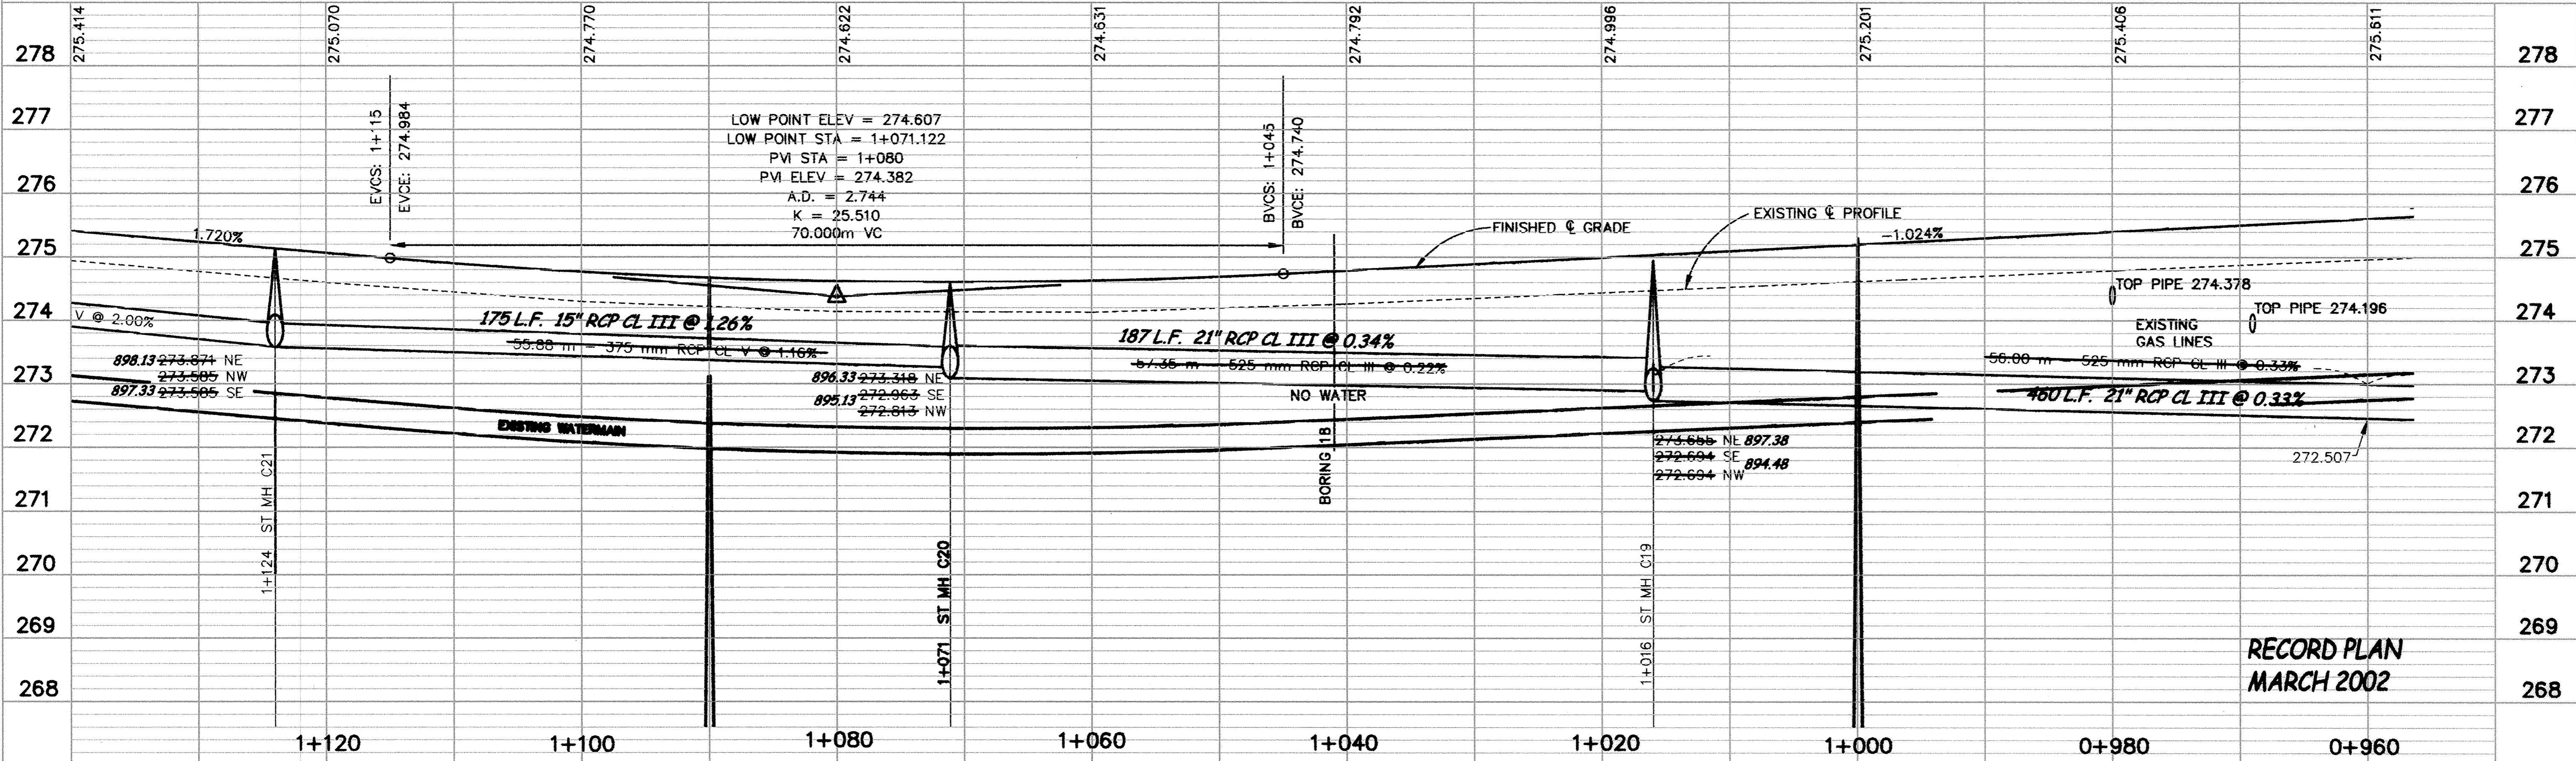
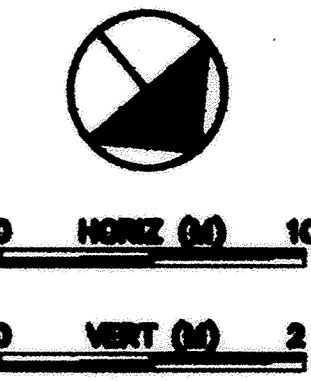


TYLER STREET

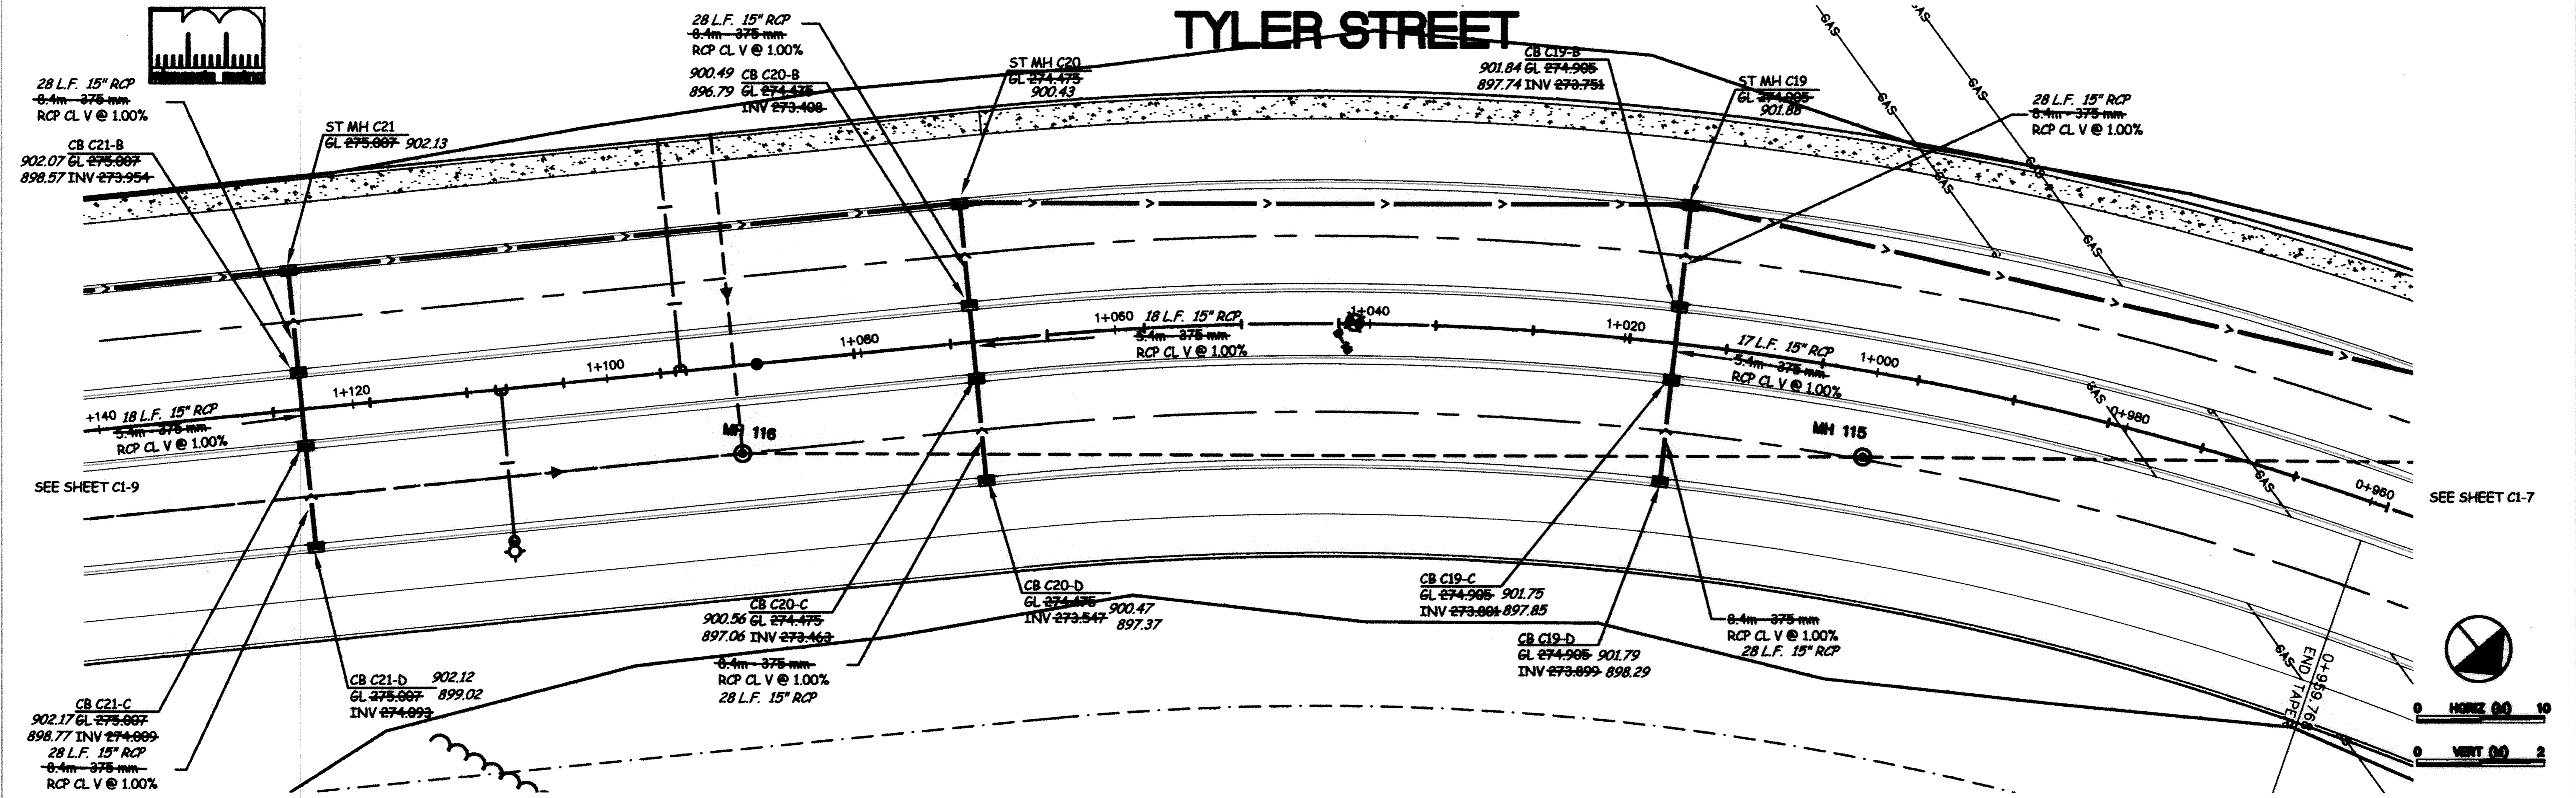

RECORD PLAN
MARCH 2002

DESIGNED BY: --- DRAWN BY: *AG*
 APPROVED: --- JOB NUMBER: 800110J
 CAD DATE: April 16, 2002 1:39:34 p.m.
 CAD FILE: 800110T\Asbulita\SEGMENT_07.DWG

I HEREBY CERTIFY THAT THIS PLAN, SPECIFICATION, OR REPORT WAS PREPARED BY ME OR UNDER MY DIRECT SUPERVISION AND THAT I AM A DULY REGISTERED PROFESSIONAL ENGINEER UNDER THE LAWS OF THE STATE OF MINNESOTA.
 DATE: _____ REG. NO. _____

NO.	DATE	BY	REVISION DESCRIPTION
1.	11-8-99	RM	REVISE STORM SEWER & PROFILE

1326 ENERGY PARK DRIVE
 ST. PAUL, MINNESOTA 55108
 (612) 644-4389
Howard R. Green Company
 CONSULTING ENGINEERS

CITY OF ELK RIVER
EASTERN AREA
TYLER STREET IMPROVEMENTS

PLAN + PROFILE 8. OF CBAH 12
 SP 71-03-01, SP 204-030-01, SP 204-130-01, SP 204-132-01
 01080 TO 11084

SHEET NO.
C1-8