
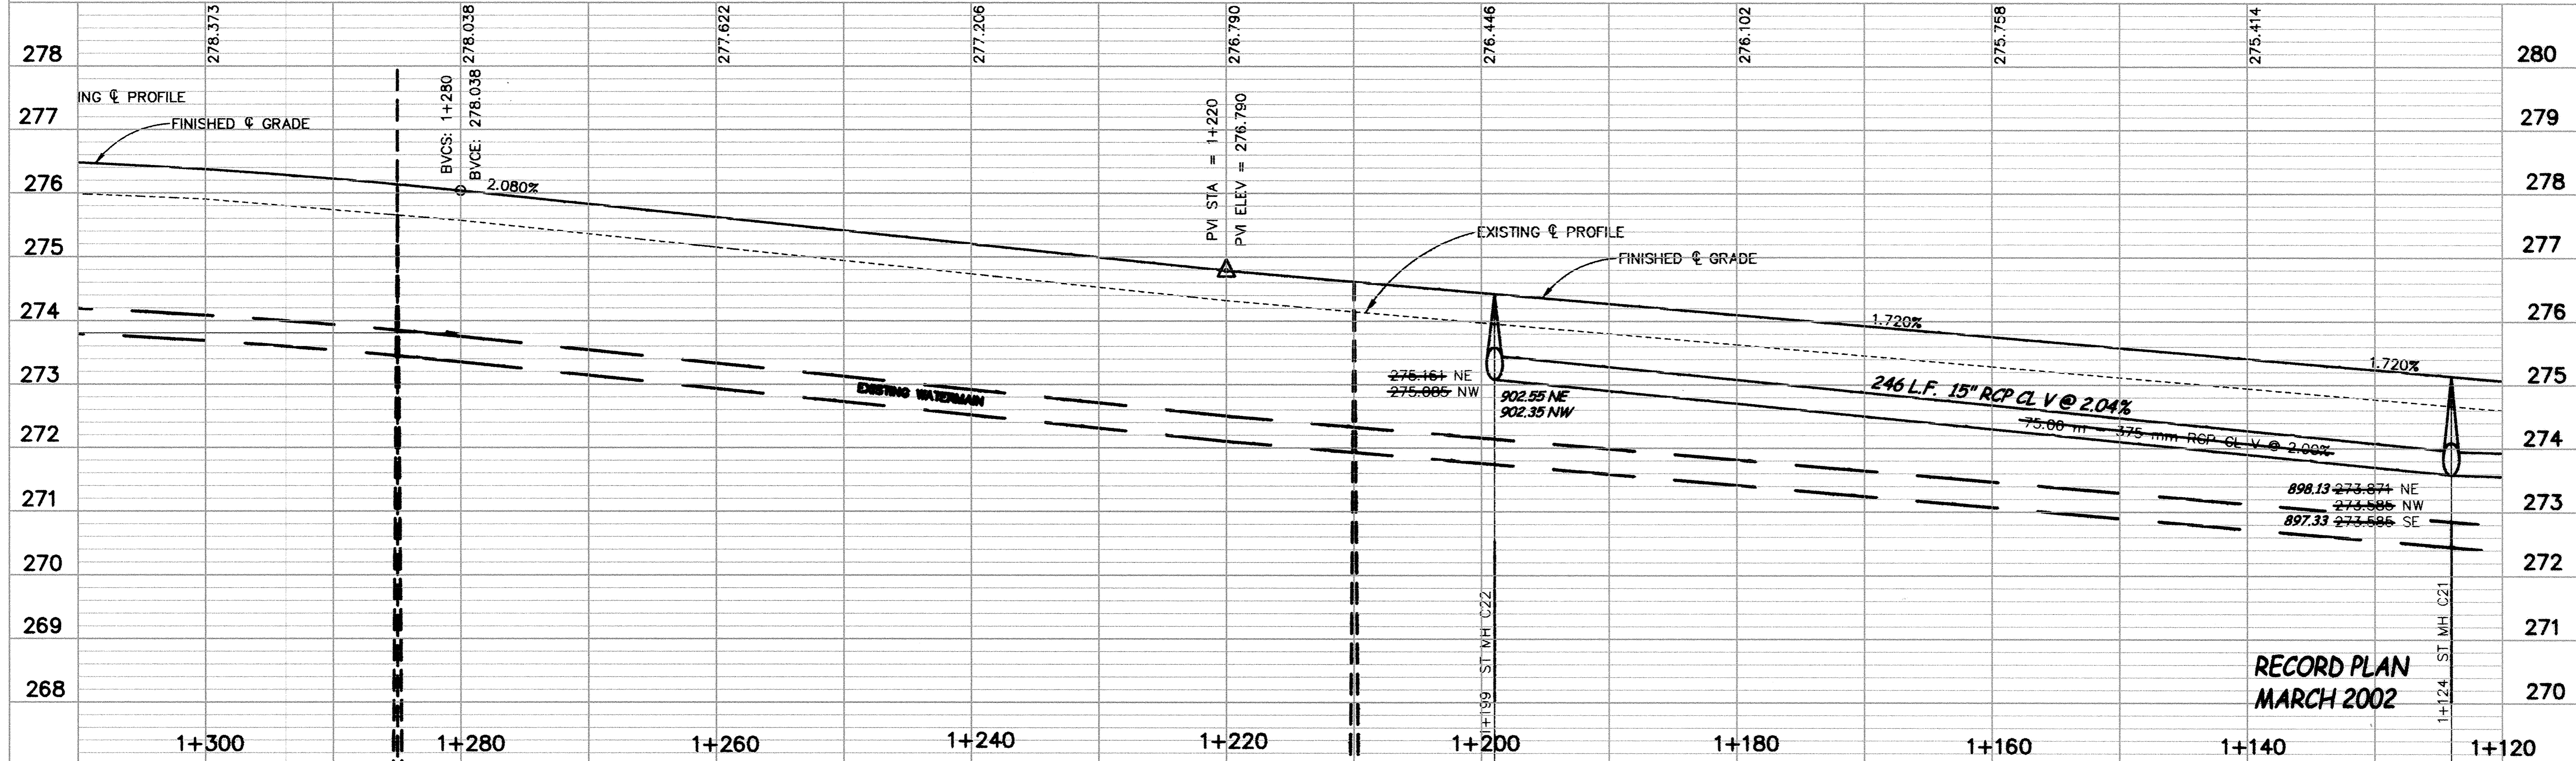


# TYLER STREET

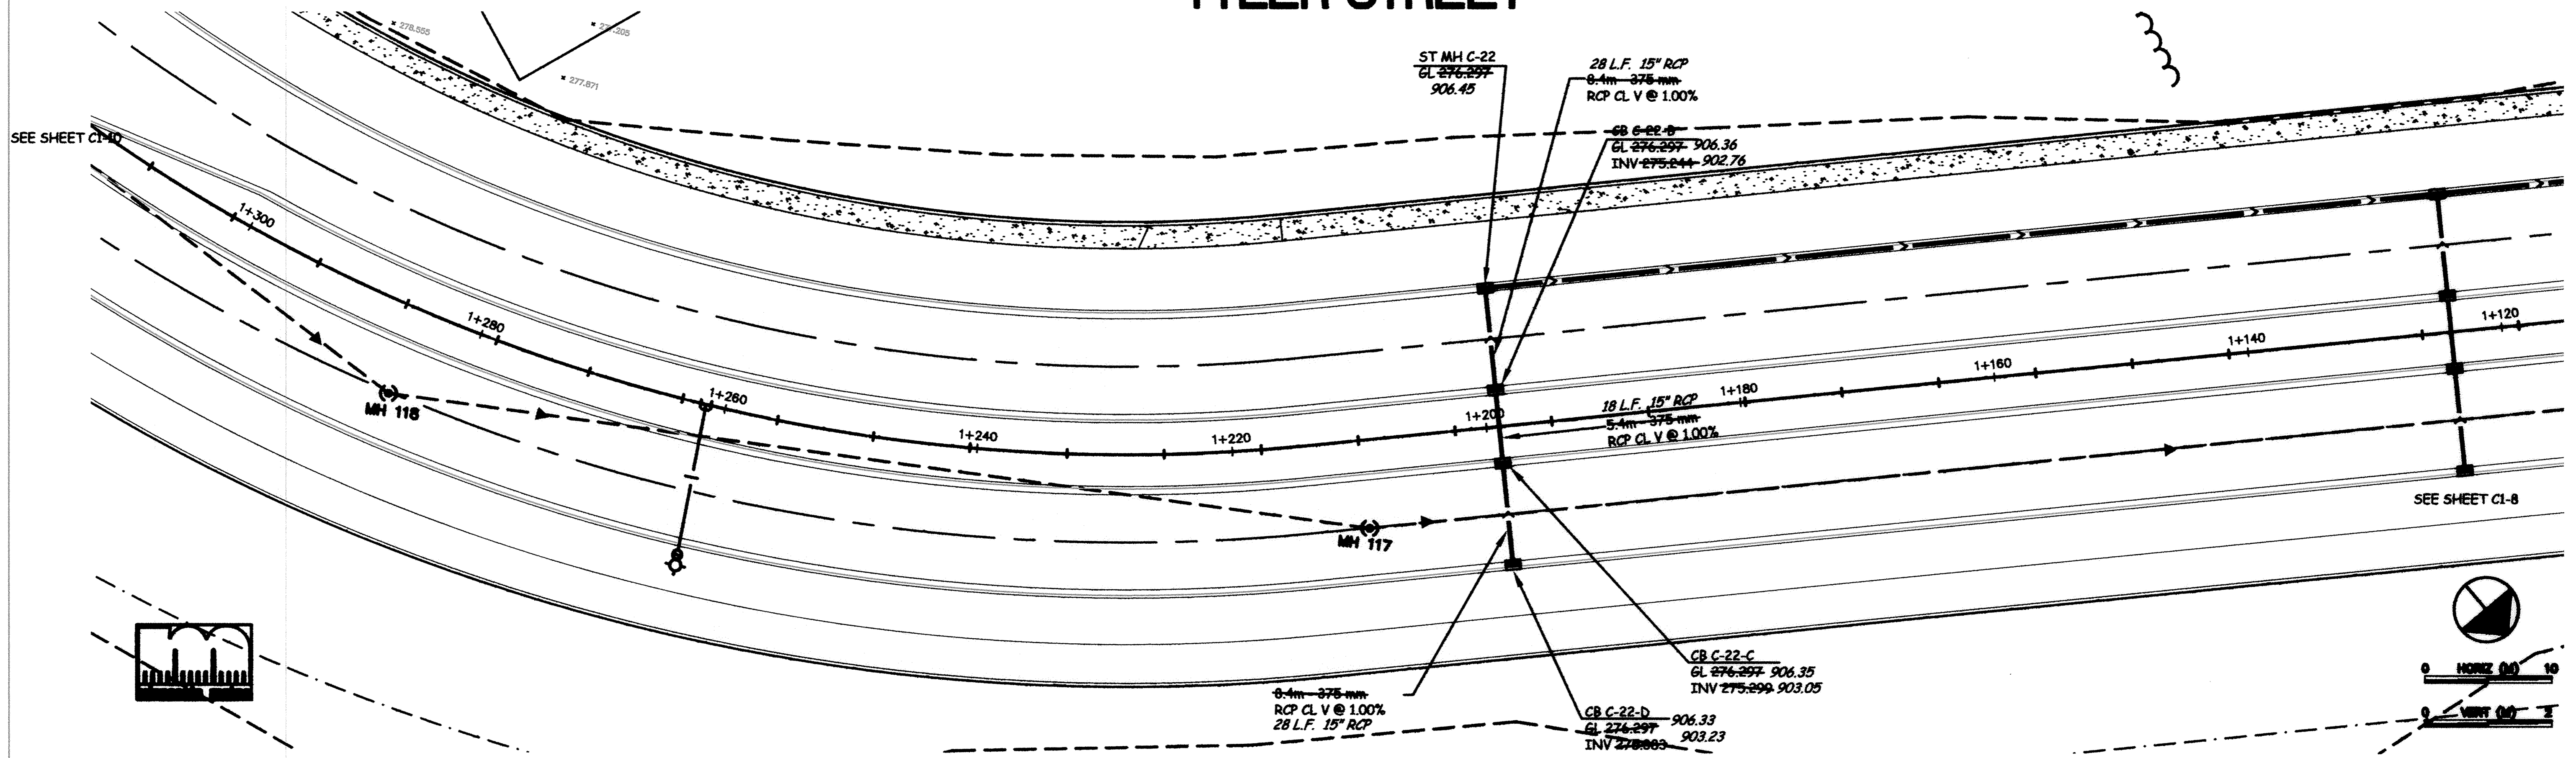

DESIGNED BY: --- DRAWN BY: *[Signature]*  
 APPROVED: --- JOB NUMBER: 800110J  
 CAD DATE: April 16, 2002 1:49:31 p.m.  
 CAD FILE: 800110T\Asbuilt\SEGMENT\_08.DWG

I HEREBY CERTIFY THAT THIS PLAN, SPECIFICATION, OR REPORT WAS PREPARED BY ME OR UNDER MY DIRECT SUPERVISION AND THAT I AM A DULY REGISTERED PROFESSIONAL ENGINEER UNDER THE LAWS OF THE STATE OF MINNESOTA.  
 DATE: \_\_\_\_\_ REG. NO. \_\_\_\_\_

NO.	DATE	BY	REVISION DESCRIPTION

**Howard R. Green Company**  
 CONSULTING ENGINEERS  
 1326 ENERGY PARK DRIVE  
 ST. PAUL, MINNESOTA 55108  
 (612) 644-4389

**CITY OF ELK RIVER**  
 EASTERN AREA  
 TYLER STREET IMPROVEMENTS

**PLAN + PROFILE 8. OF C&A# 12**  
 SP 71-03-03, SP 204-030-03, SP 204-030-01, SP 204-030-03  
 1184 TO 1180

SHEET NO.  
**118**