

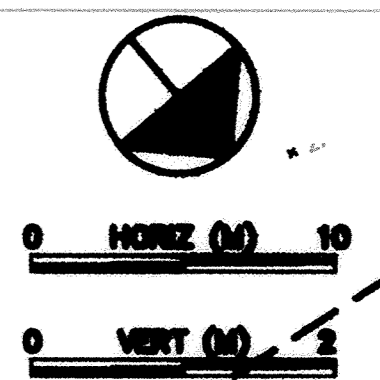


TYLER STREET

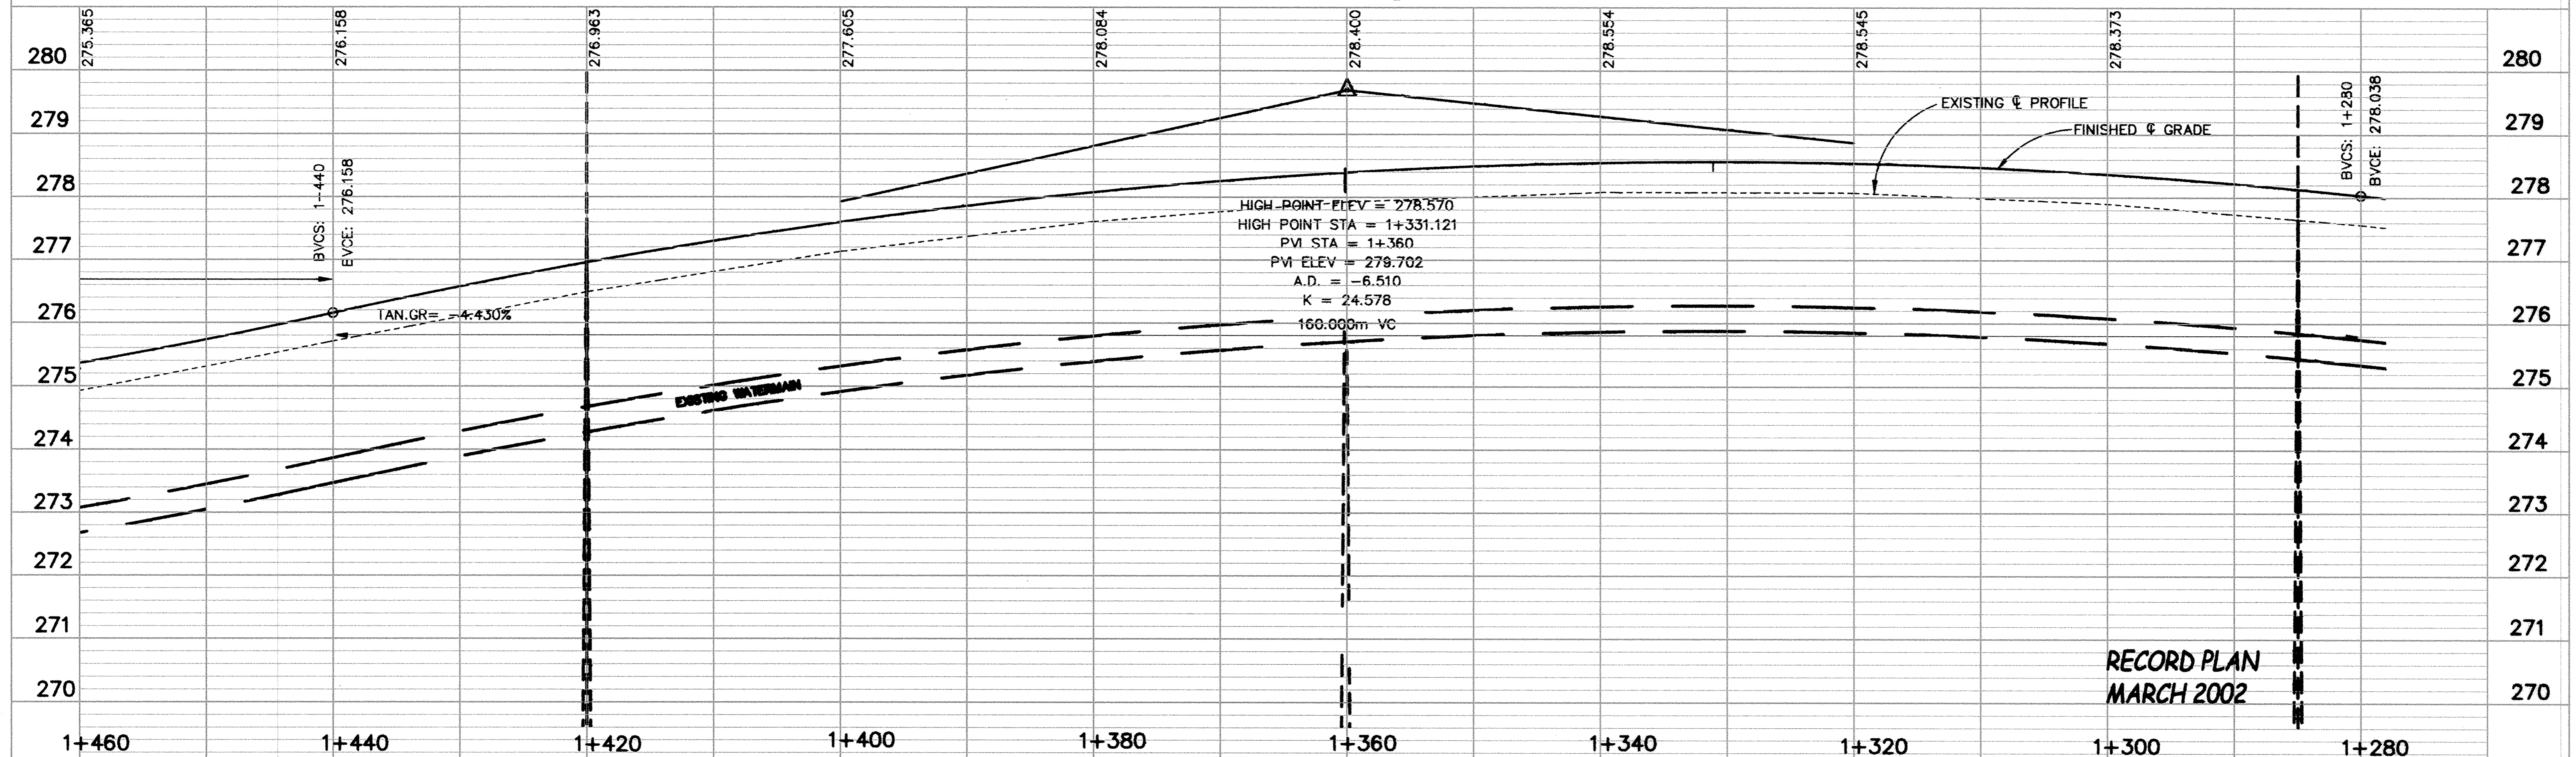

SEE SHEET C1-11

SEE SHEET C1-9

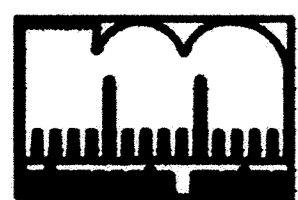

RECORD PLAN
MARCH 2002

DESIGNED BY: _____ DRAWN BY: *agf*
 APPROVED: _____ JOB NUMBER: 800110J
 CAD DATE: April 16, 2002 2:01:54 p.m.
 CAD FILE: 800110T\Asbuilt\SEGMENT\09.DWG

I HEREBY CERTIFY THAT THIS PLAN, SPECIFICATION,
 OR REPORT WAS PREPARED BY ME OR UNDER MY DIRECT
 SUPERVISION AND THAT I AM A DULY REGISTERED
 PROFESSIONAL ENGINEER UNDER THE LAWS OF THE
 STATE OF MINNESOTA.
 DATE _____ REG. NO. _____

NO.	DATE	BY	REVISION DESCRIPTION


 Howard R. Green Company
 CONSULTING ENGINEERS
 1326 ENERGY PARK DRIVE
 ST. PAUL, MINNESOTA 55108
 (612) 644-4389

CITY OF ELK RIVER
EASTERN AREA
TYLER STREET IMPROVEMENTS

PLAN + PROFILE 8. OF C.S.A.H. 12
SP 71-02-02, SP 204-020-02, SP 204-122-01, SP 204-122-02
1+280 TO 1+440

SHEET NO.
C1-10

DRAWING NUMBER EASTE.01 25