
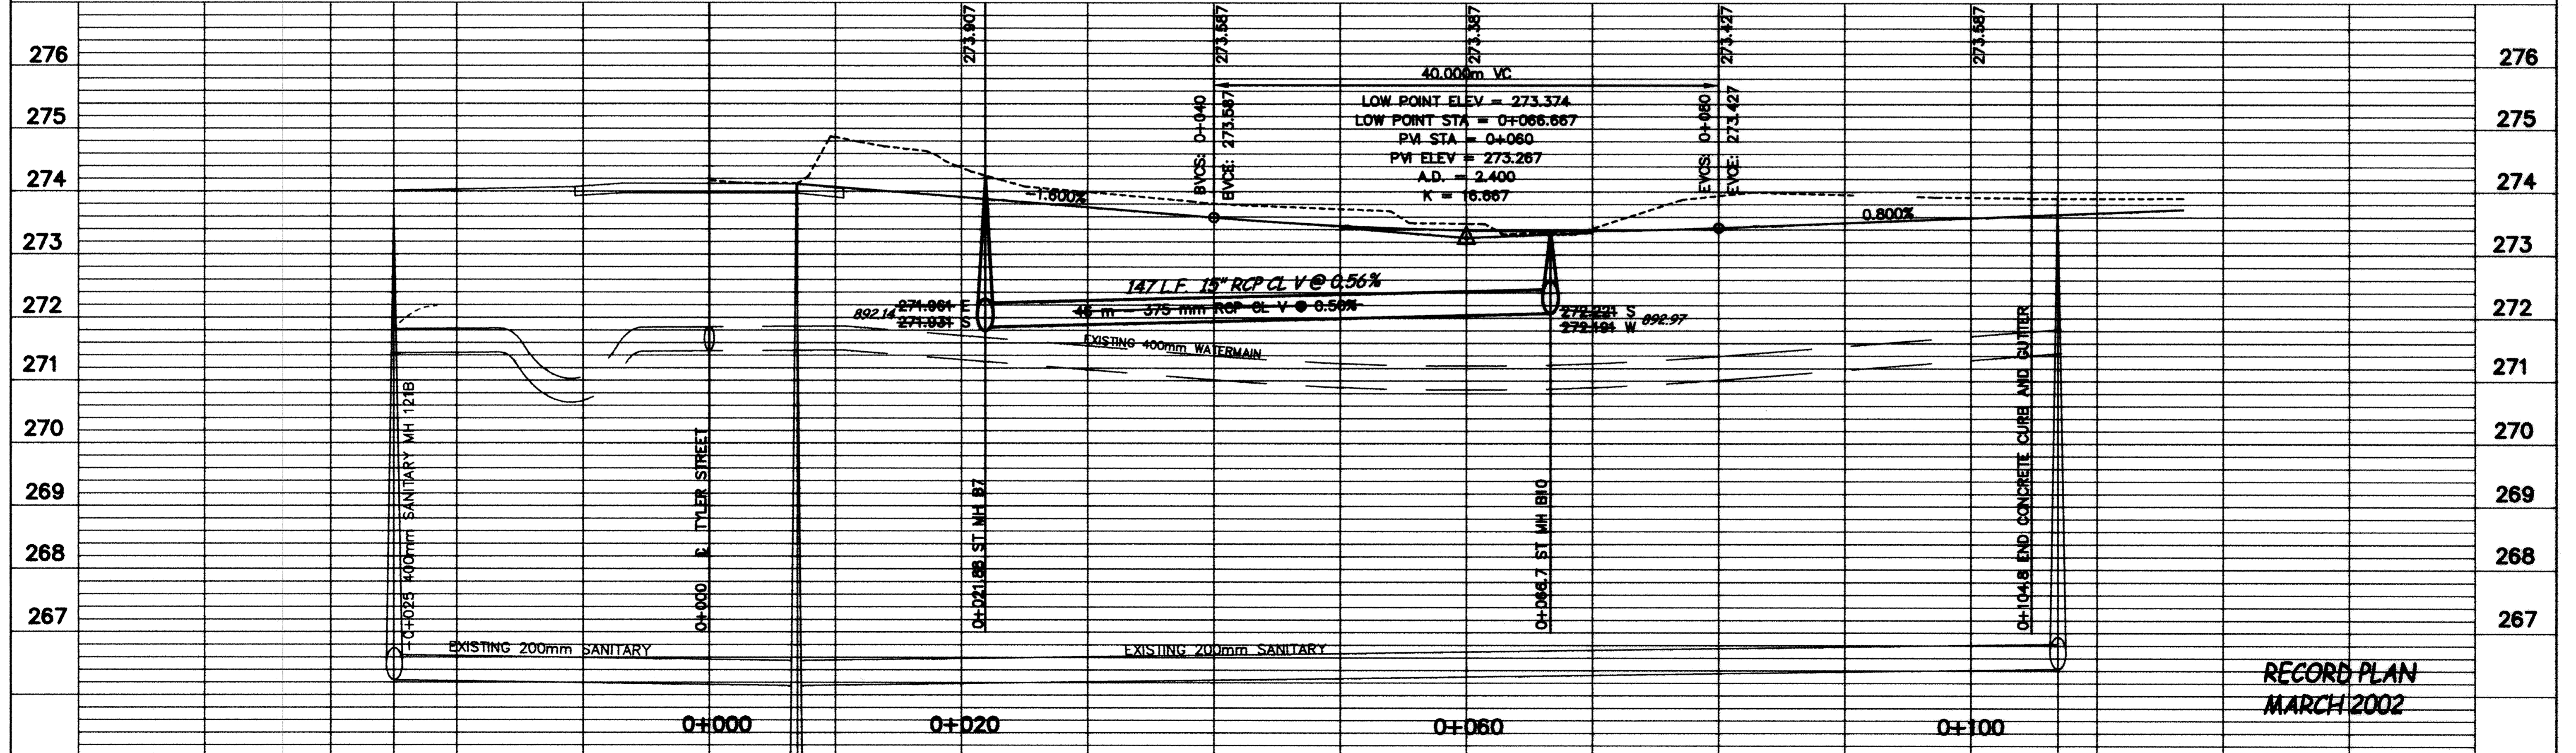
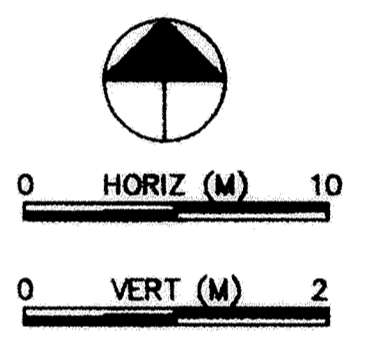


175TH AVENUE

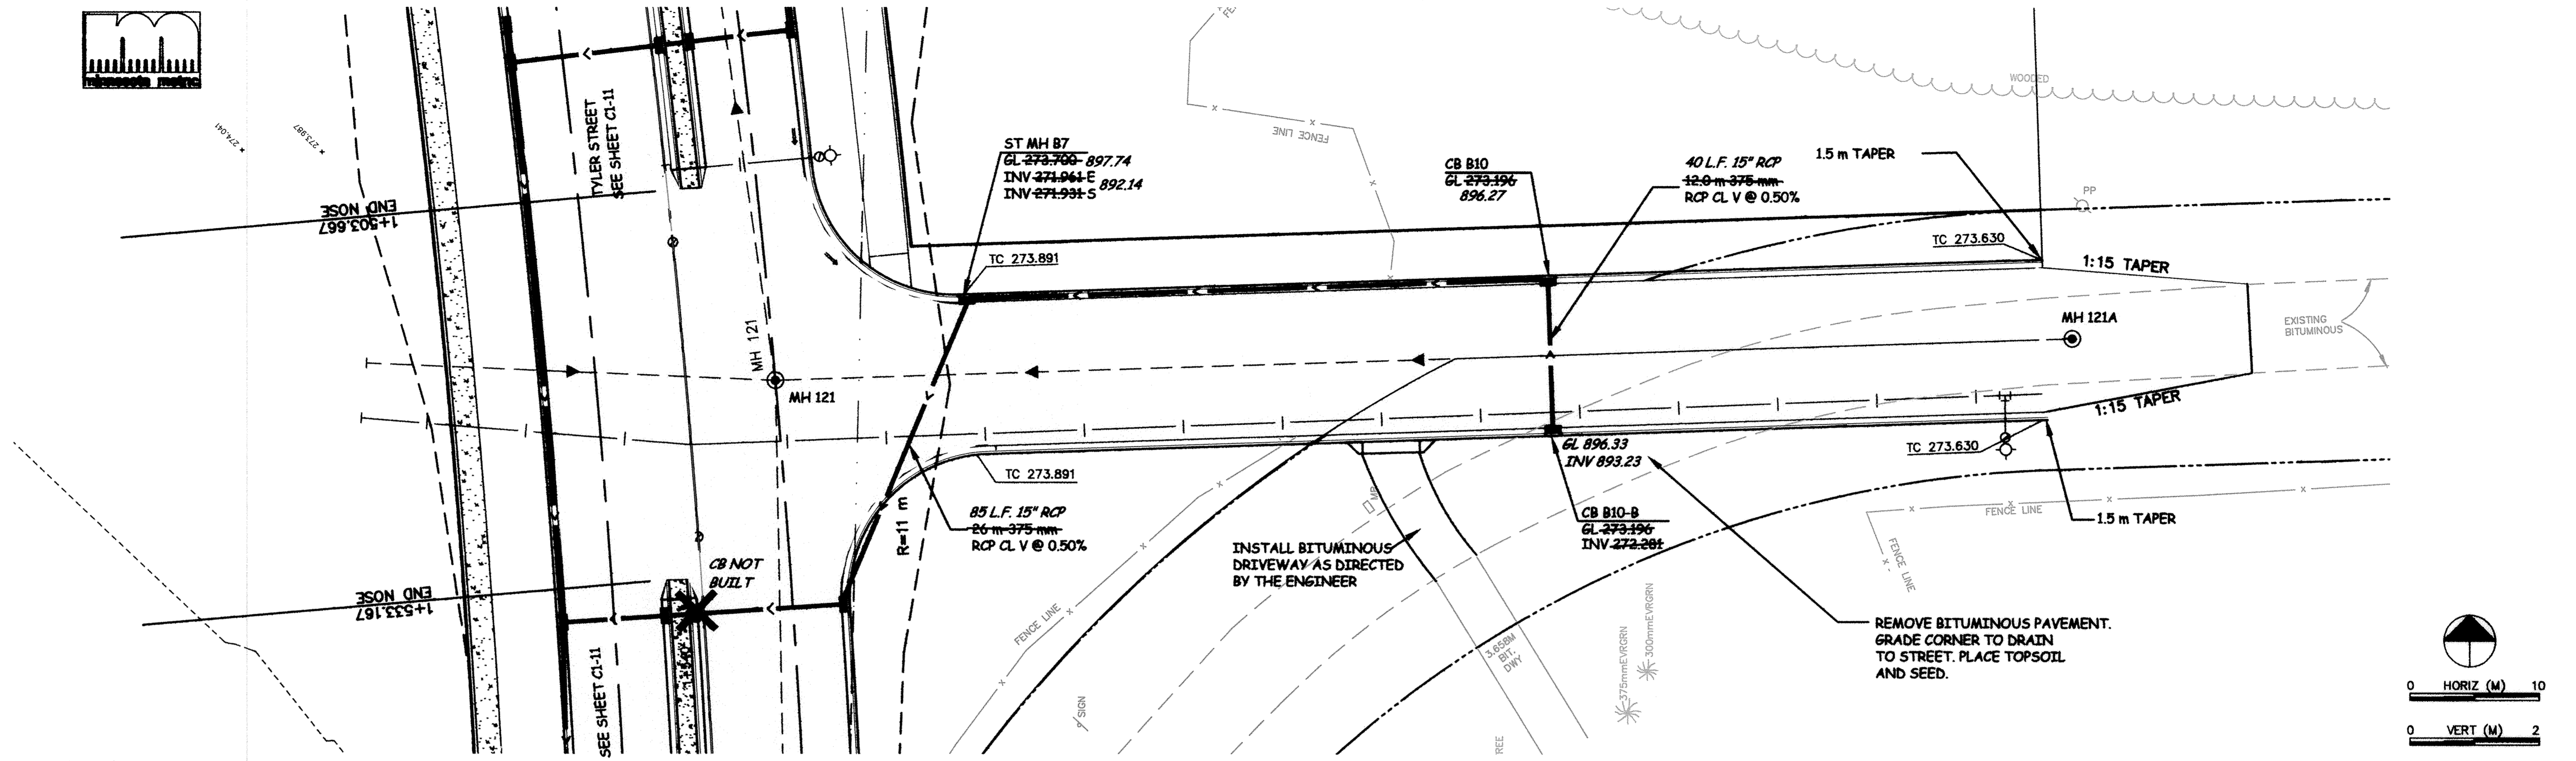

RECORD PLAN
MARCH 2002

DESIGNED BY: AB JOB DATE: OCT1998
 DRAWN BY: [Signature] JOB NUMBER: 800110J
 APPROVED: [Signature] CAD DATE:
 CAD FILE: April 16, 2002 2:37:28 p.m.
 800110T\asub\175 SEGMENT\17.DWG

I HEREBY CERTIFY THAT THIS PLAN, SPECIFICATION, OR REPORT WAS PREPARED BY ME OR UNDER MY DIRECT SUPERVISION AND THAT I AM A DULY REGISTERED PROFESSIONAL ENGINEER UNDER THE LAWS OF THE STATE OF MINNESOTA.
 DATE: _____ REG. NO. _____

NO.	DATE	BY	REVISION DESCRIPTION
1.	11-8-99	RM	REVISE STORM SEWER

1326 ENERGY PARK DRIVE
 ST. PAUL, MINNESOTA 55108
 (612) 644-4389

Howard R. Green Company
 CONSULTING ENGINEERS

CITY OF ELK RIVER
EASTERN AREA
TYLER STREET IMPROVEMENTS

PLAN + PROFILE 175TH AVENUE
 SP 71-613-08, SP 204-020-03, SP 204-133-01, SP 204-132-03
 0+000 TO 1+021

SHEET NO.
C1-11A

DRAWING NUMBER
 DRAWING NUMBER
 EASTE 01
 DRAWING NUMBER