
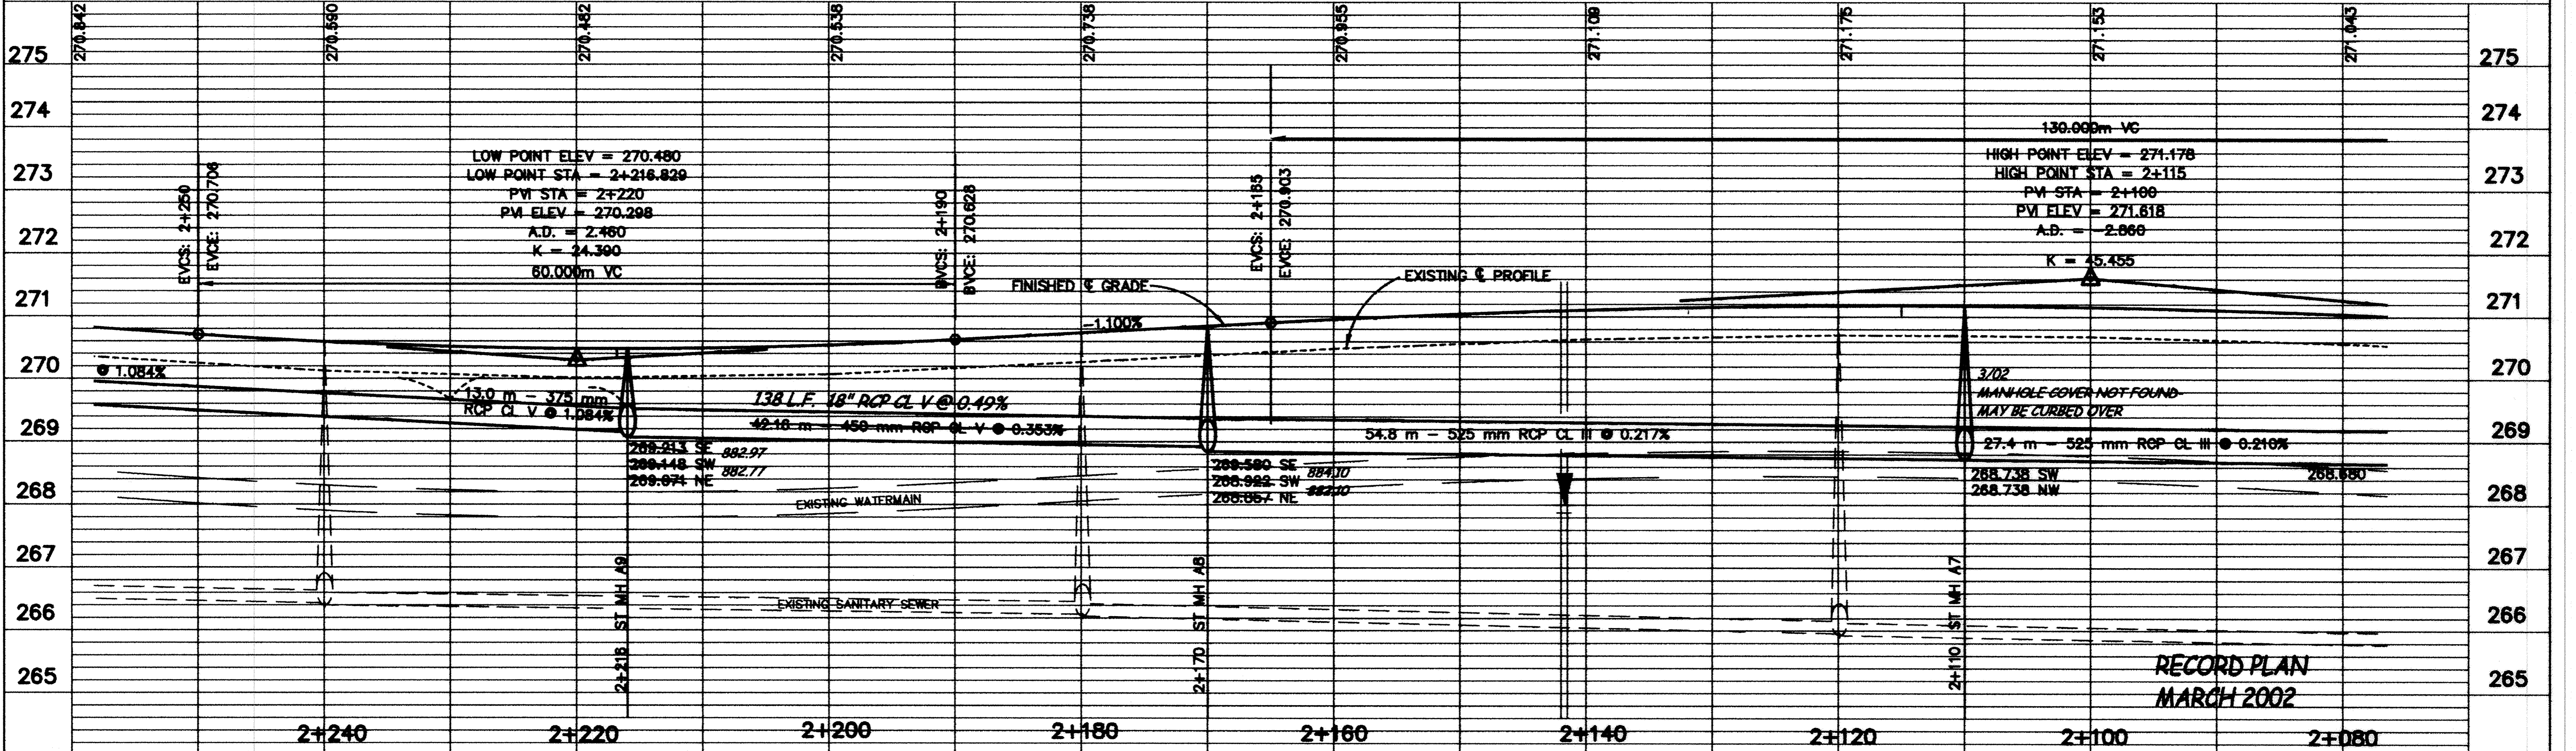


# TYLER STREET

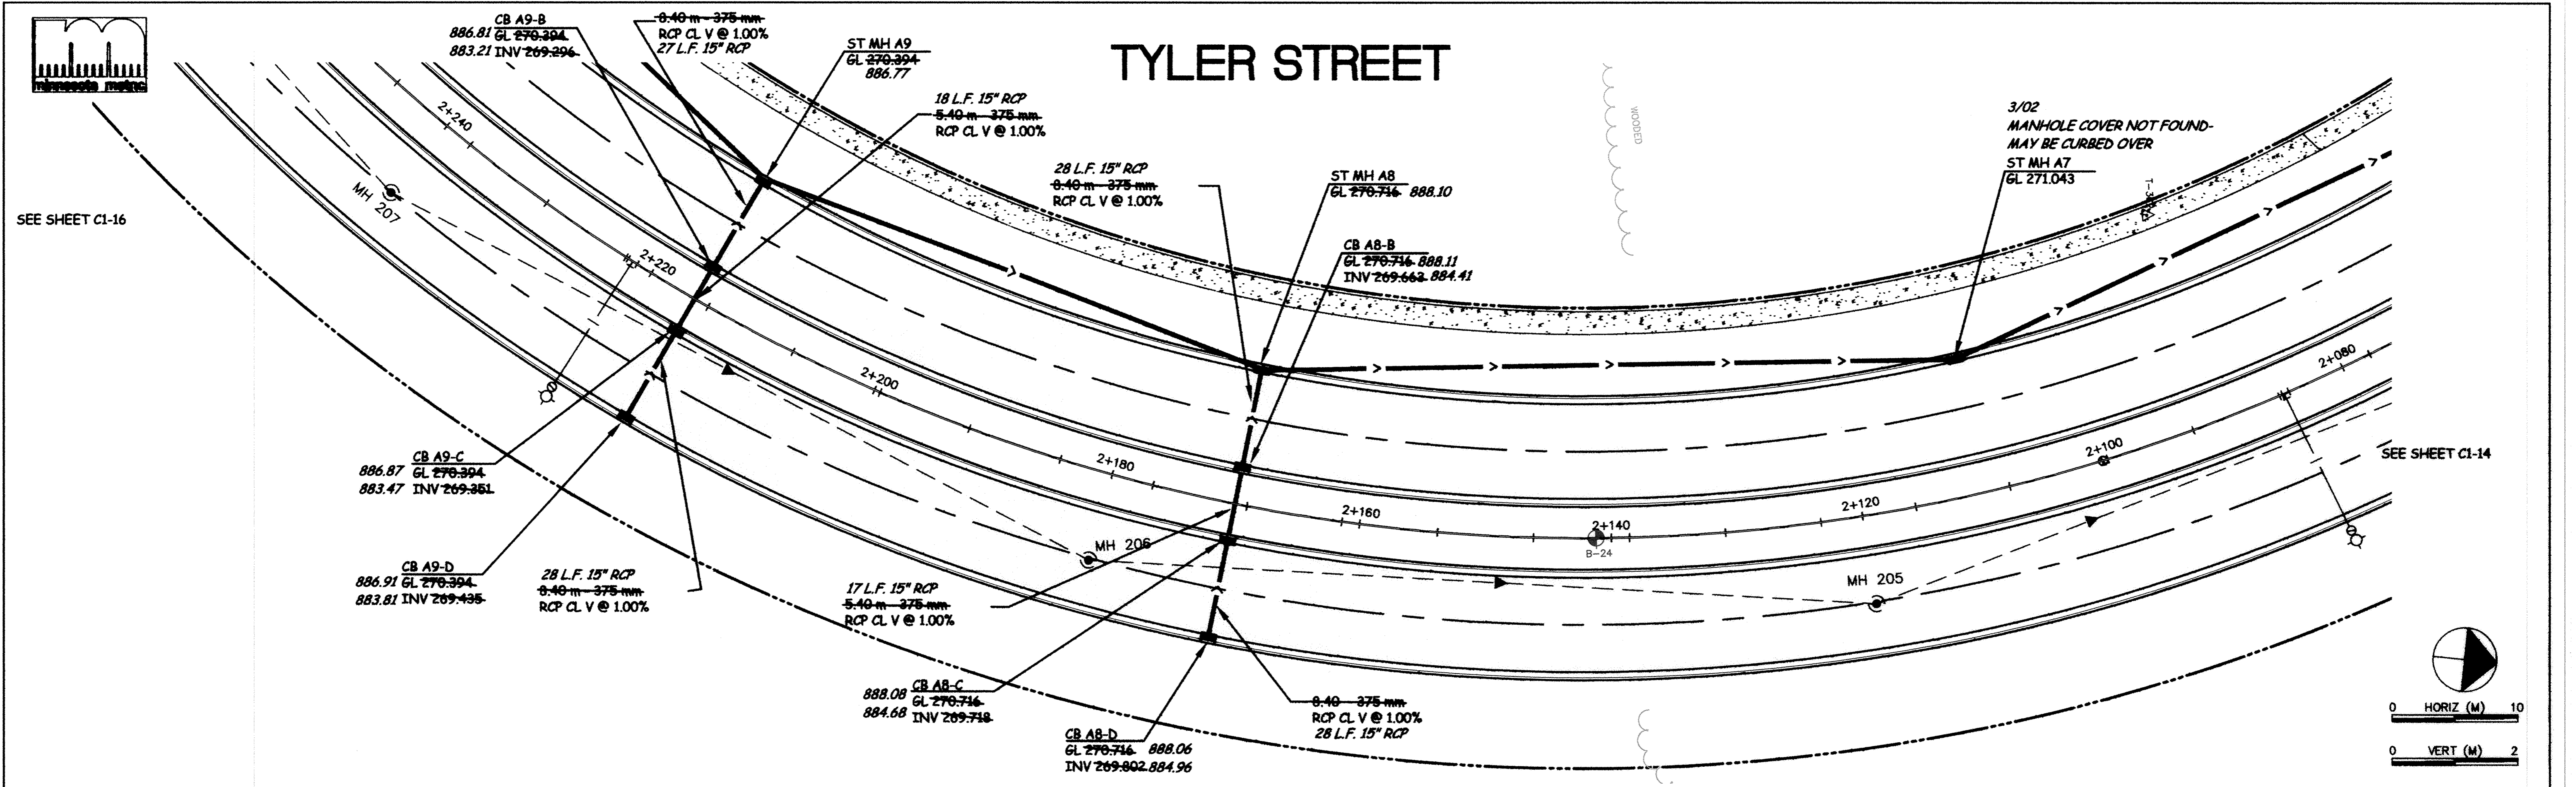

DESIGNED BY: --- DRAWN BY: *[Signature]*  
 APPROVED: --- JOB NUMBER 800110J  
 CAD DATE: April 17, 2002 1:49:13 p.m.  
 CAD FILE: 8001101\Asbuilts\S\_SEGMENT\14.DWG

I HEREBY CERTIFY THAT THIS PLAN, SPECIFICATION, OR REPORT WAS PREPARED BY ME OR UNDER MY DIRECT SUPERVISION AND THAT I AM A DULY REGISTERED PROFESSIONAL ENGINEER UNDER THE LAWS OF THE STATE OF MINNESOTA.  
 DATE: \_\_\_\_\_ REG. NO. \_\_\_\_\_

NO.	DATE	BY	REVISION DESCRIPTION
1.	11-8-99	RM	REVISE STORM SEWER

**Howard R. Green Company**  
 CONSULTING ENGINEERS  
 1326 ENERGY PARK DRIVE  
 ST. PAUL, MINNESOTA 55108  
 (612) 644-4388

**CITY OF ELK RIVER**  
 EASTERN AREA  
 TYLER STREET IMPROVEMENTS

**PLAN + PROFILE S. OF C.S.A.H. 12**  
 SP 71-613-08, SP 204-020-03, SP 204-133-01, SP 204-132-03  
 2+080 TO 2+230

SHEET NO.  
**C1-15**

3/2002 RECORD PLAN MARCH 2002