
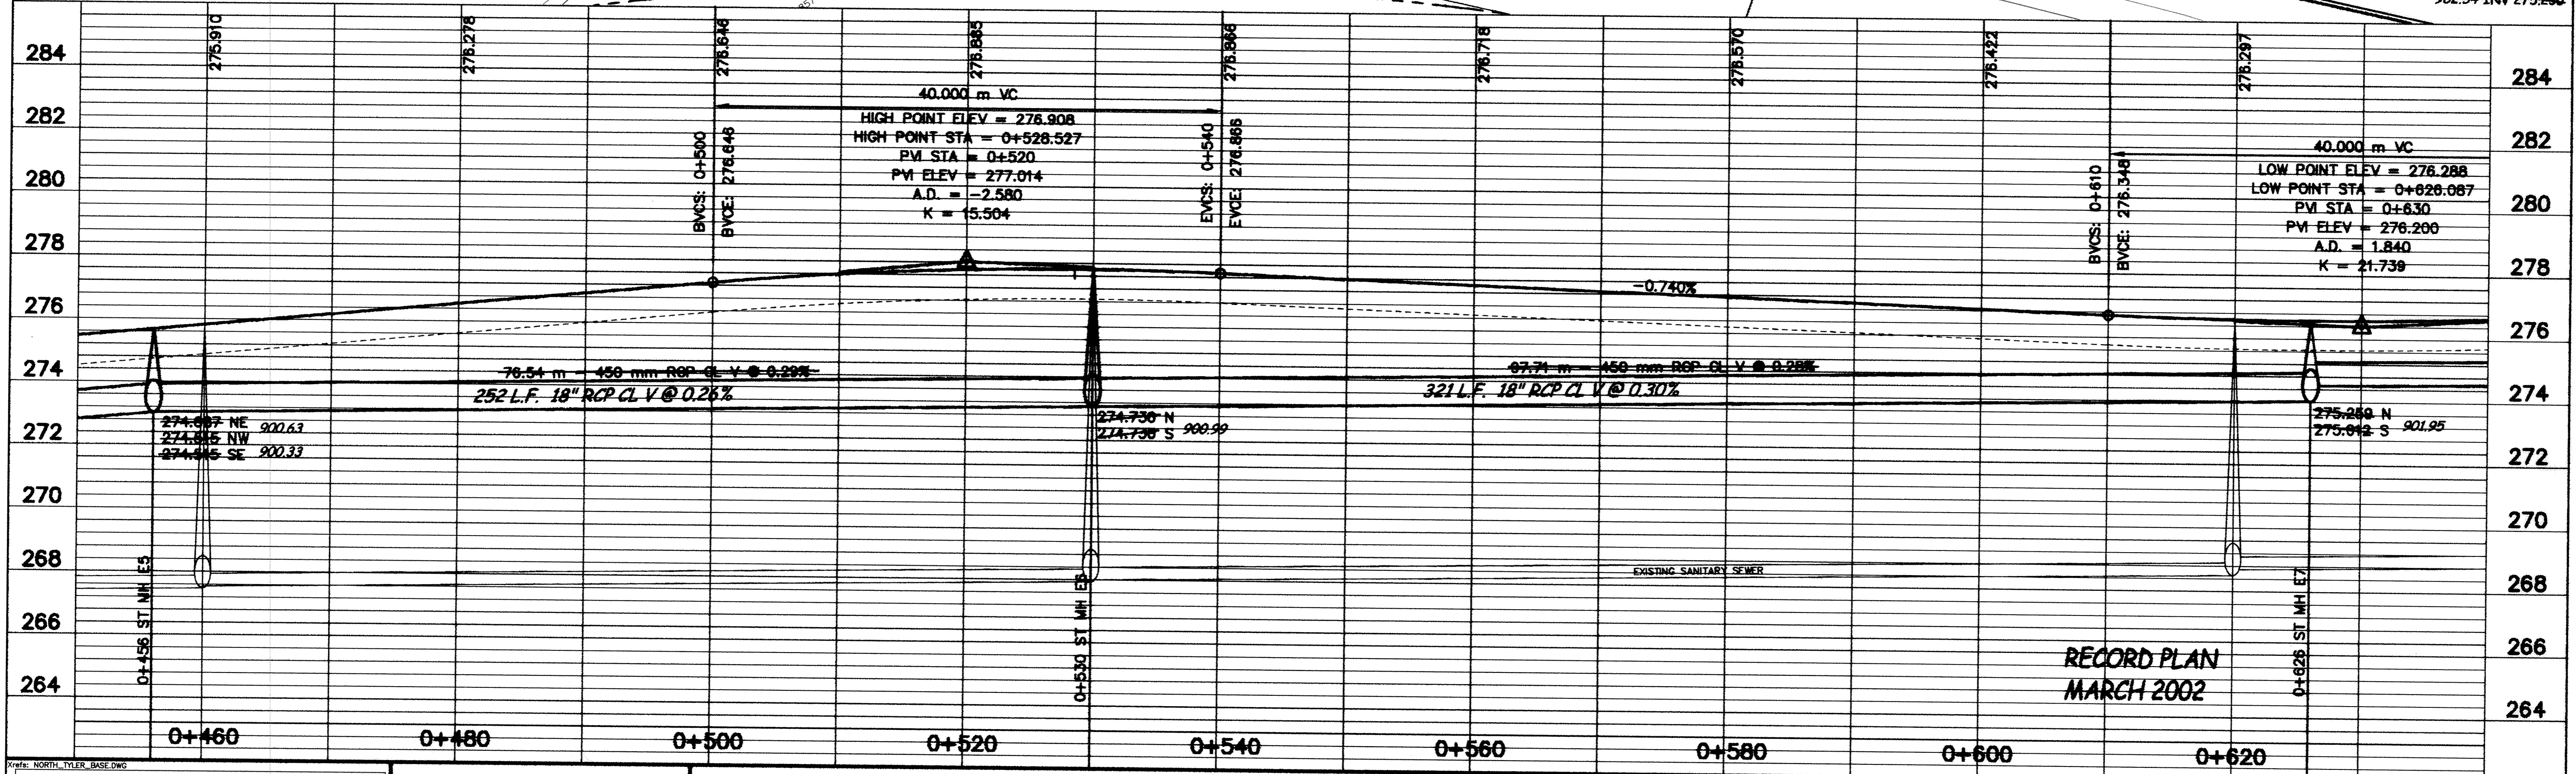
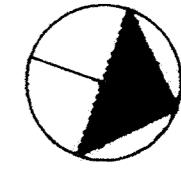


TYLER STREET

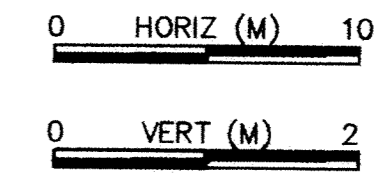

DESIGNED BY: --- DRAWN BY: *agf*
 APPROVED: --- JOB NUMBER 800110J
 CAD DATE: April 17, 2002 3:47:34 p.m.
 CAD FILE: 800110T\Asbuilts\N SEGMENT\04.DWG

I HEREBY CERTIFY THAT THIS PLAN, SPECIFICATION, OR REPORT WAS PREPARED BY ME OR UNDER MY DIRECT SUPERVISION AND THAT I AM A DULY REGISTERED PROFESSIONAL ENGINEER UNDER THE LAWS OF THE STATE OF MINNESOTA.
 DATE 10/15/98 REG. NO. 15316

NO.	DATE	BY	REVISION DESCRIPTION
1.	11-8-99	RM	REVISE TOPOGRAPHY

Howard R. Green Company
 CONSULTING ENGINEERS
 1326 ENERGY PARK DRIVE
 ST. PAUL, MINNESOTA 55108
 (612) 644-4388

CITY OF ELK RIVER
 EASTERN AREA
 TYLER STREET IMPROVEMENTS

PLAN + PROFILE N. OF C.S.A.H. 12
 SP 71-613-08, SP 204-020-03, SP 204-133-01, SP 204-132-03
 0+456 TO 0+626

SHEET NO.
C1-21

DRAWING NUMBER EASTE 01 38