


DESIGNED BY: AB DRAWN BY: *[Signature]*  
 APPROVED: --- JOB NUMBER 800110J  
 CAD DATE: January 06, 2003 8:21:37 a.m.  
 CAD FILE: 8001101\Asbuilts\S\_SEGMENT\_X01.DWG (JULIEN)

I HEREBY CERTIFY THAT THIS PLAN, SPECIFICATION,  
 OR REPORT WAS PREPARED BY ME OR UNDER MY DIRECT  
 SUPERVISION AND THAT I AM A DULY REGISTERED  
 PROFESSIONAL ENGINEER UNDER THE LAWS OF THE  
 STATE OF MINNESOTA.  
 DATE \_\_\_\_\_ REG. NO. 15316

NO.	DATE	BY	REVISION DESCRIPTION

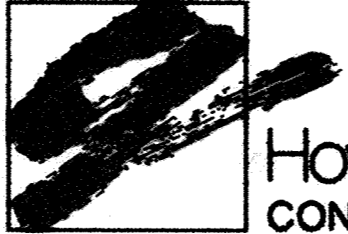

1326 ENERGY PARK DRIVE  
 ST. PAUL, MINNESOTA 55108  
 (612) 644-4388  
**Howard R. Green Company**  
 CONSULTING ENGINEERS

**CITY OF ELK RIVER**  
**EASTERN AREA**  
**TYLER STREET IMPROVEMENTS**

**STORM SEWER AND STREET IMPROVEMENTS**  
**CROSS SECTIONS - SOUTH TYLER STREET**  
 SAP 71-613-08, SP 204-020-03, SP 204-133-01, SP 204-132-03  
 0+020 TO 0+080

SHEET NO.  
**C1-1X**