
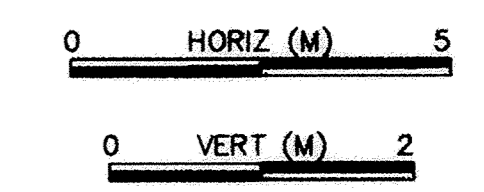
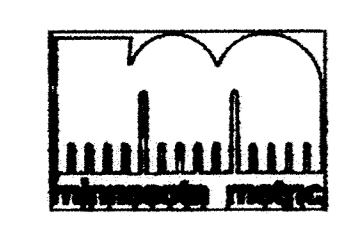
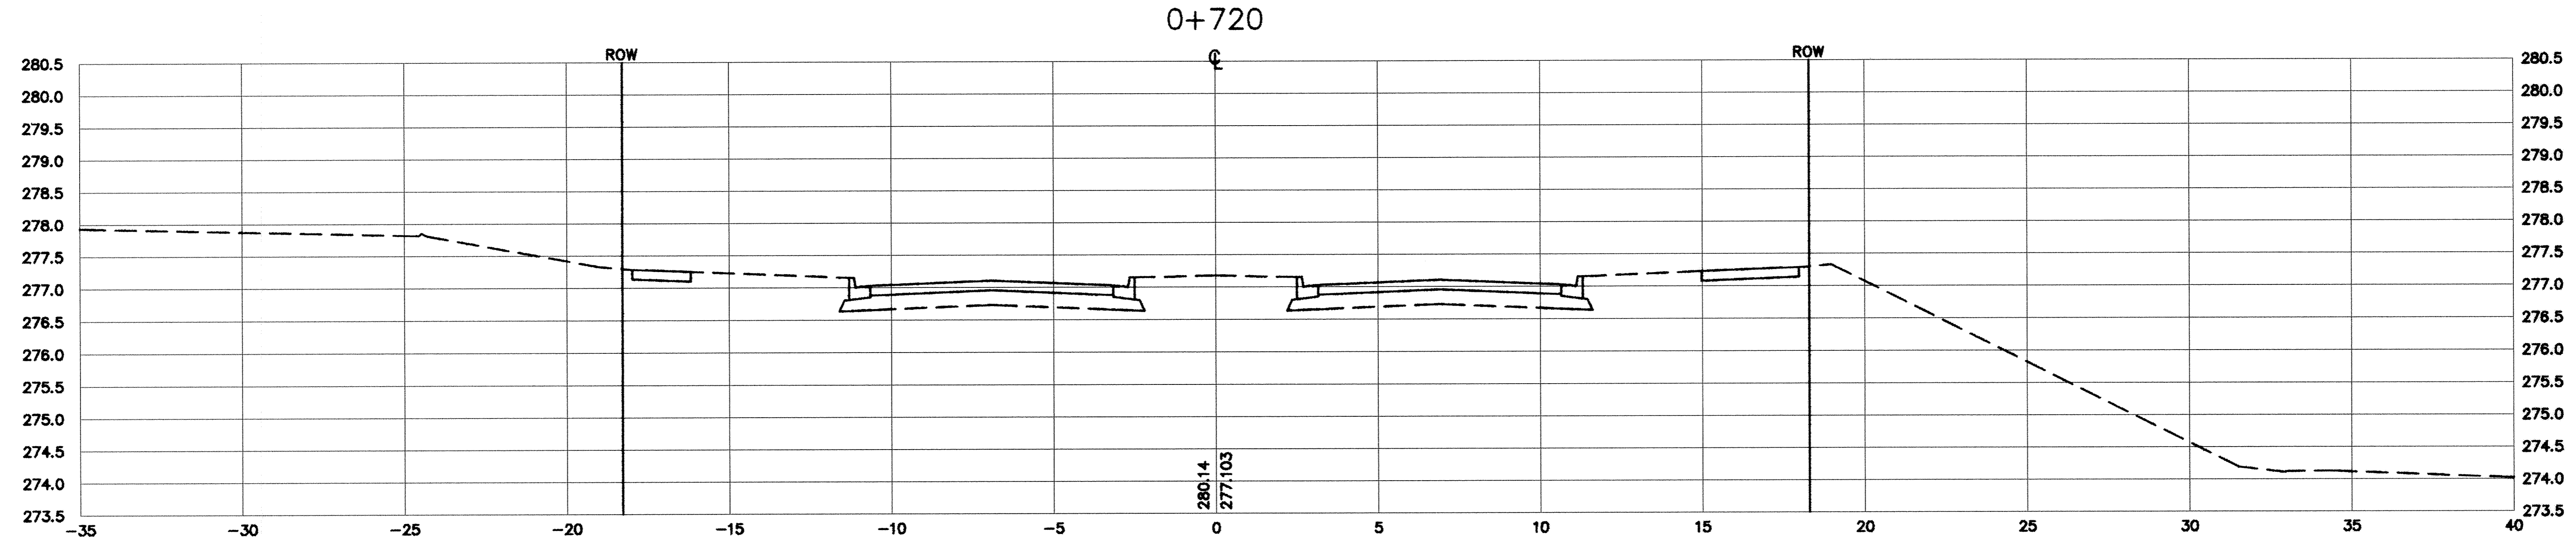


SDCO PRODUCTS • NEW HOPE, MINNESOTA
REGISTERED BY PART NUMBER 8582

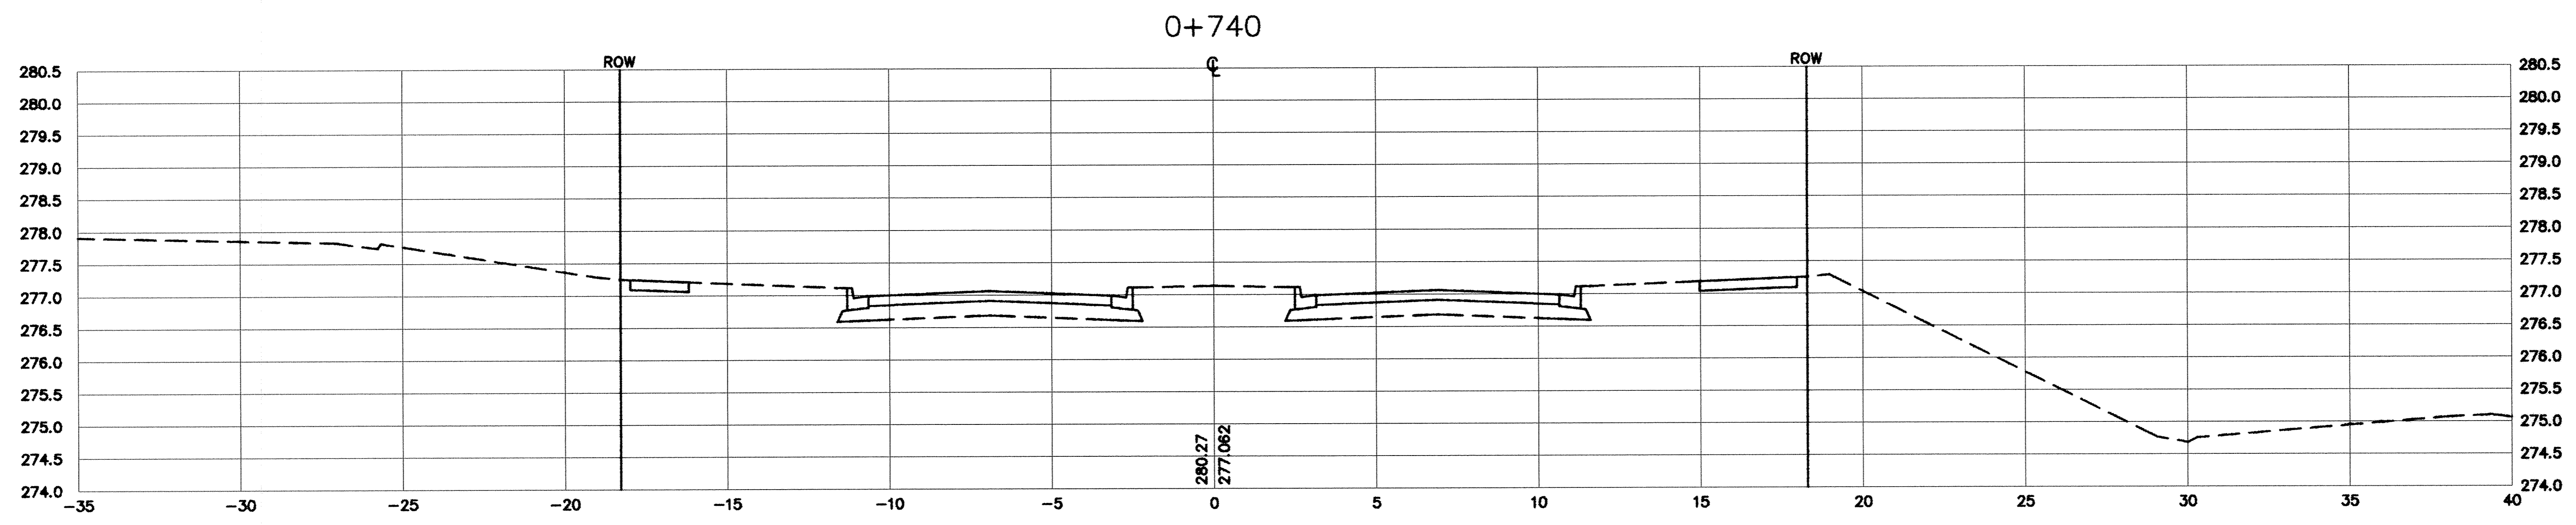

DESIGNED BY: AB DRAWN BY: *AGL*
 APPROVED: --- JOB NUMBER 800110J
 CAD DATE: January 06, 2003 8:45:54 a.m.
 CAD FILE: 800110T\Asbuilts\N_SEGMENT\X13.DWG (JLALLEN)

I HEREBY CERTIFY THAT THIS PLAN, SPECIFICATION,
 OR REPORT WAS PREPARED BY ME OR UNDER MY DIRECT
 SUPERVISION AND THAT I AM A DULY REGISTERED
 PROFESSIONAL ENGINEER UNDER THE LAWS OF THE
 STATE OF MINNESOTA.
 DATE _____ REG. NO. 15316

NO.	DATE	BY	REVISION DESCRIPTION

1326 ENERGY PARK DRIVE
 ST. PAUL, MINNESOTA 55108
 (612) 644-4389
Howard R. Green Company
 CONSULTING ENGINEERS

CITY OF ELK RIVER
EASTERN AREA
TYLER STREET IMPROVEMENTS

STREET AND STORM SEWER IMPROVEMENTS
CROSS SECTIONS - NORTH TYLER STREET
 SAP 71-613-08, SP 204-020-03, SP 204-133-01, SP 204-132-03
 0+720 TO 0+740

SHEET NO.
C1-45X