
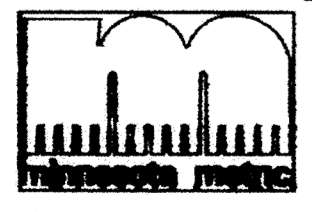
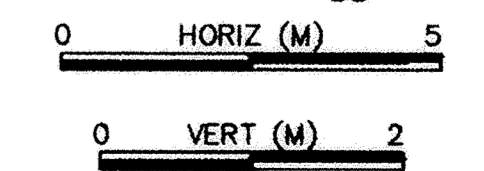
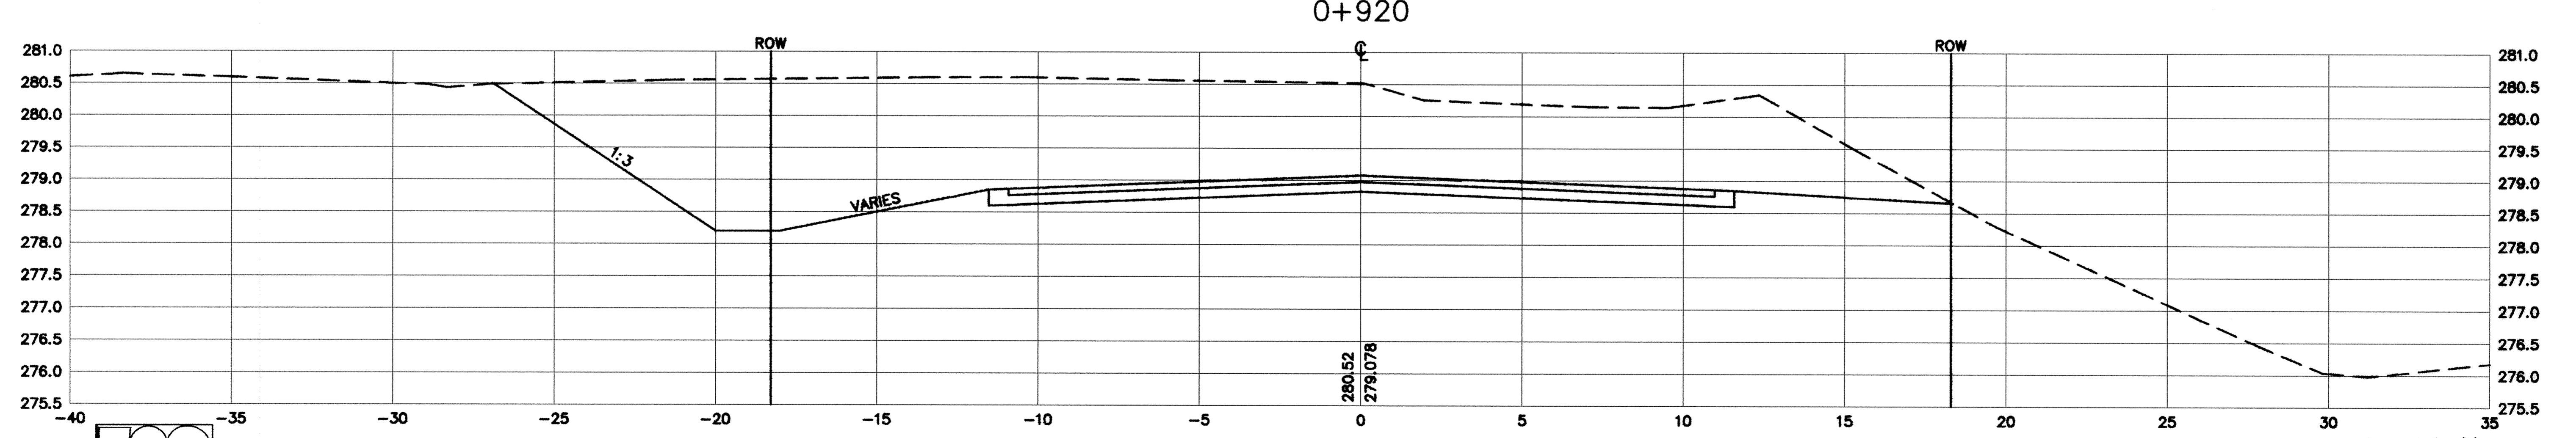
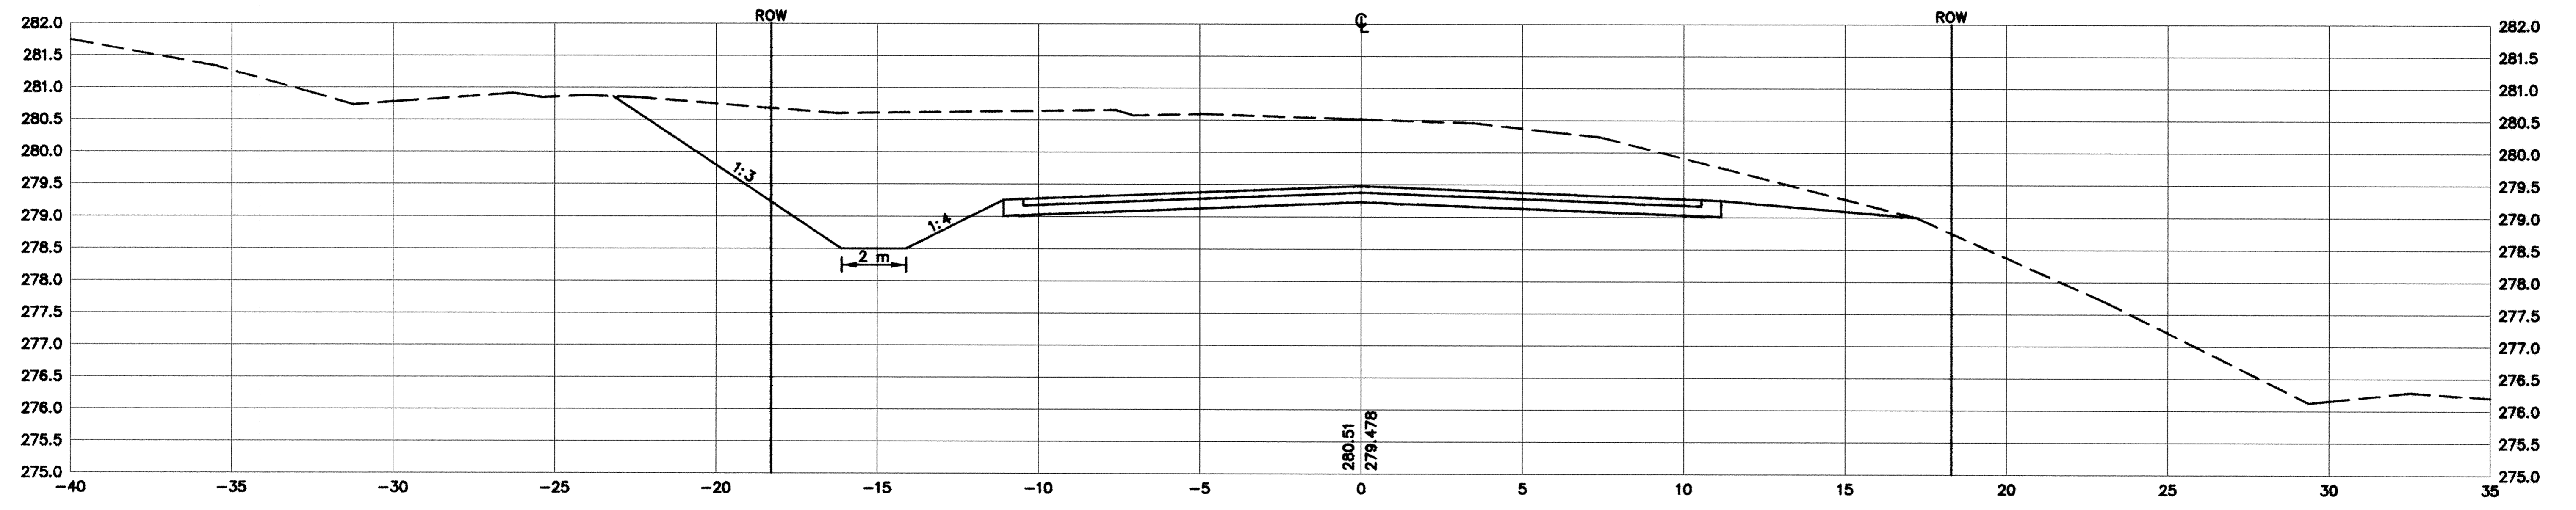


SAECO PRODUCTS • NEW HOPK, MINNESOTA  
REORDER BY PART NUMBER 8532  
SAECO PRODUCTS • NEW HOPK, MINNESOTA  
REORDER BY PART NUMBER 8532  
SAECO PRODUCTS • NEW HOPK, MINNESOTA  
REORDER BY PART NUMBER 8532  
SAECO PRODUCTS • NEW HOPK, MINNESOTA  
REORDER BY PART NUMBER 8532

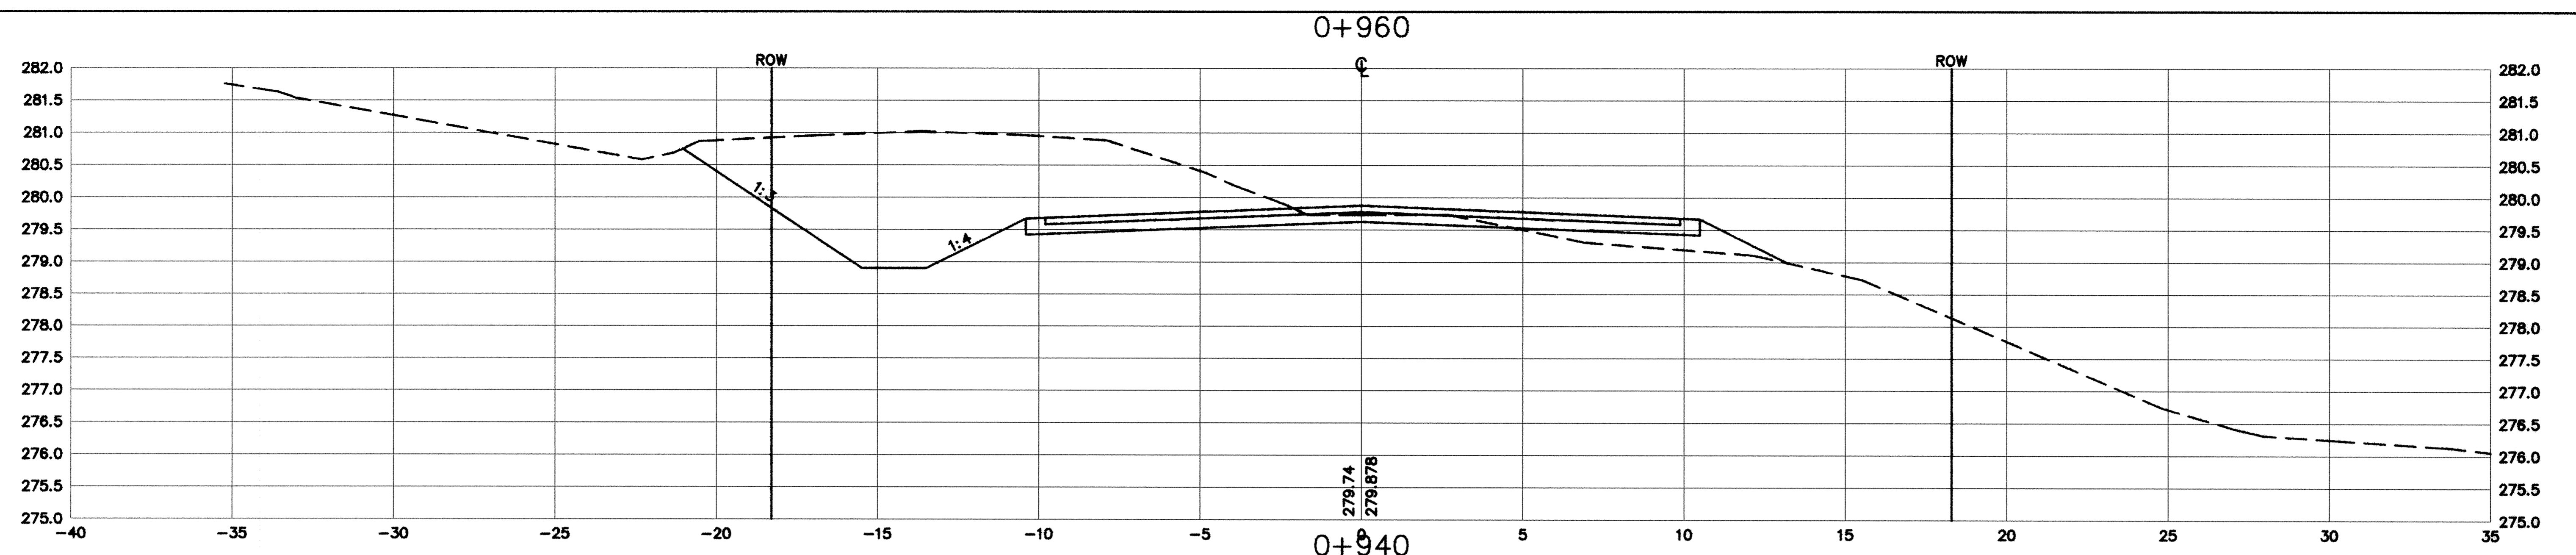

DESIGNED BY: AB DRAWN BY: *gjl*  
 APPROVED: --- JOB NUMBER 800110J  
 CAD DATE: January 06, 2003 8:52:12 a.m.  
 CAD FILE: 800110T\Asbuitts\N SEGMENT\X16.DWG (JLLEN)

I HEREBY CERTIFY THAT THIS PLAN, SPECIFICATION, OR REPORT WAS PREPARED BY ME OR UNDER MY DIRECT SUPERVISION AND THAT I AM A DULY REGISTERED PROFESSIONAL ENGINEER UNDER THE LAWS OF THE STATE OF MINNESOTA.  
 DATE \_\_\_\_\_ REG. NO. 15318

NO.	DATE	BY	REVISION DESCRIPTION



1326 ENERGY PARK DRIVE  
 ST. PAUL, MINNESOTA 55108  
 (651) 644-4389  
**Howard R. Green Company**  
 CONSULTING ENGINEERS

**CITY OF ELK RIVER**  
**EASTERN AREA**  
**TYLER STREET IMPROVEMENTS**

**STREET AND STORM SEWER IMPROVEMENTS**  
**CROSS SECTIONS - NORTH TYLER STREET**  
 SP 71-613-08, SP 204-020-03, SP 204-133-01, SP 204-132-03  
 0+920 TO 0+960

SHEET NO.  
**C1-48X**