
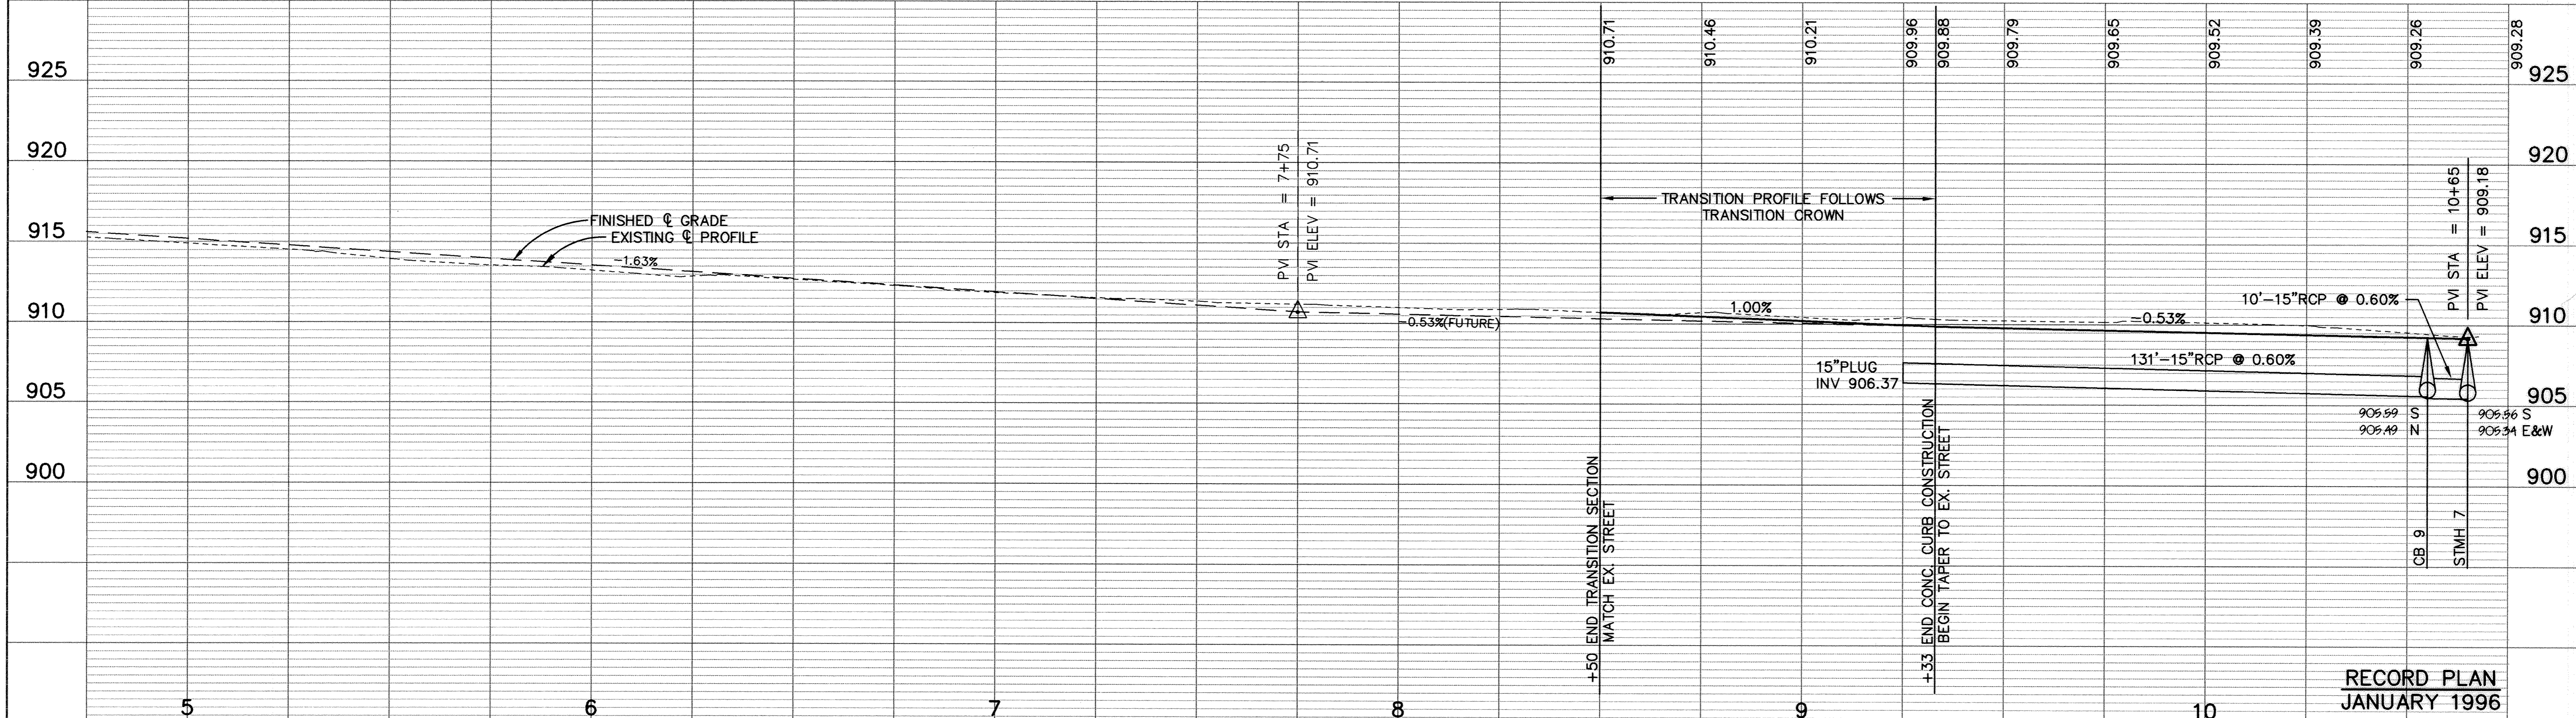


DODGE AVENUE

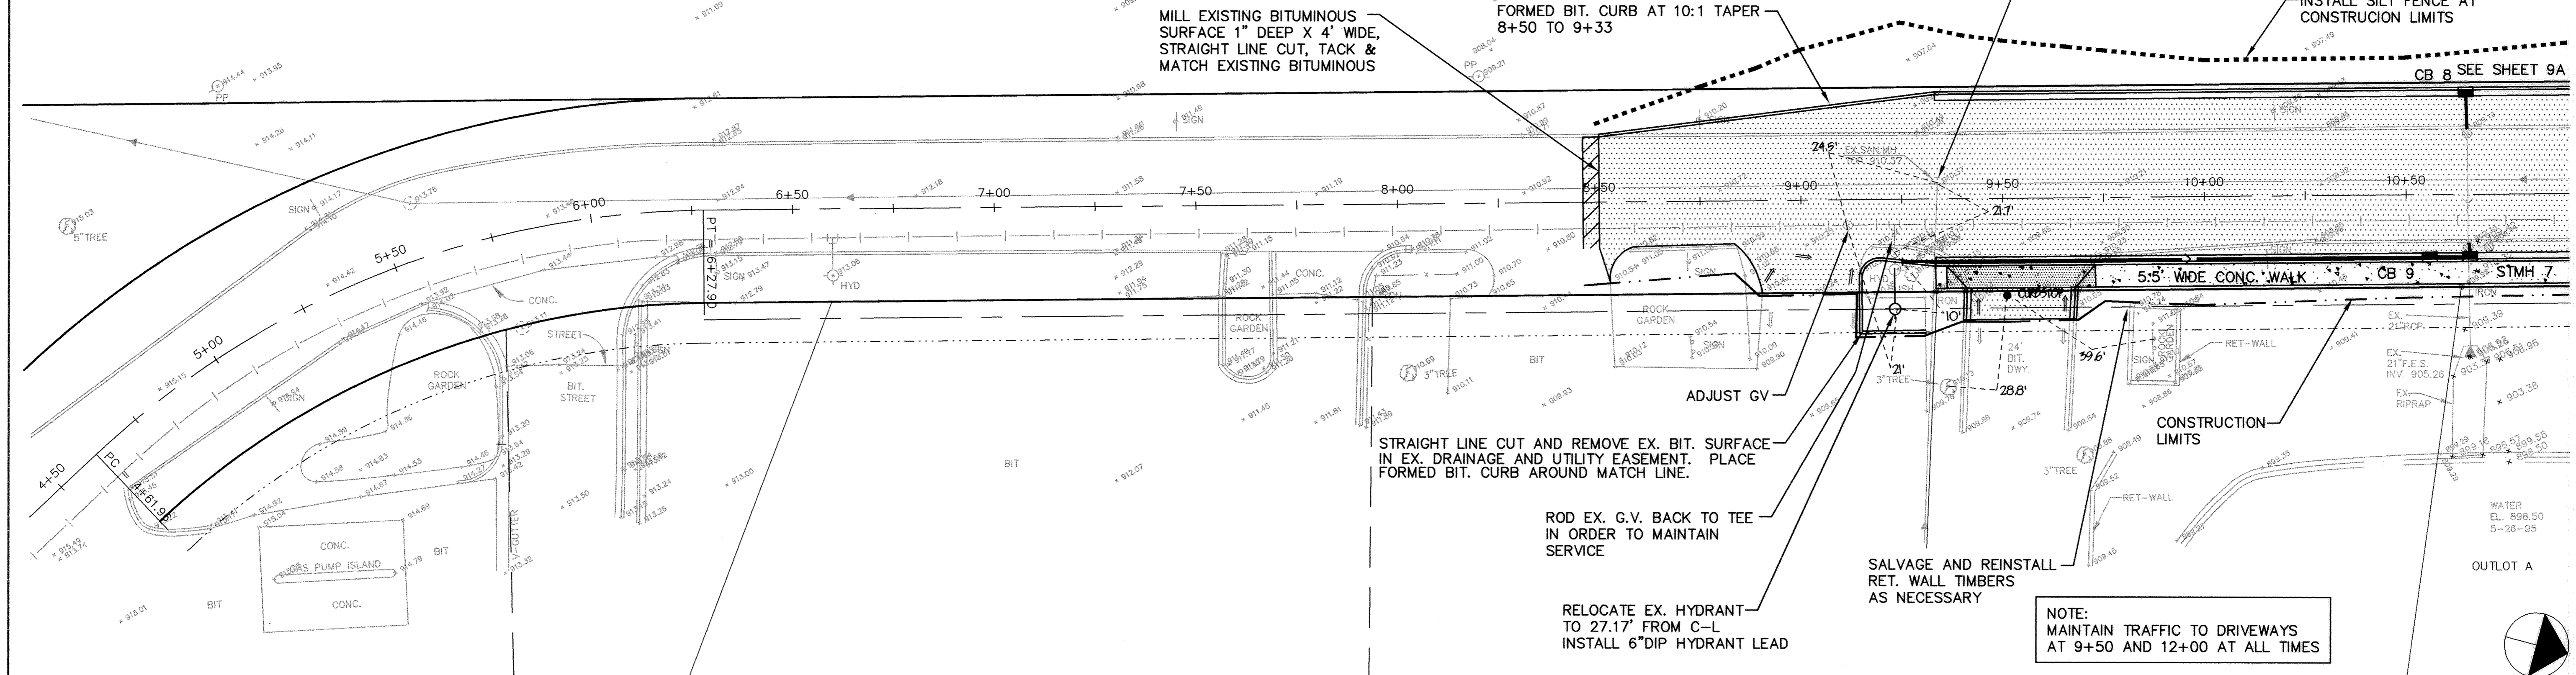

DATE	DESCRIPTION	DESIGNED	CHECKED	DRAWN

I HEREBY CERTIFY THAT THIS PLAN, SPECIFICATION, OR REPORT WAS PREPARED BY ME OR UNDER MY DIRECT SUPERVISION AND THAT I AM A DULY REGISTERED PROFESSIONAL ENGINEER UNDER THE LAWS OF THE STATE OF MINNESOTA. DATE <u>7/31/95</u> REG. NO. <u>2408Z</u> 	1326 ENERGY PARK DRIVE ST. PAUL, MINNESOTA 55108 (612) 644-4389 5075 WAYZATA BLVD. SUITE #225 MINNEAPOLIS, MINNESOTA 55416 (612) 546-0432	CITY OF ELK RIVER ELK HILLS DRIVE STORM SEWER AND STREETS DODGE AVENUE CHANGE ORDER NO. 2 DATE SEPT 1995 SHEET 9B OF 22 SHEETS PROJECT NO. 230-246
--	--	---

DRAWING NUMBER
 ELKH. 95
 9B
 DRAWING NUMBER
 ELKH. 95
 9B
 DRAWING NUMBER
 ELKH. 95
 9B